


1412

1412-1

+SS

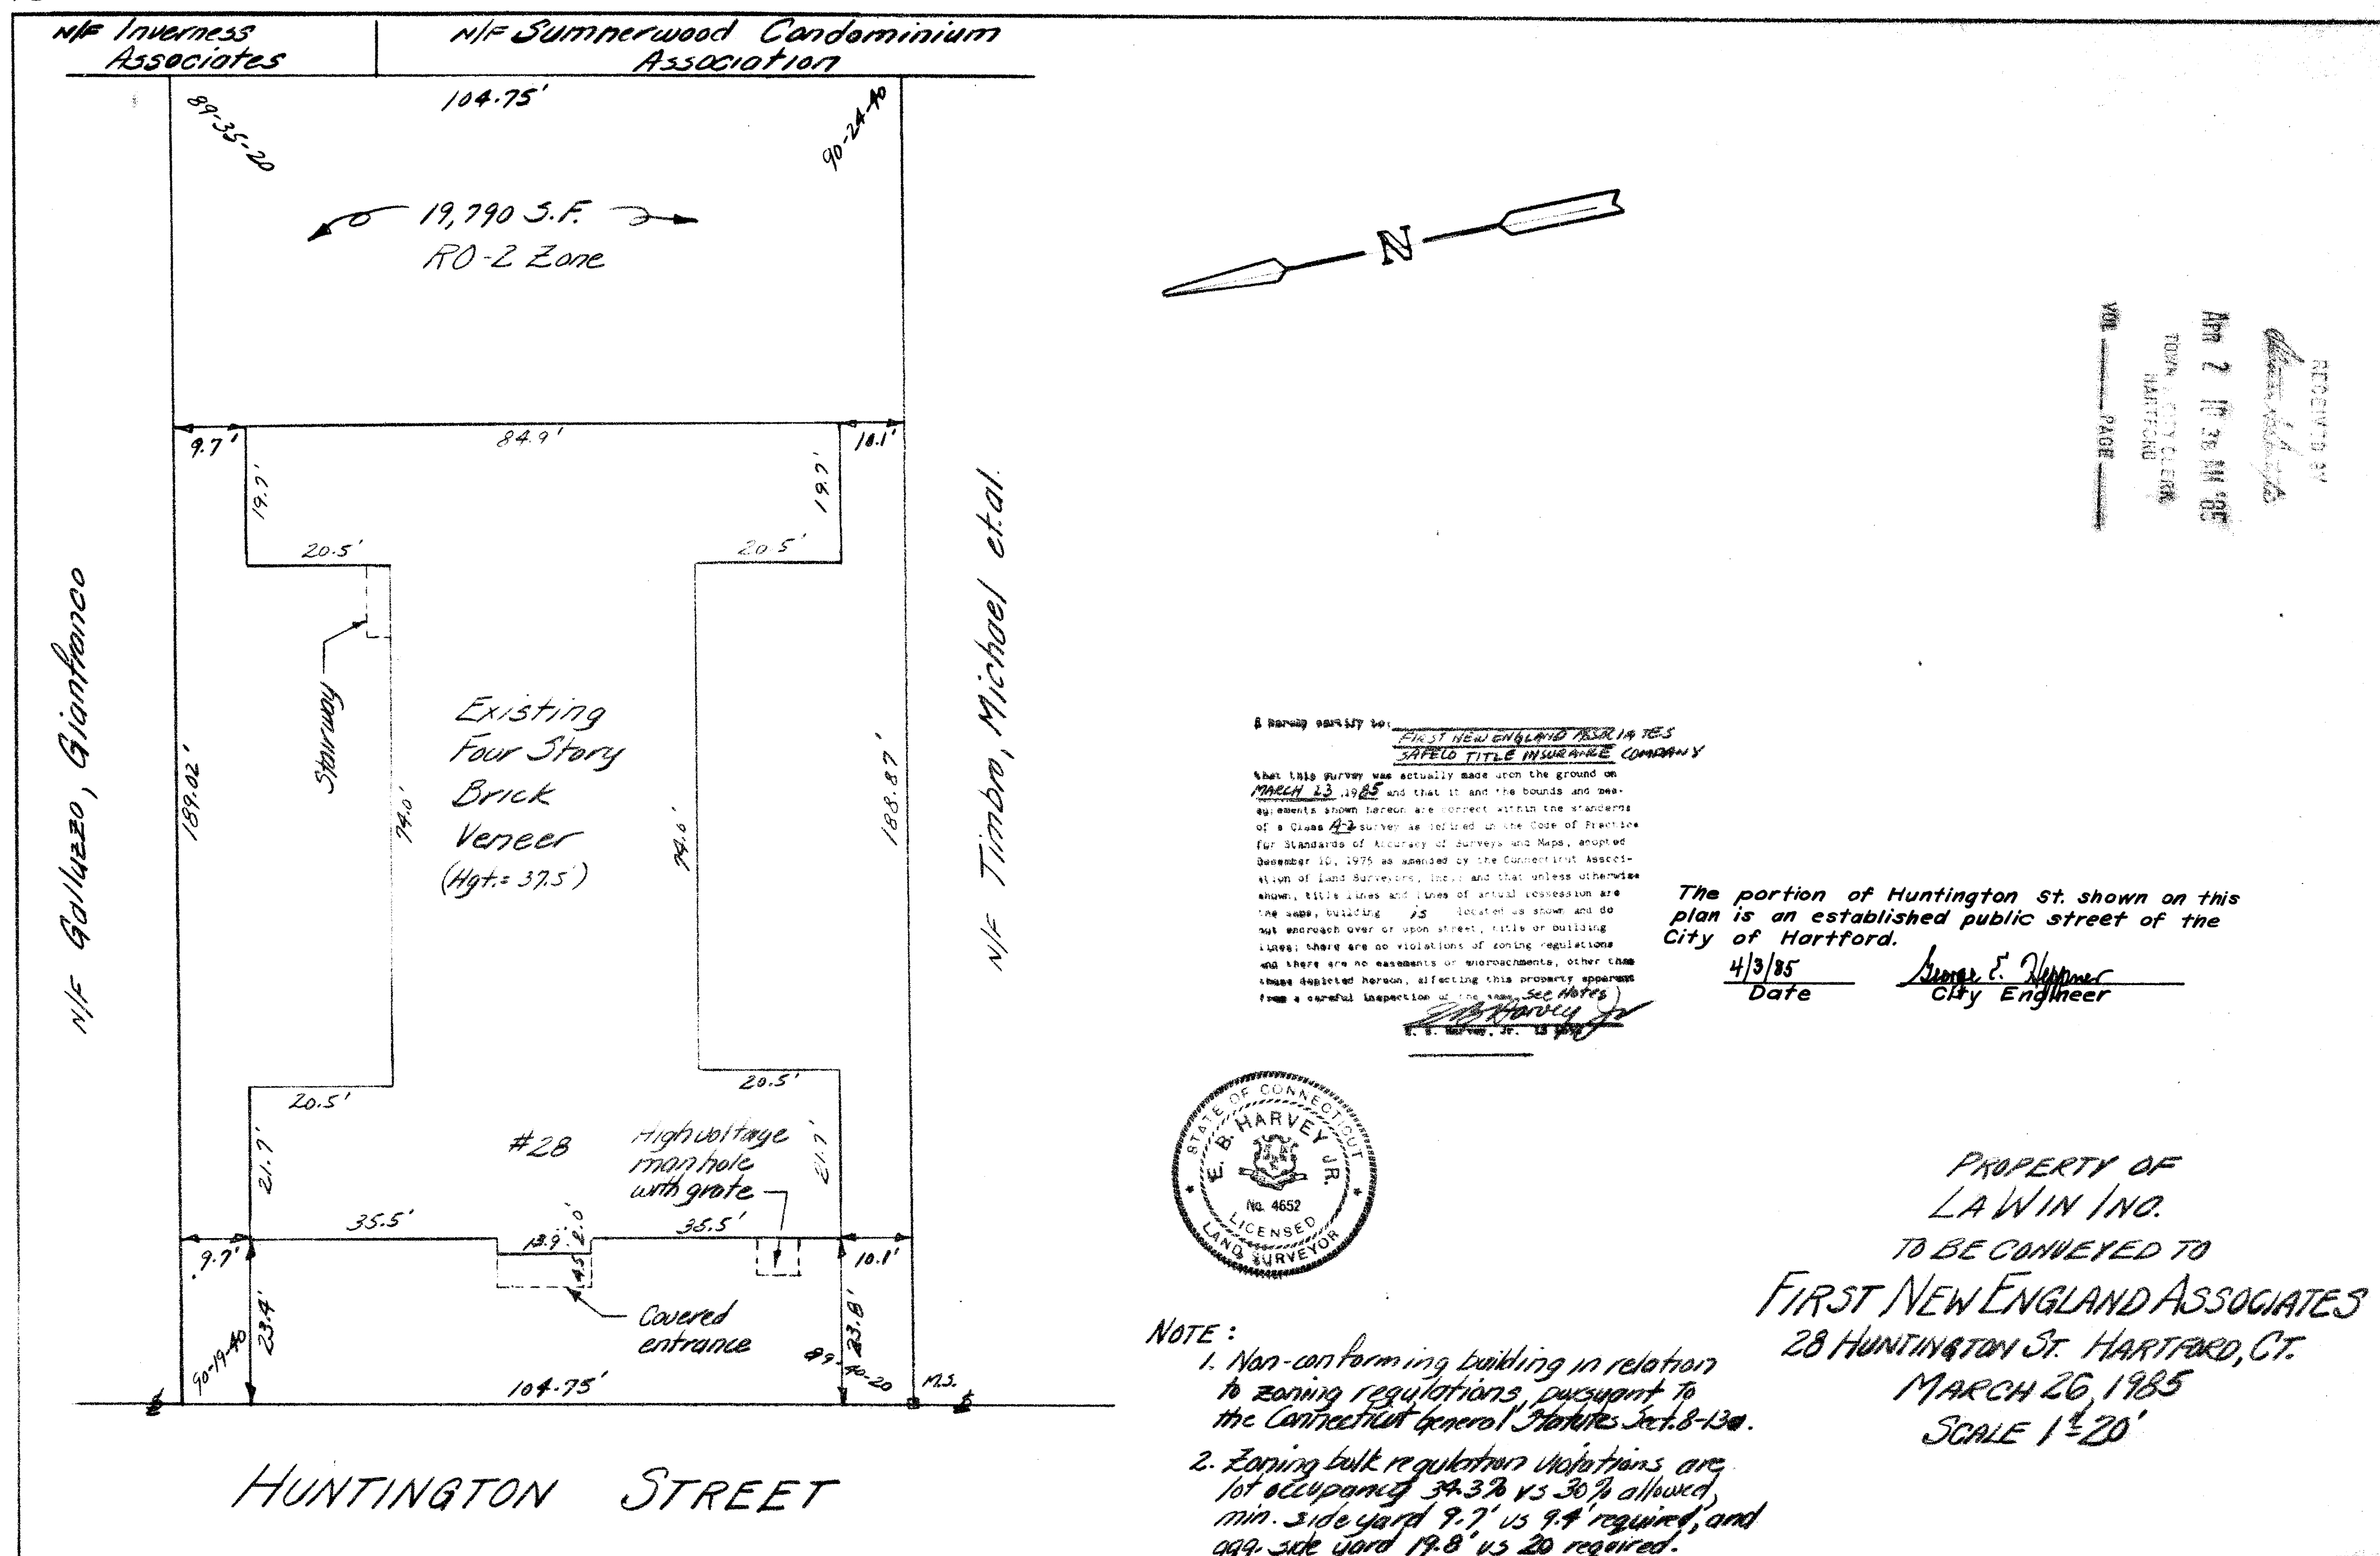

1412-1

0 INCHES 1 2 3 4