


1426


1426-2

525

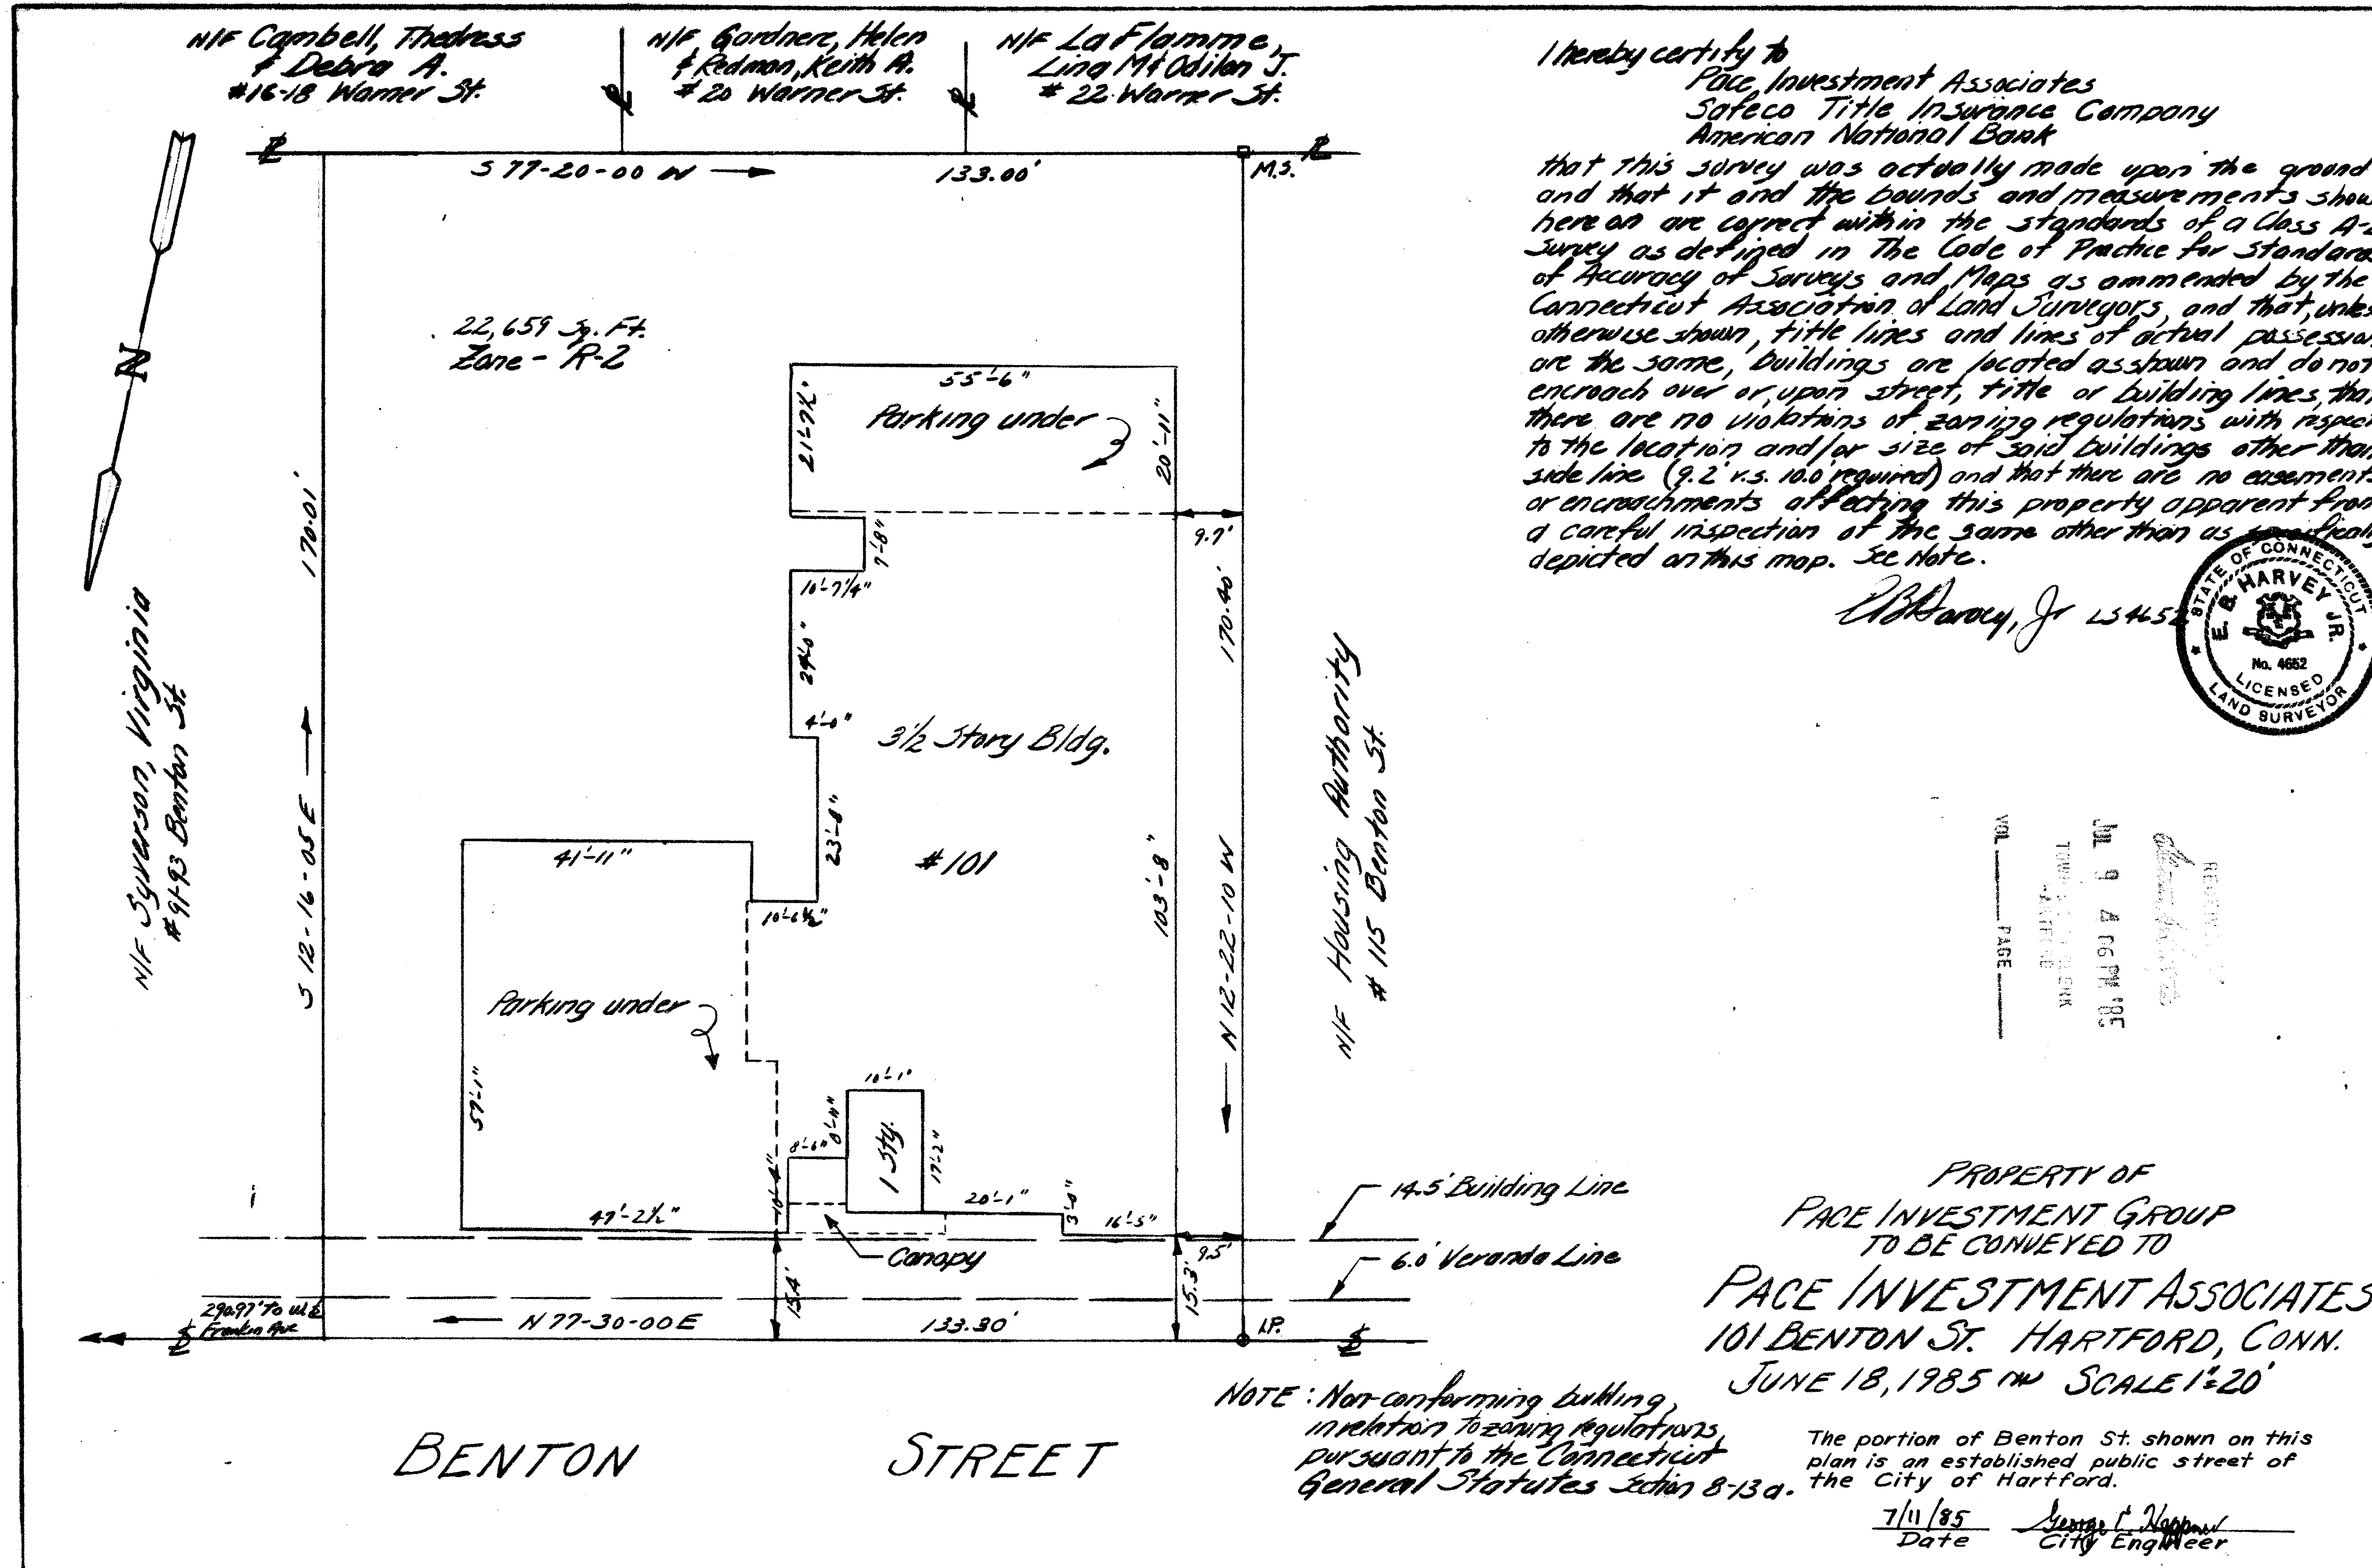

I hereby certify to
Safeo Title Insurance Company
American National Bank
that this survey was actually made upon the ground
and that it and the bounds and measurements shown
hereon are correct within the standards of a Class A-2
survey as defined in The Code of Practice for Standards
of Accuracy of Surveys and Maps as amended by the
Connecticut Association of Land Surveyors, and that, unless
otherwise shown, title lines and lines of actual possession
are the same, buildings are located as shown and do not
encroach over or upon street, title or building lines, that
there are no violations of zoning regulations with respect
to the location and/or size of said buildings other than
side line (9.2 v.s. 10.0 required) and that there are no encroachments
or encroachments affecting this property apparent from
a careful inspection of the same other than as specifically
depicted on this map. See Note.

Ch. Harvey, Jr. L3465

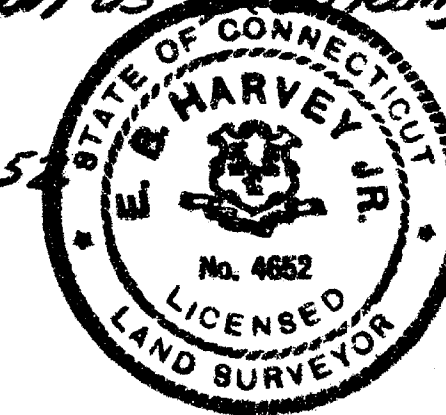

JUN 9 4 06 PM '85
VOL. _____ PAGE _____

PROPERTY OF
101 BENTON ST. HARTFORD, CONN.
JUNE 18, 1985 IN SCALE 1"=20'

The portion of Benton St. shown on this plan is an established public street of the City of Hartford.

7/11/85 George F. Haggard
Date City Engineer

122

1426

523

