



1426

1 4 2 6 - 3

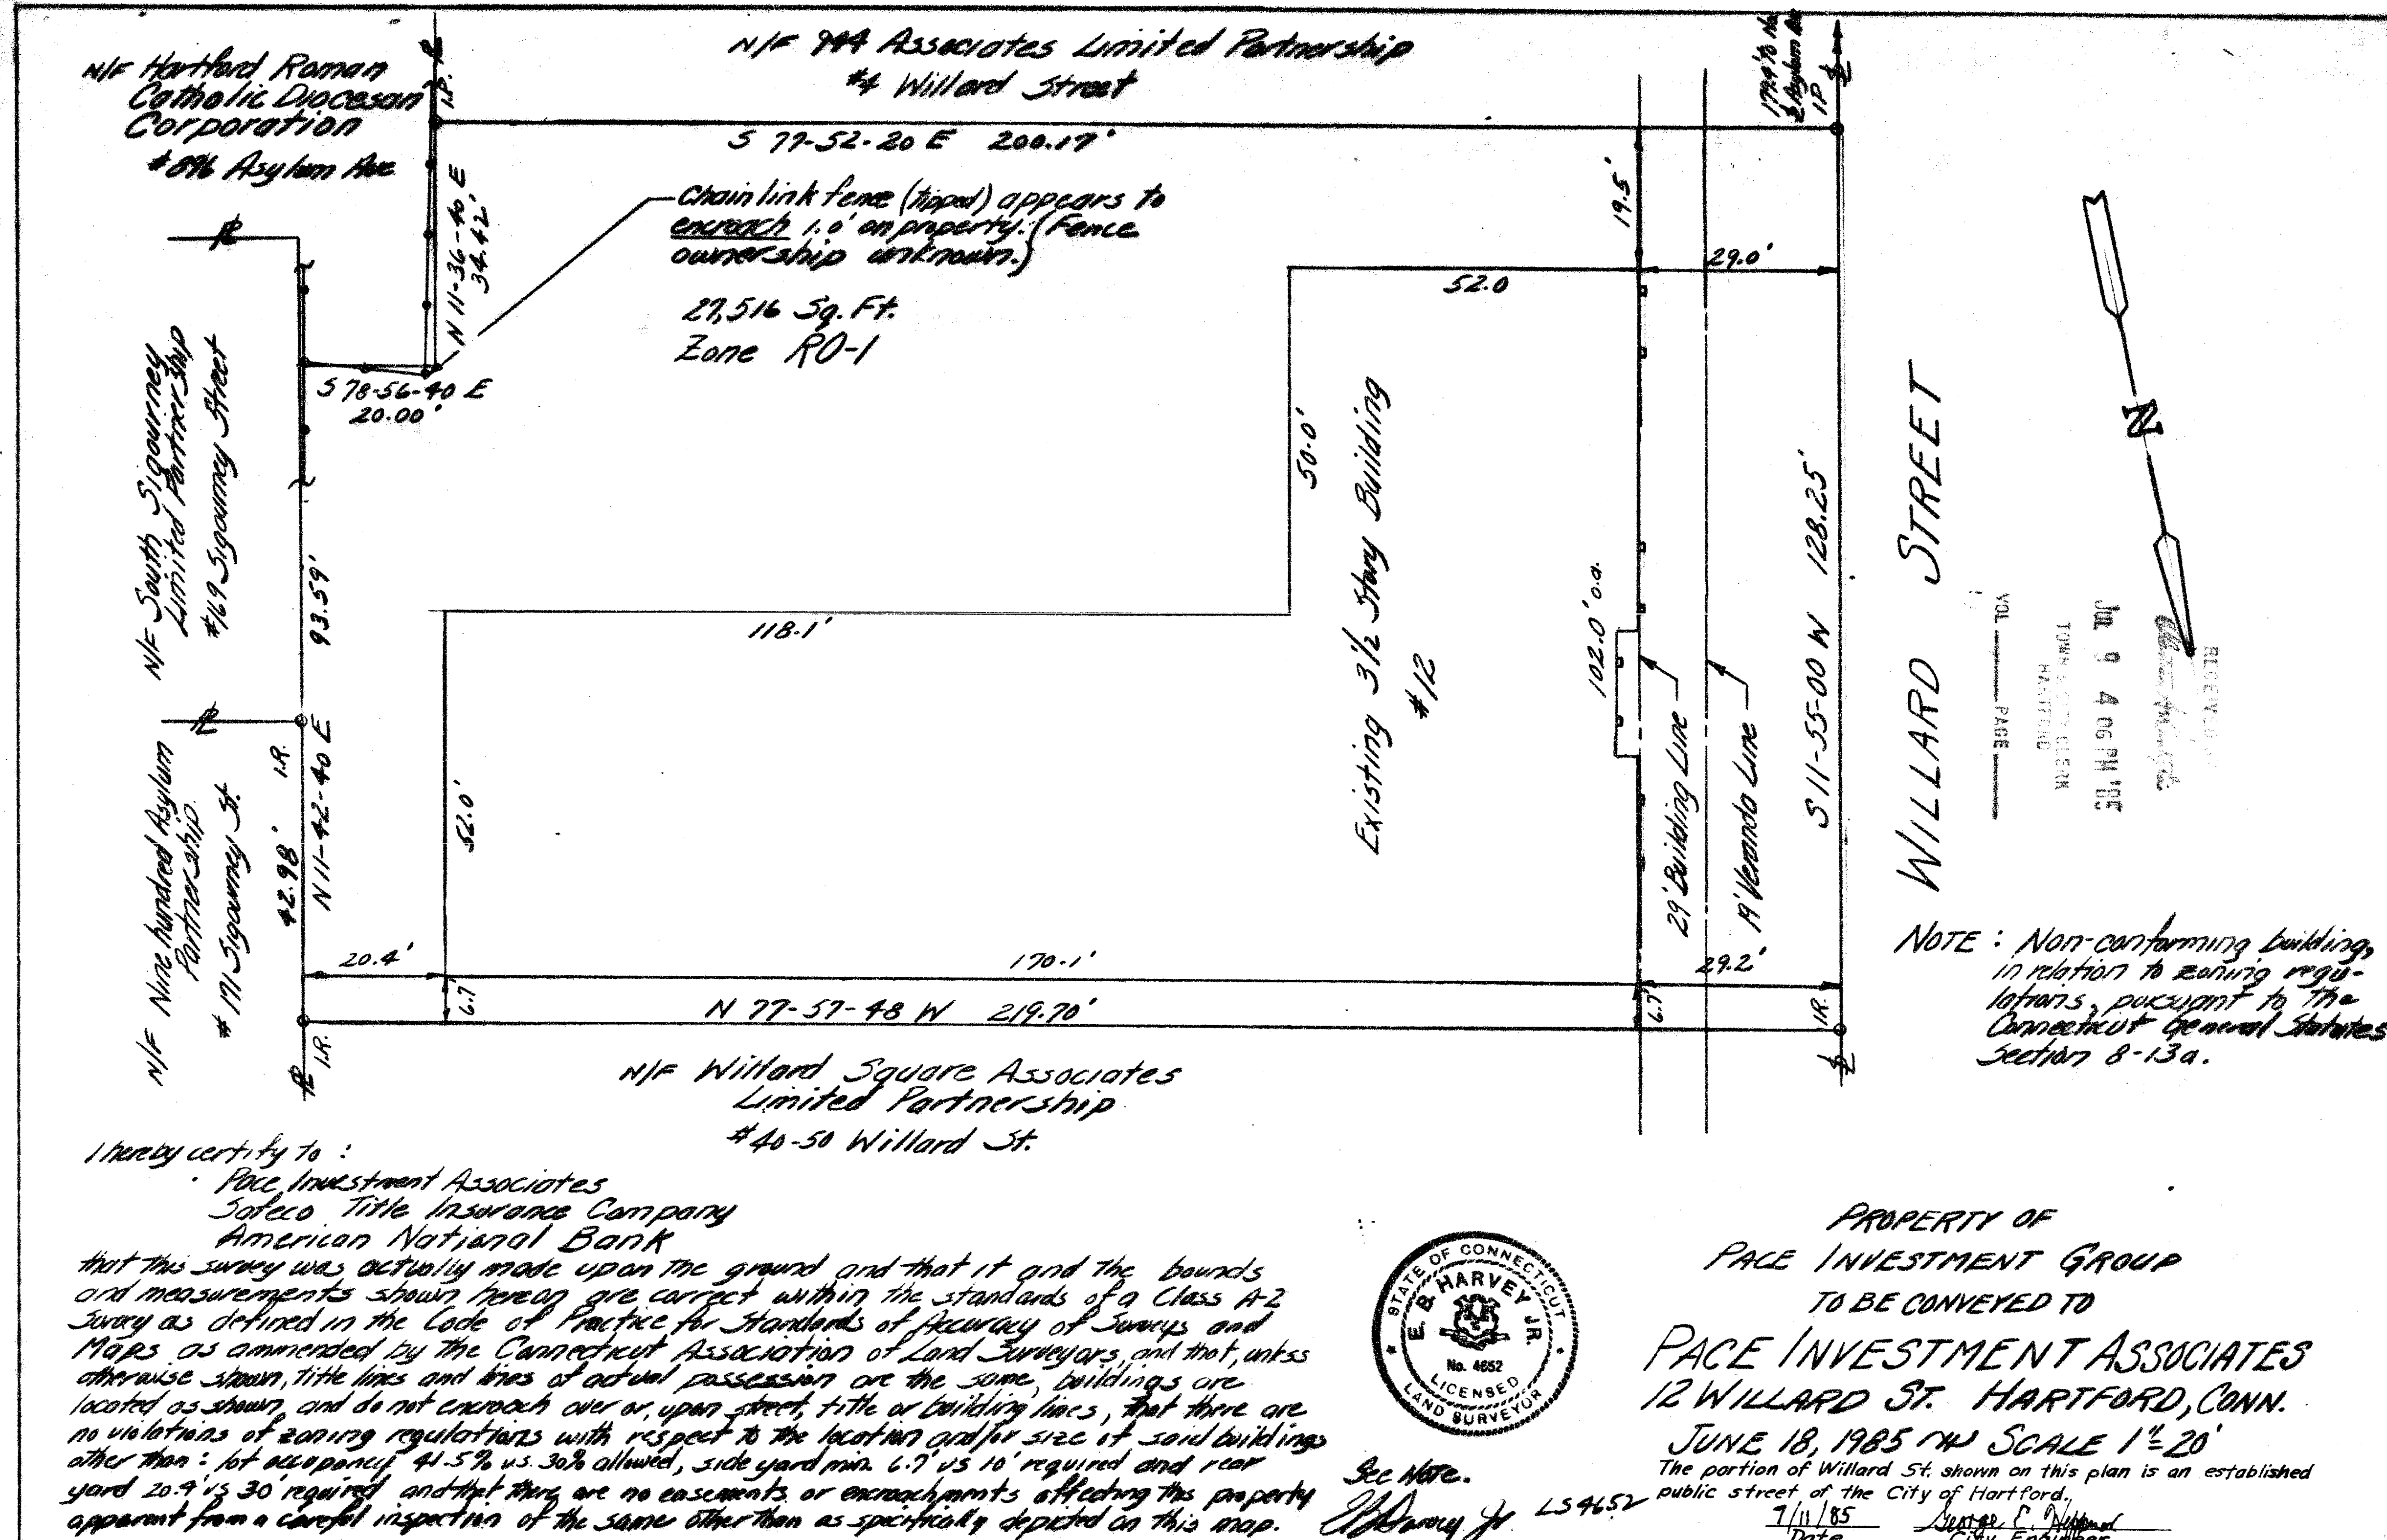

NOTE: Non-conforming buildings,
in relation to zoning regu-
lations, pursuant to the
Connecticut General Statutes
Section 8-13a.

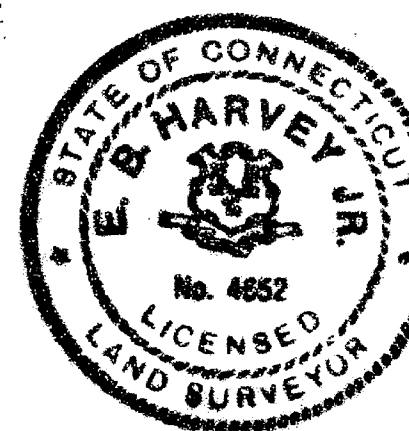

PROPERTY OF
PACE INVESTMENT GROUP
TO BE CONVEYED TO
PACE INVESTMENT ASSOCIATES
12 WILLARD ST. HARTFORD, CONN.

JUNE 18, 1985 WK SCALE 1"=20

The portion of Willard St. shown on this plan is an established public street of the City of Hartford.

7/11/85 George C. [Signature]
Date City Engineer

7/11/85
Date