


1427


RECEIVED BY
John A. Hinkle
JUL 10 8 38 AM '85
TOWN & CITY CLERK
HARTFORD
VOL _____ PAGE _____

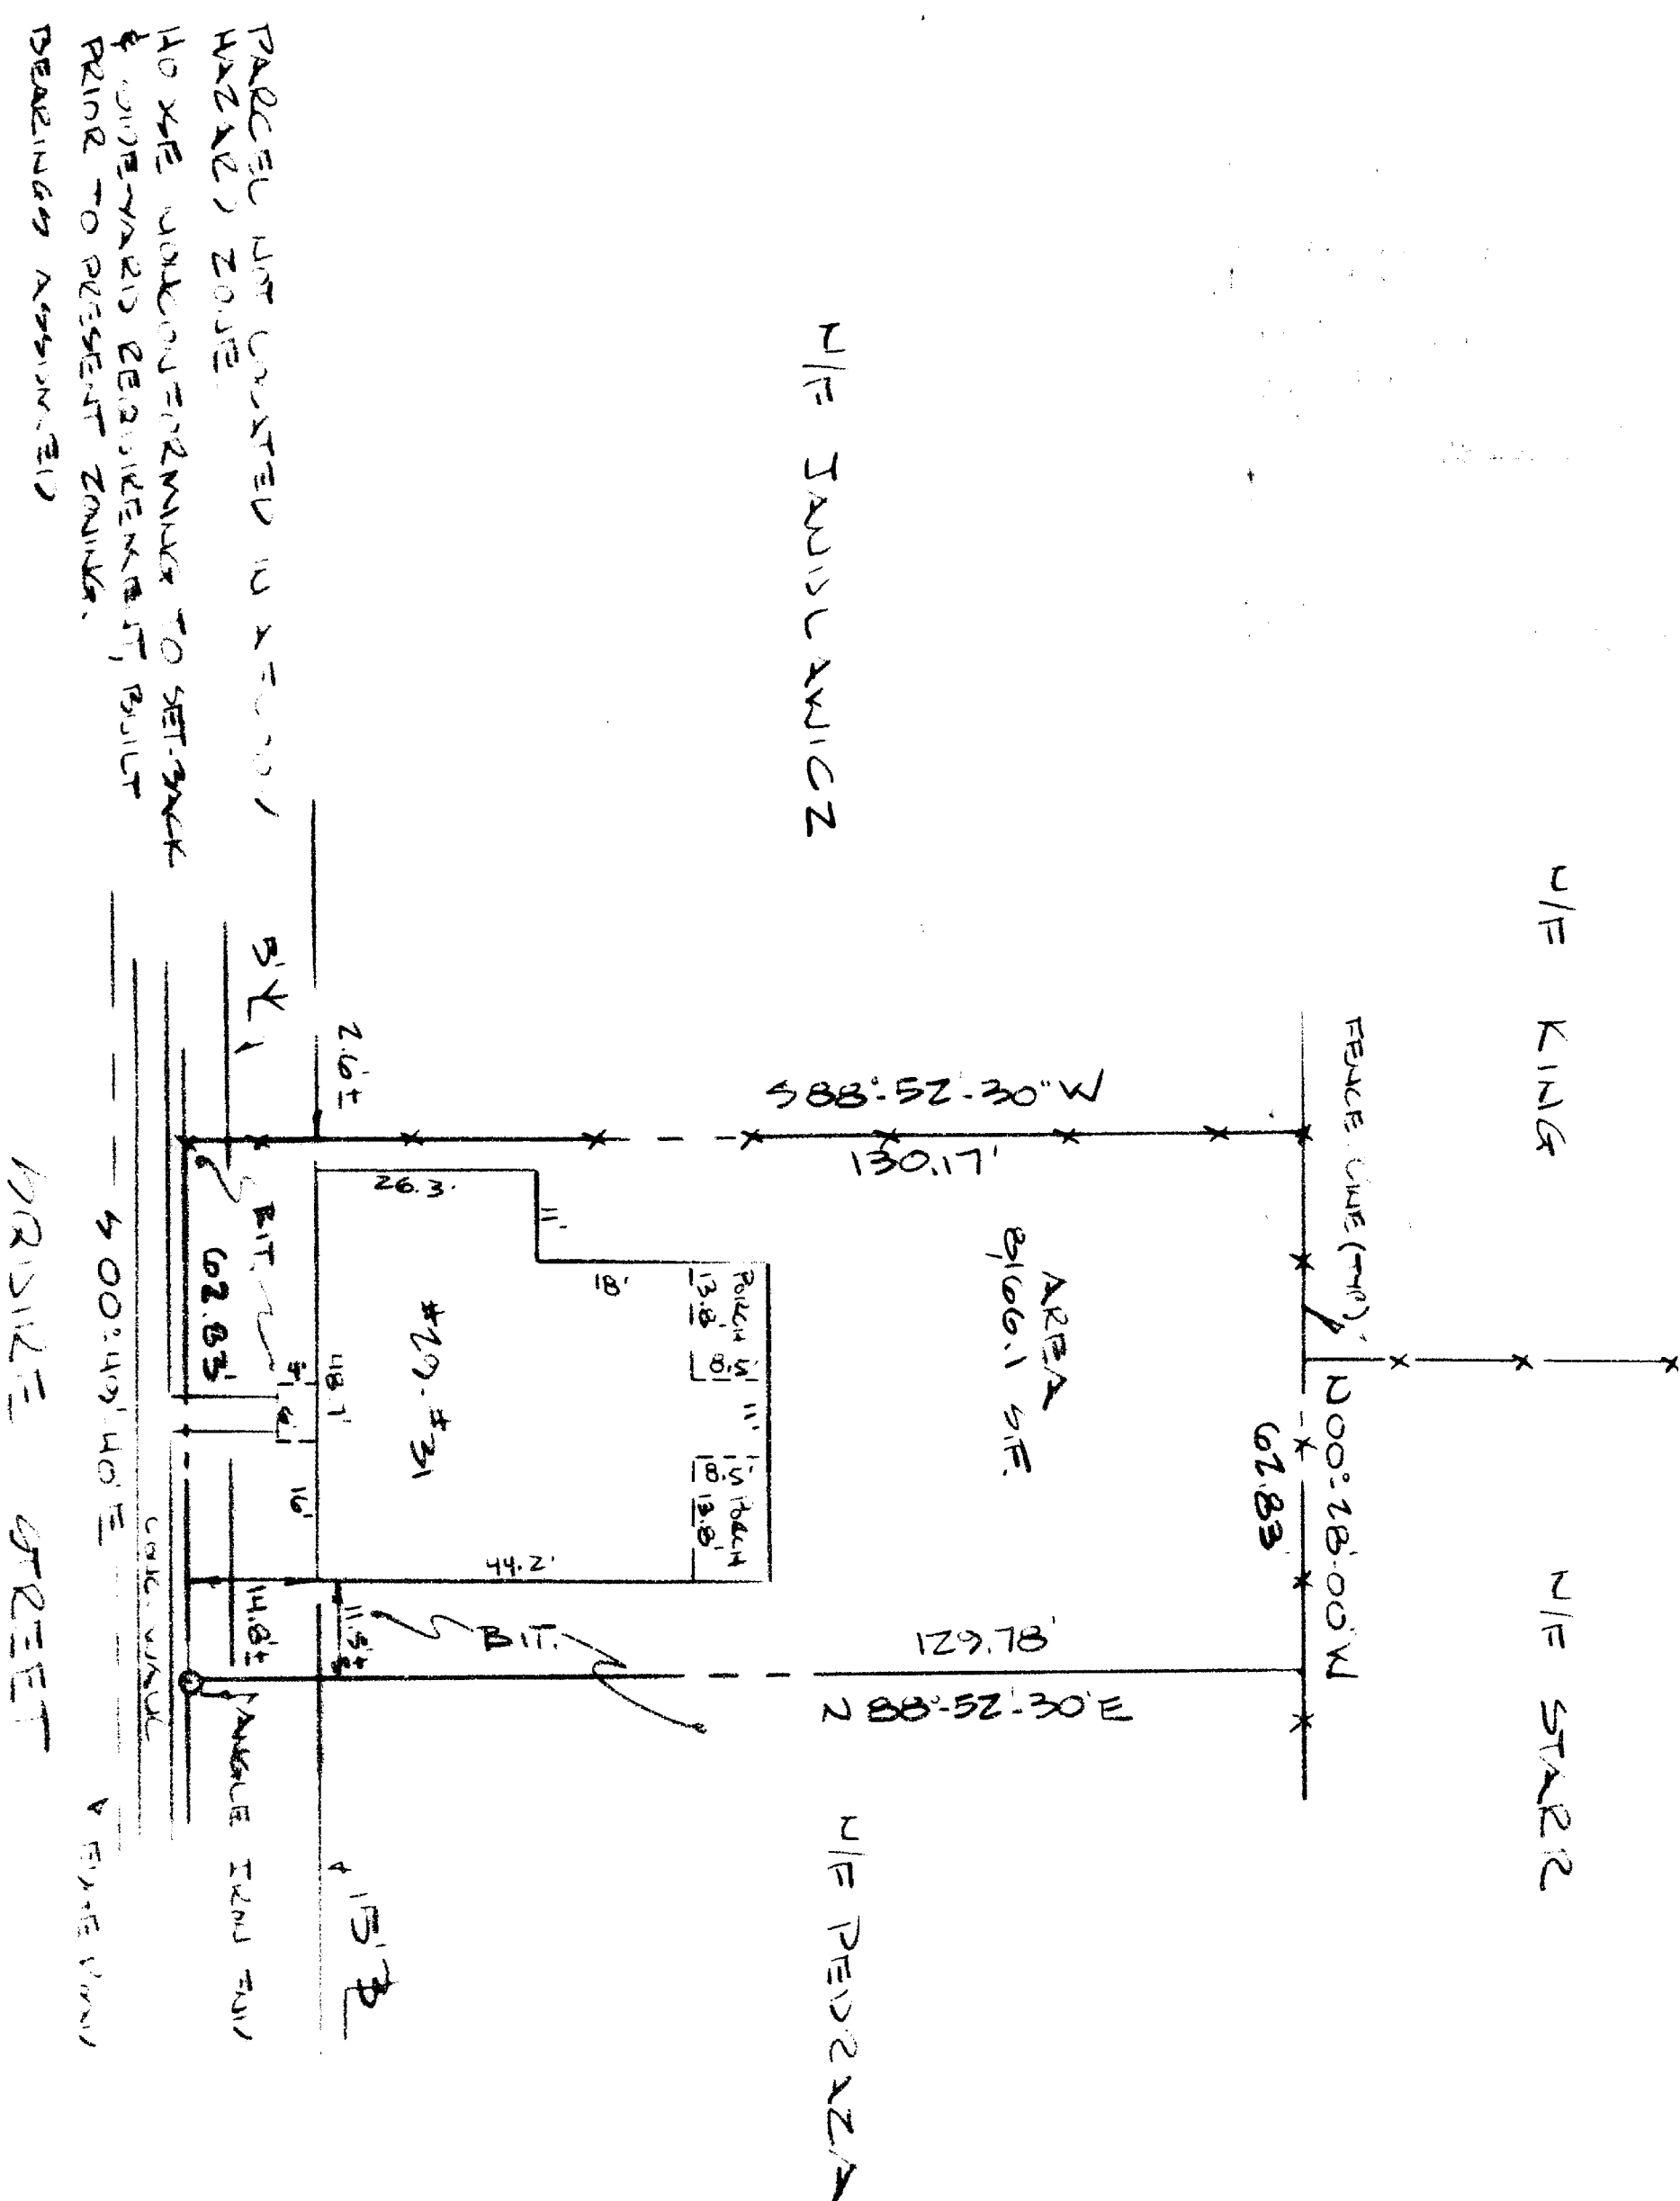

(TO SURVY LOCATED AS SHOWN)


MANUEL N. JANSZWICZ
PROFESSIONAL SURVEYOR
20-31 SQUIRE STREET
HARTFORD, CONNECTICUT

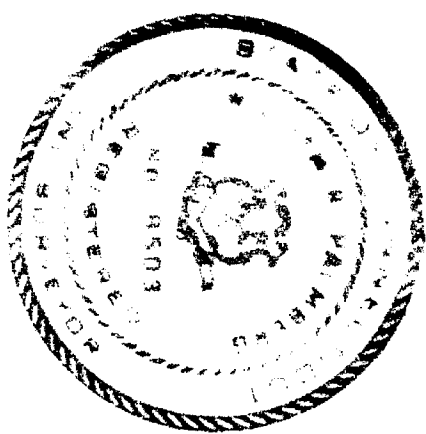

The portion of Squire St. shown on this plan is an established public street of the City of Hartford.

DATE: 7/11/85
BY: *George S. Hinkle*
CITY ENGINEER
DATE: 6-14-85

1427

123

85105

1427

EASI FILE CORP. IRVINE, CA

EFM 34

