
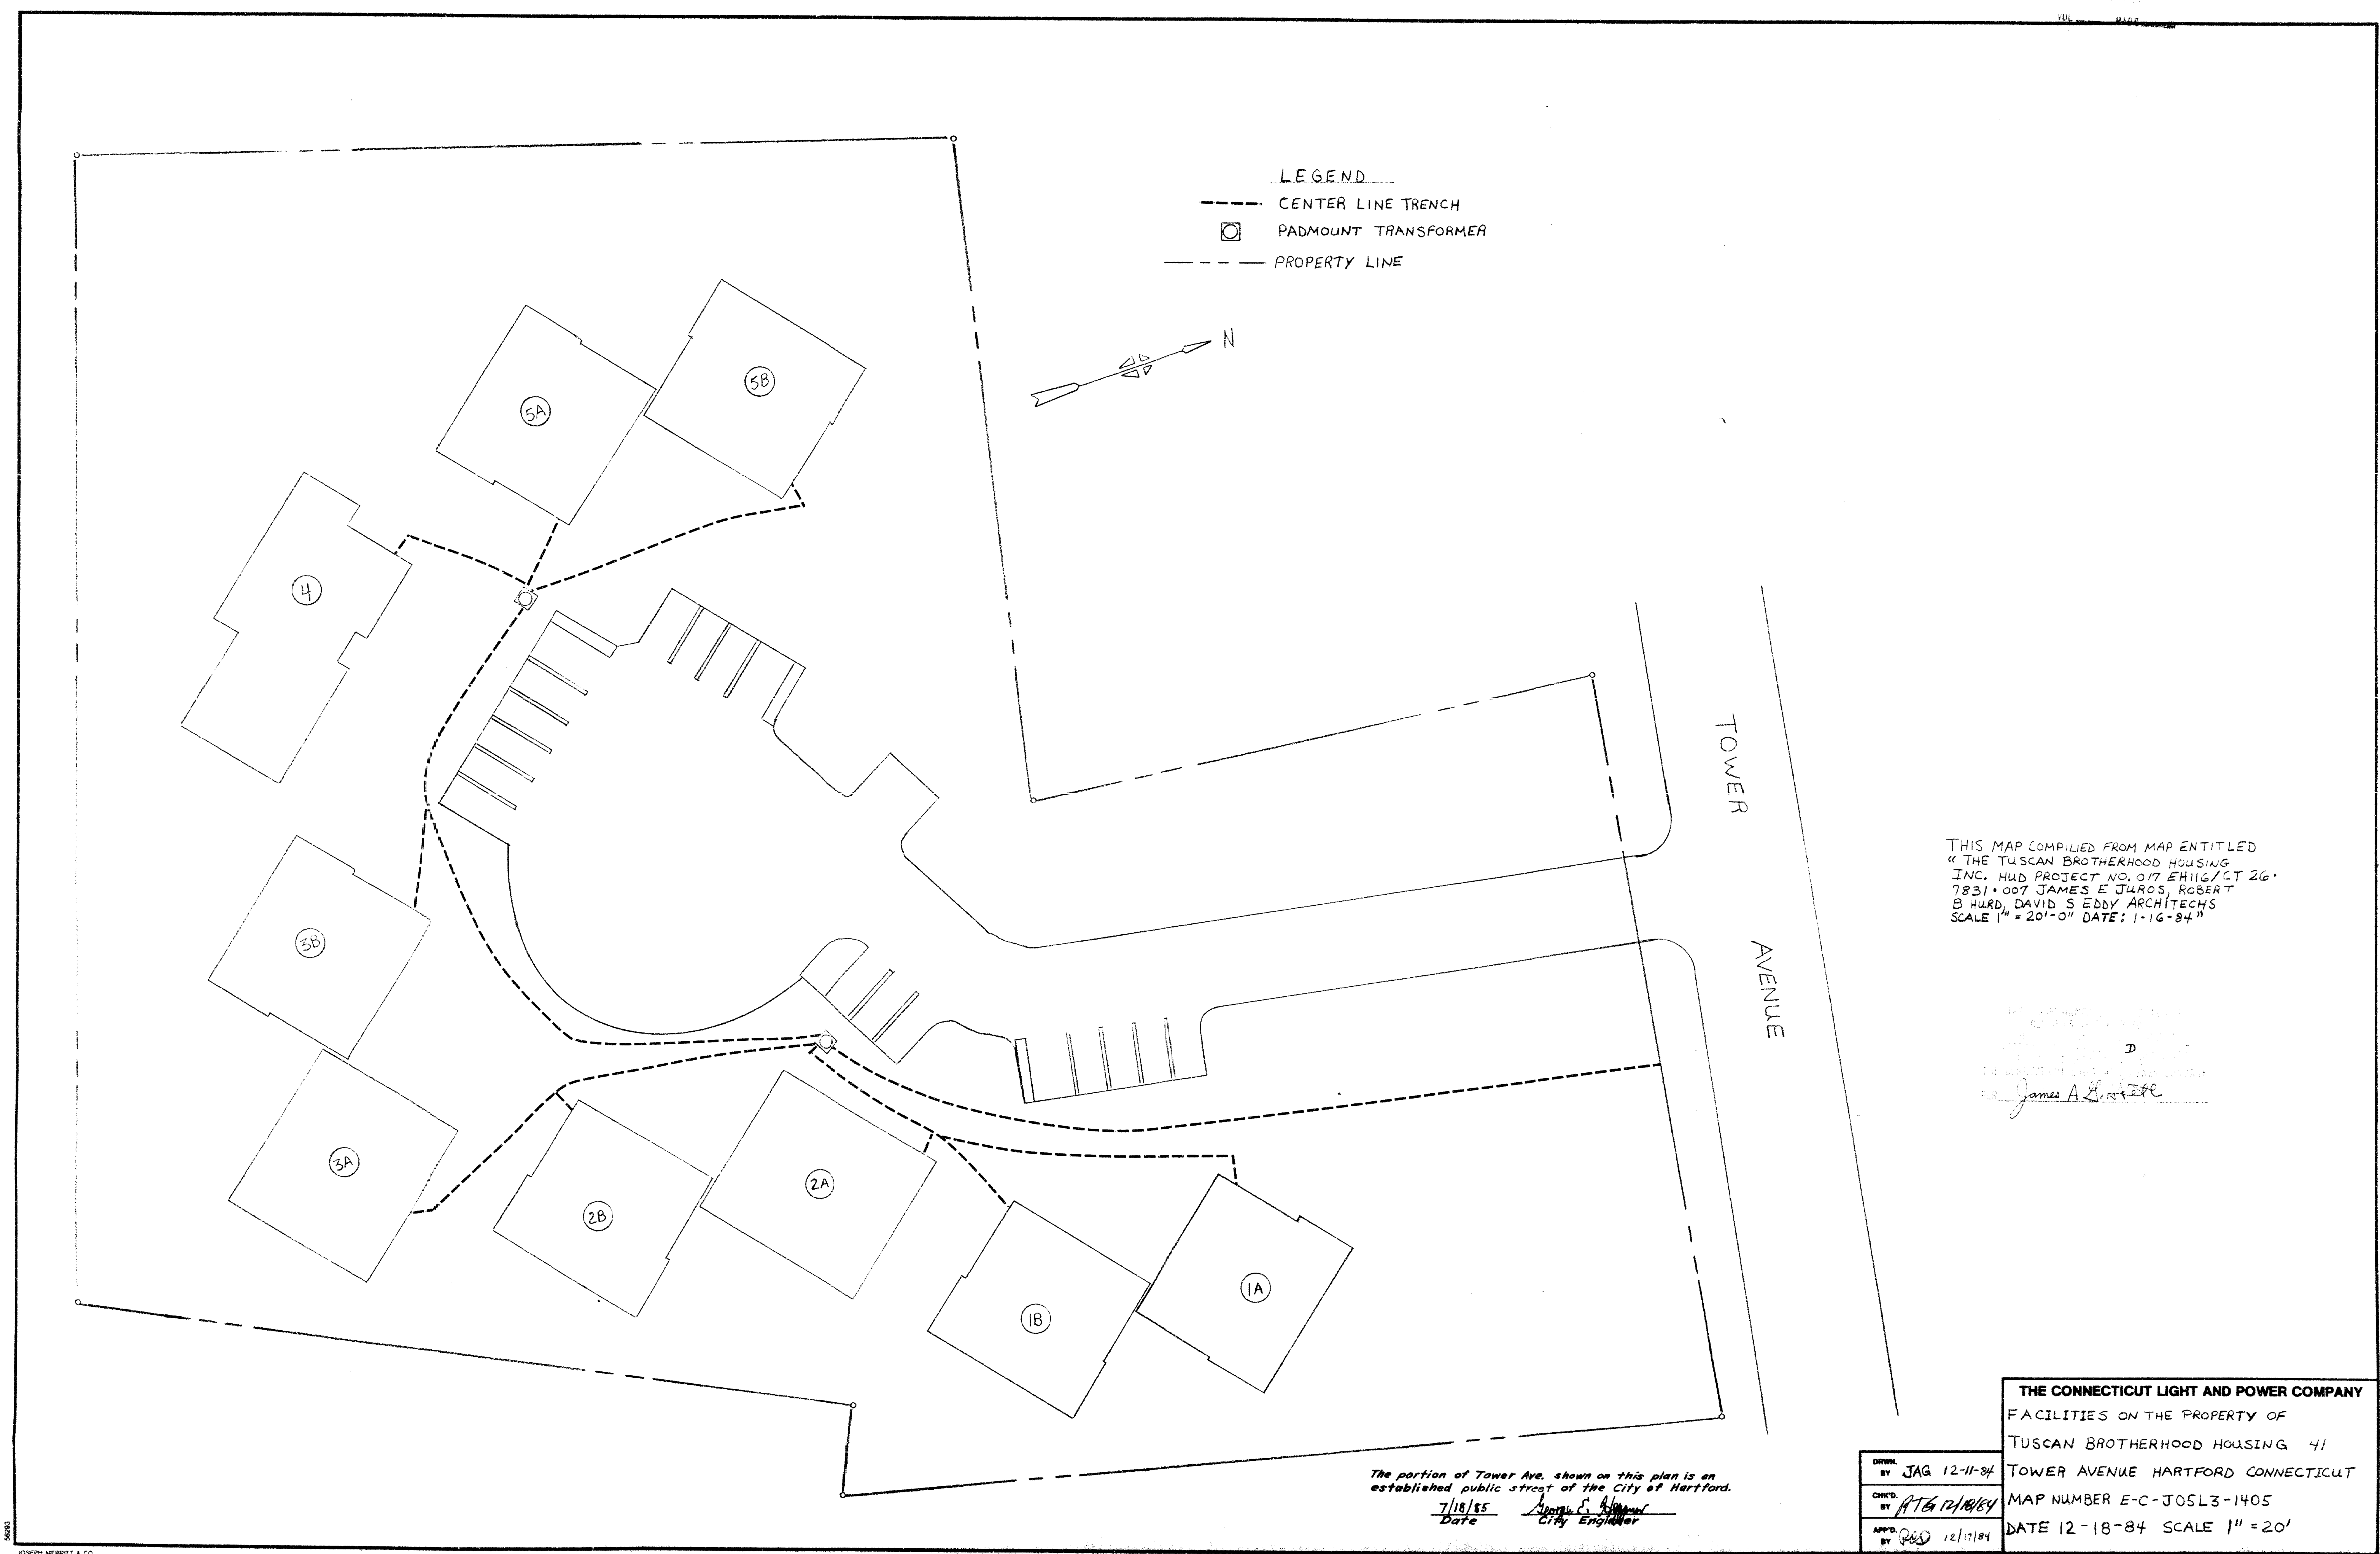


1441

JUL 11 8 58 AM '84
HARTFORD, CT
PAGE

LEGEND
--- CENTER LINE TRENCH
□ PADMOUNT TRANSFORMER
--- PROPERTY LINE

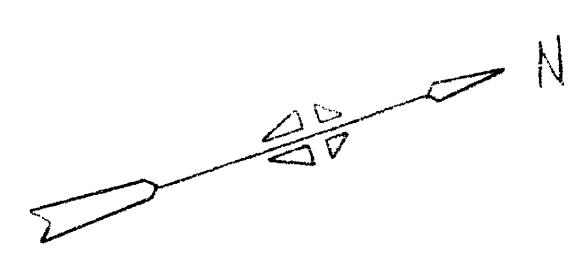

THIS MAP COMPILED FROM MAP ENTITLED
"THE TUSCAN BROTHERHOOD HOUSING
INC. HUD PROJECT NO. 017 EH116/CT 26"
7831-007 JAMES E. JAROS, ROBERT
B. HURD, DAVID S. EDDY ARCHITECTS
SCALE 1" = 20'-0" DATE: 1-16-84"

IN WITNESS WHEREOF
I, James A. L.,
City Engineer

The portion of Tower Ave. shown on this plan is an
established public street of the City of Hartford.
7/18/85 Date
City Engineer

DRAWN BY JAG 12-11-84
CHECKED BY JTE 12/18/84
APPROVED BY JAG 12/17/84

THE CONNECTICUT LIGHT AND POWER COMPANY
FACILITIES ON THE PROPERTY OF
TUSCAN BROTHERHOOD HOUSING 41
TOWER AVENUE HARTFORD CONNECTICUT
MAP NUMBER E-C-JOSL3-1405
DATE 12-18-84 SCALE 1" = 20'



1441
FILE NO.
DATE