



02370

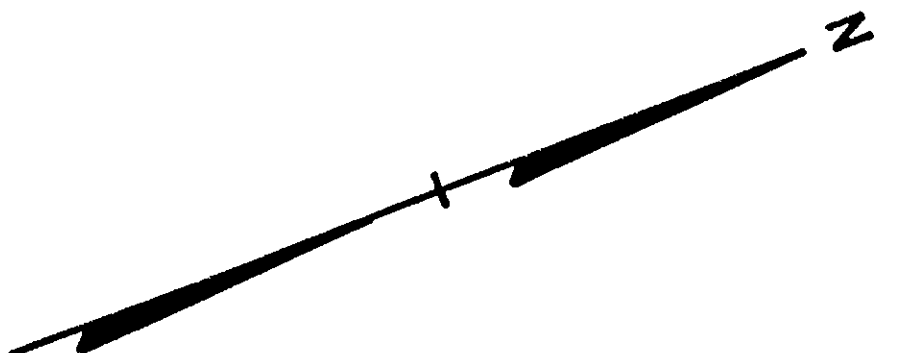

20 0 20 40
SCALE IN FEET

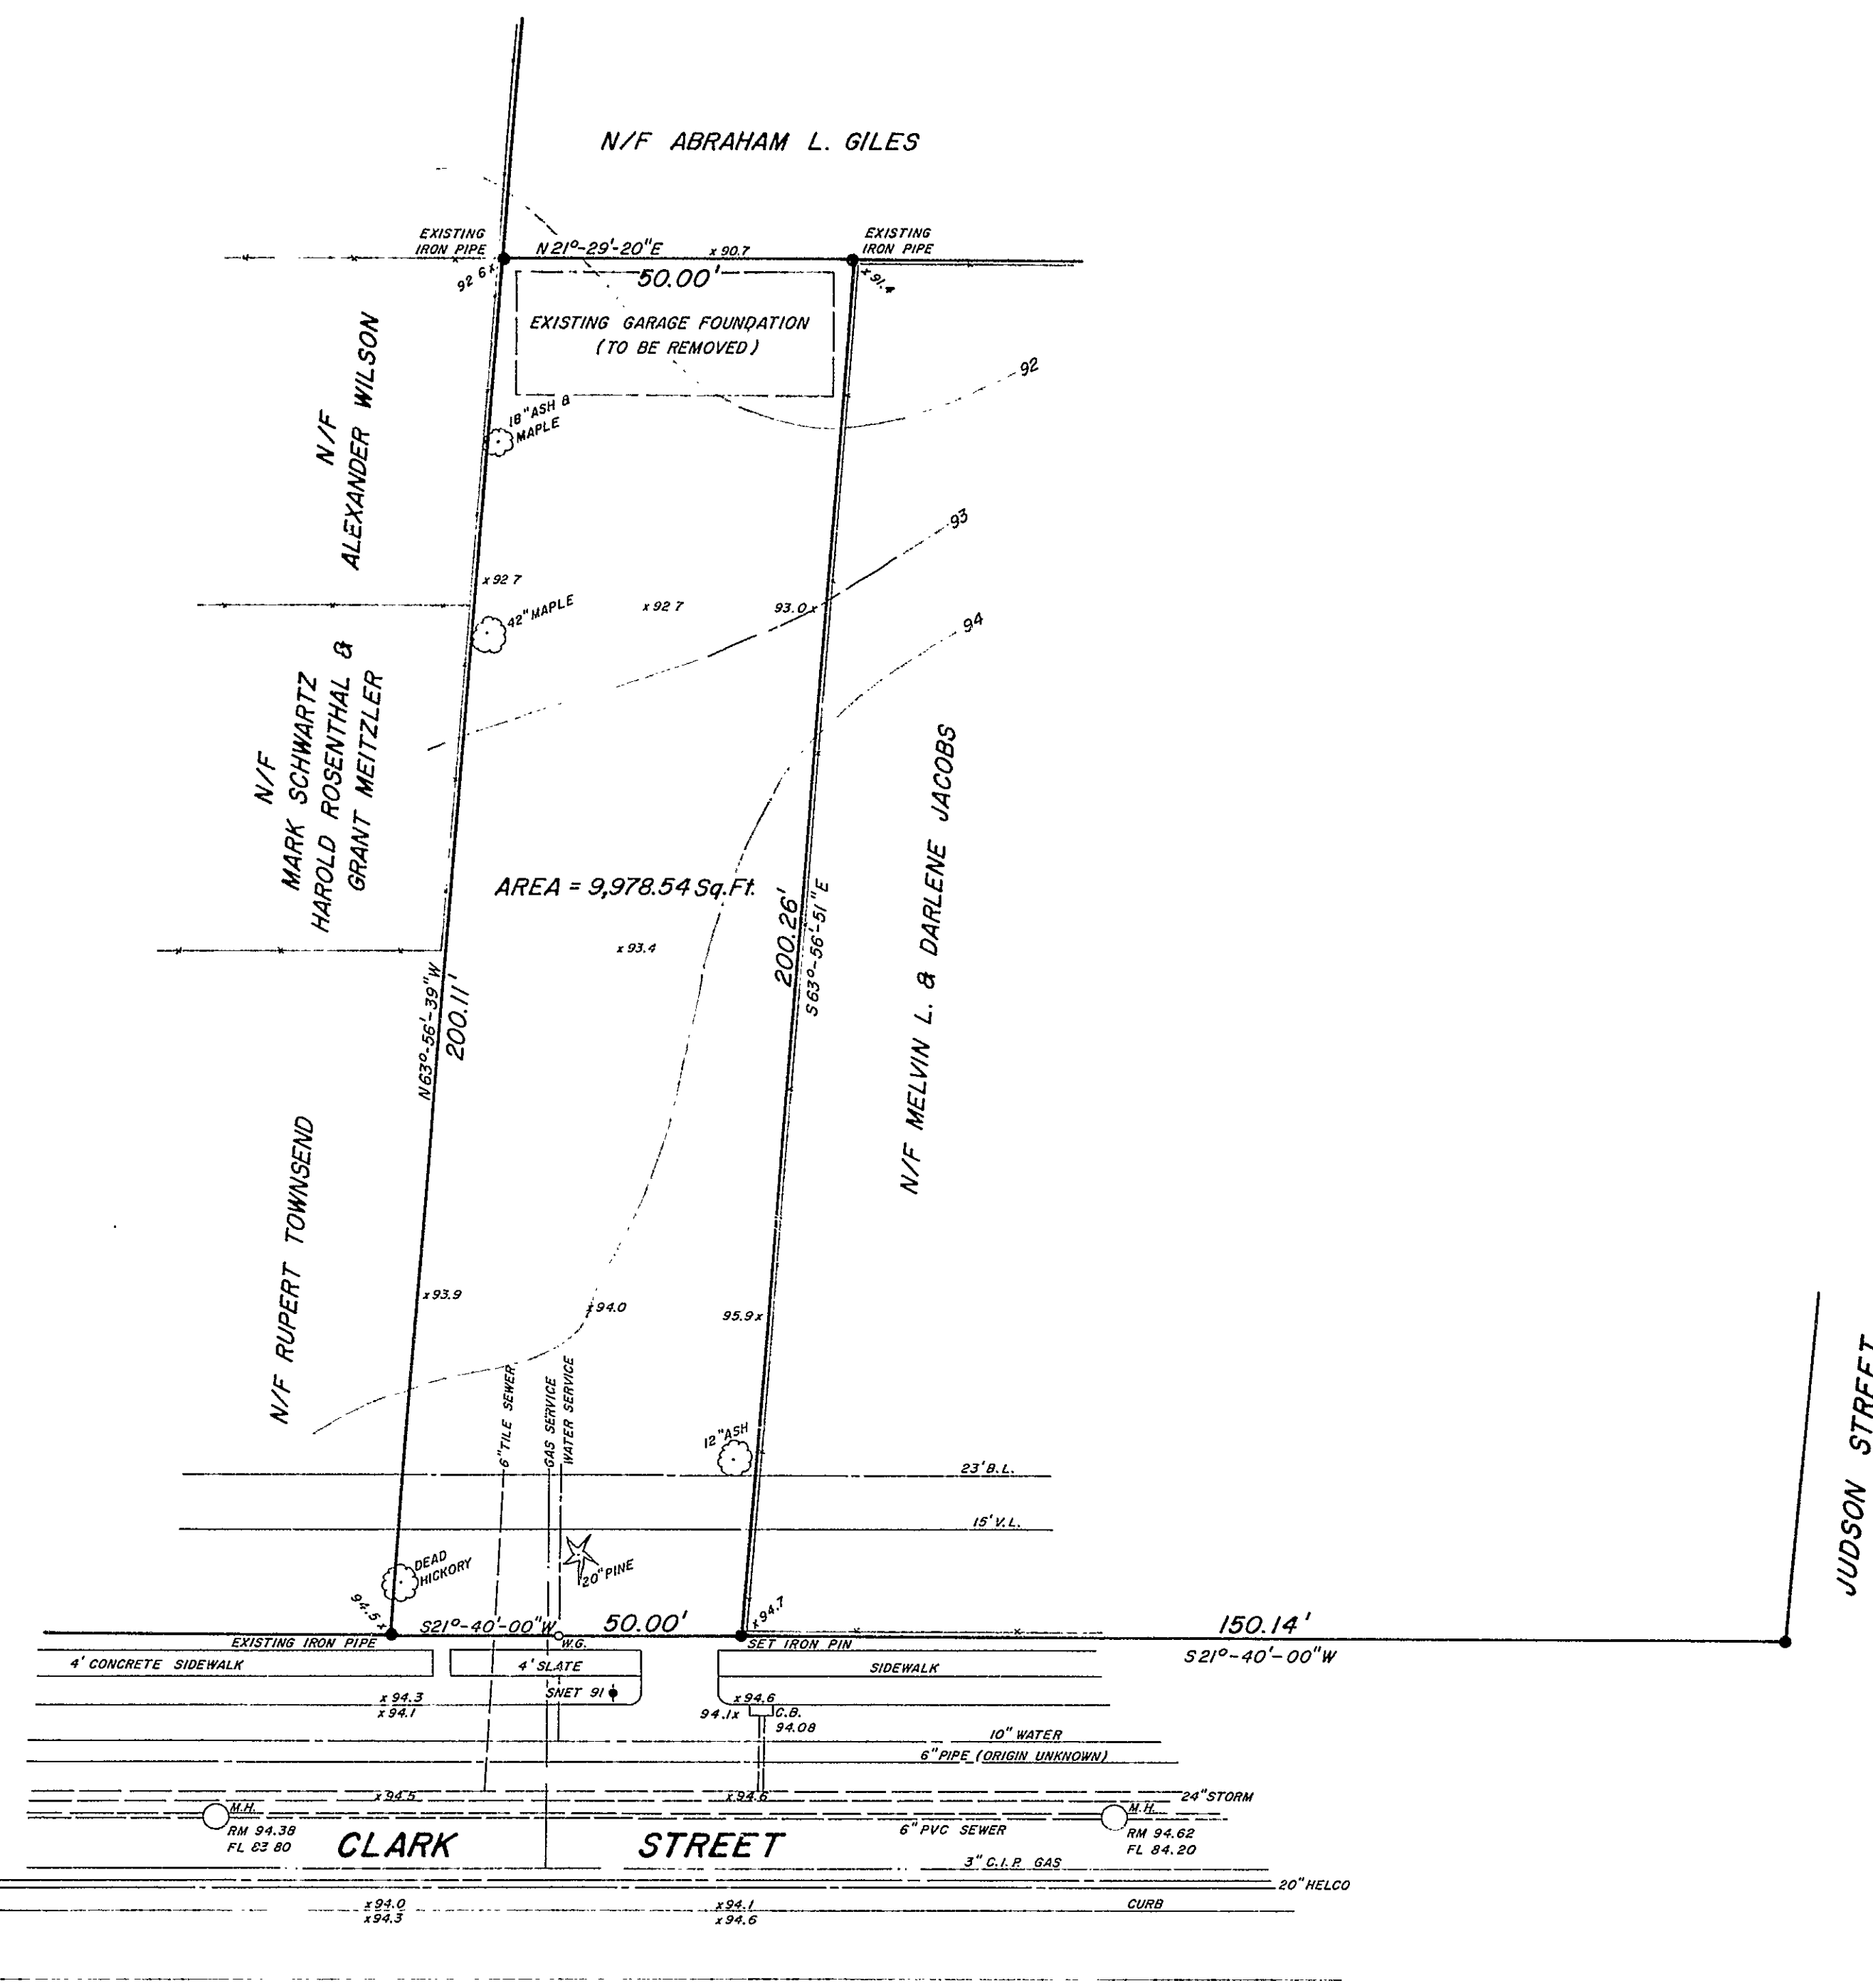

I HEREBY CERTIFY TO THOSE LISTED BELOW THAT THIS SURVEY WAS ACTUALLY MADE UPON THE GROUND ON MARCH 26, 1985 AND THAT IT AND THE BOUNDS AND MEASUREMENTS SHOWN HEREON ARE CORRECT WITHIN THE STANDARDS OF A CLASS A-2 SURVEY AS DEFINED BY THE CONNECTICUT ASSOCIATION OF LAND SURVEYORS, INC. AND THAT, UNLESS OTHERWISE SHOWN, TITLE LINES AND LINES OF ACTUAL POSSESSION ARE THE SAME, THERE ARE NO EASEMENTS OR ENCROACHMENTS AFFECTING THIS PROPERTY APPARENT FROM A CAREFUL INSPECTION OF SAME OTHER THAN THOSE SHOWN OR DEPICTED THEREON.

Gerrie Dubiel
GERRIE DUBIEL
NELSON - CLARK ASSOCIATES
CONNECTICUT HOUSING FINANCE AUTHORITY
CAPITOL HOUSING FINANCE CORPORATION
THE CITY OF HARTFORD
HARTFORD REDEVELOPMENT AGENCY
THE STATE OF CONNECTICUT
LAWYERS TITLE INSURANCE CORPORATION
AEG DESIGN/BUILD, INC. dba NELSON - CLARK ASSOCIATES
CONN. LICENSED L.S. NO. 9673

117-119
CLARK STREET
HARTFORD, CT 06103
FBI-11



The portions of Clark St. and Judson St. shown on this plan are established public streets of the City of Hartford.
R. B. RS
2276
Alvin C. Nutter
City Engineer

PROPERTY OF
NORTHEAST COMMONS
117-119 CLARK STREET
HARTFORD, CONNECTICUT
SCALE: 1" = 20'
DUBIEL ASSOCIATES
MARCH 26, 1985
SURVEY 1176-A

SCHEDULE "A-4"

138

1444

