



4734

RECEIVED BY
APR 12 1985
TOWN ENGINEER
HARTFORD
VOL. PAGE

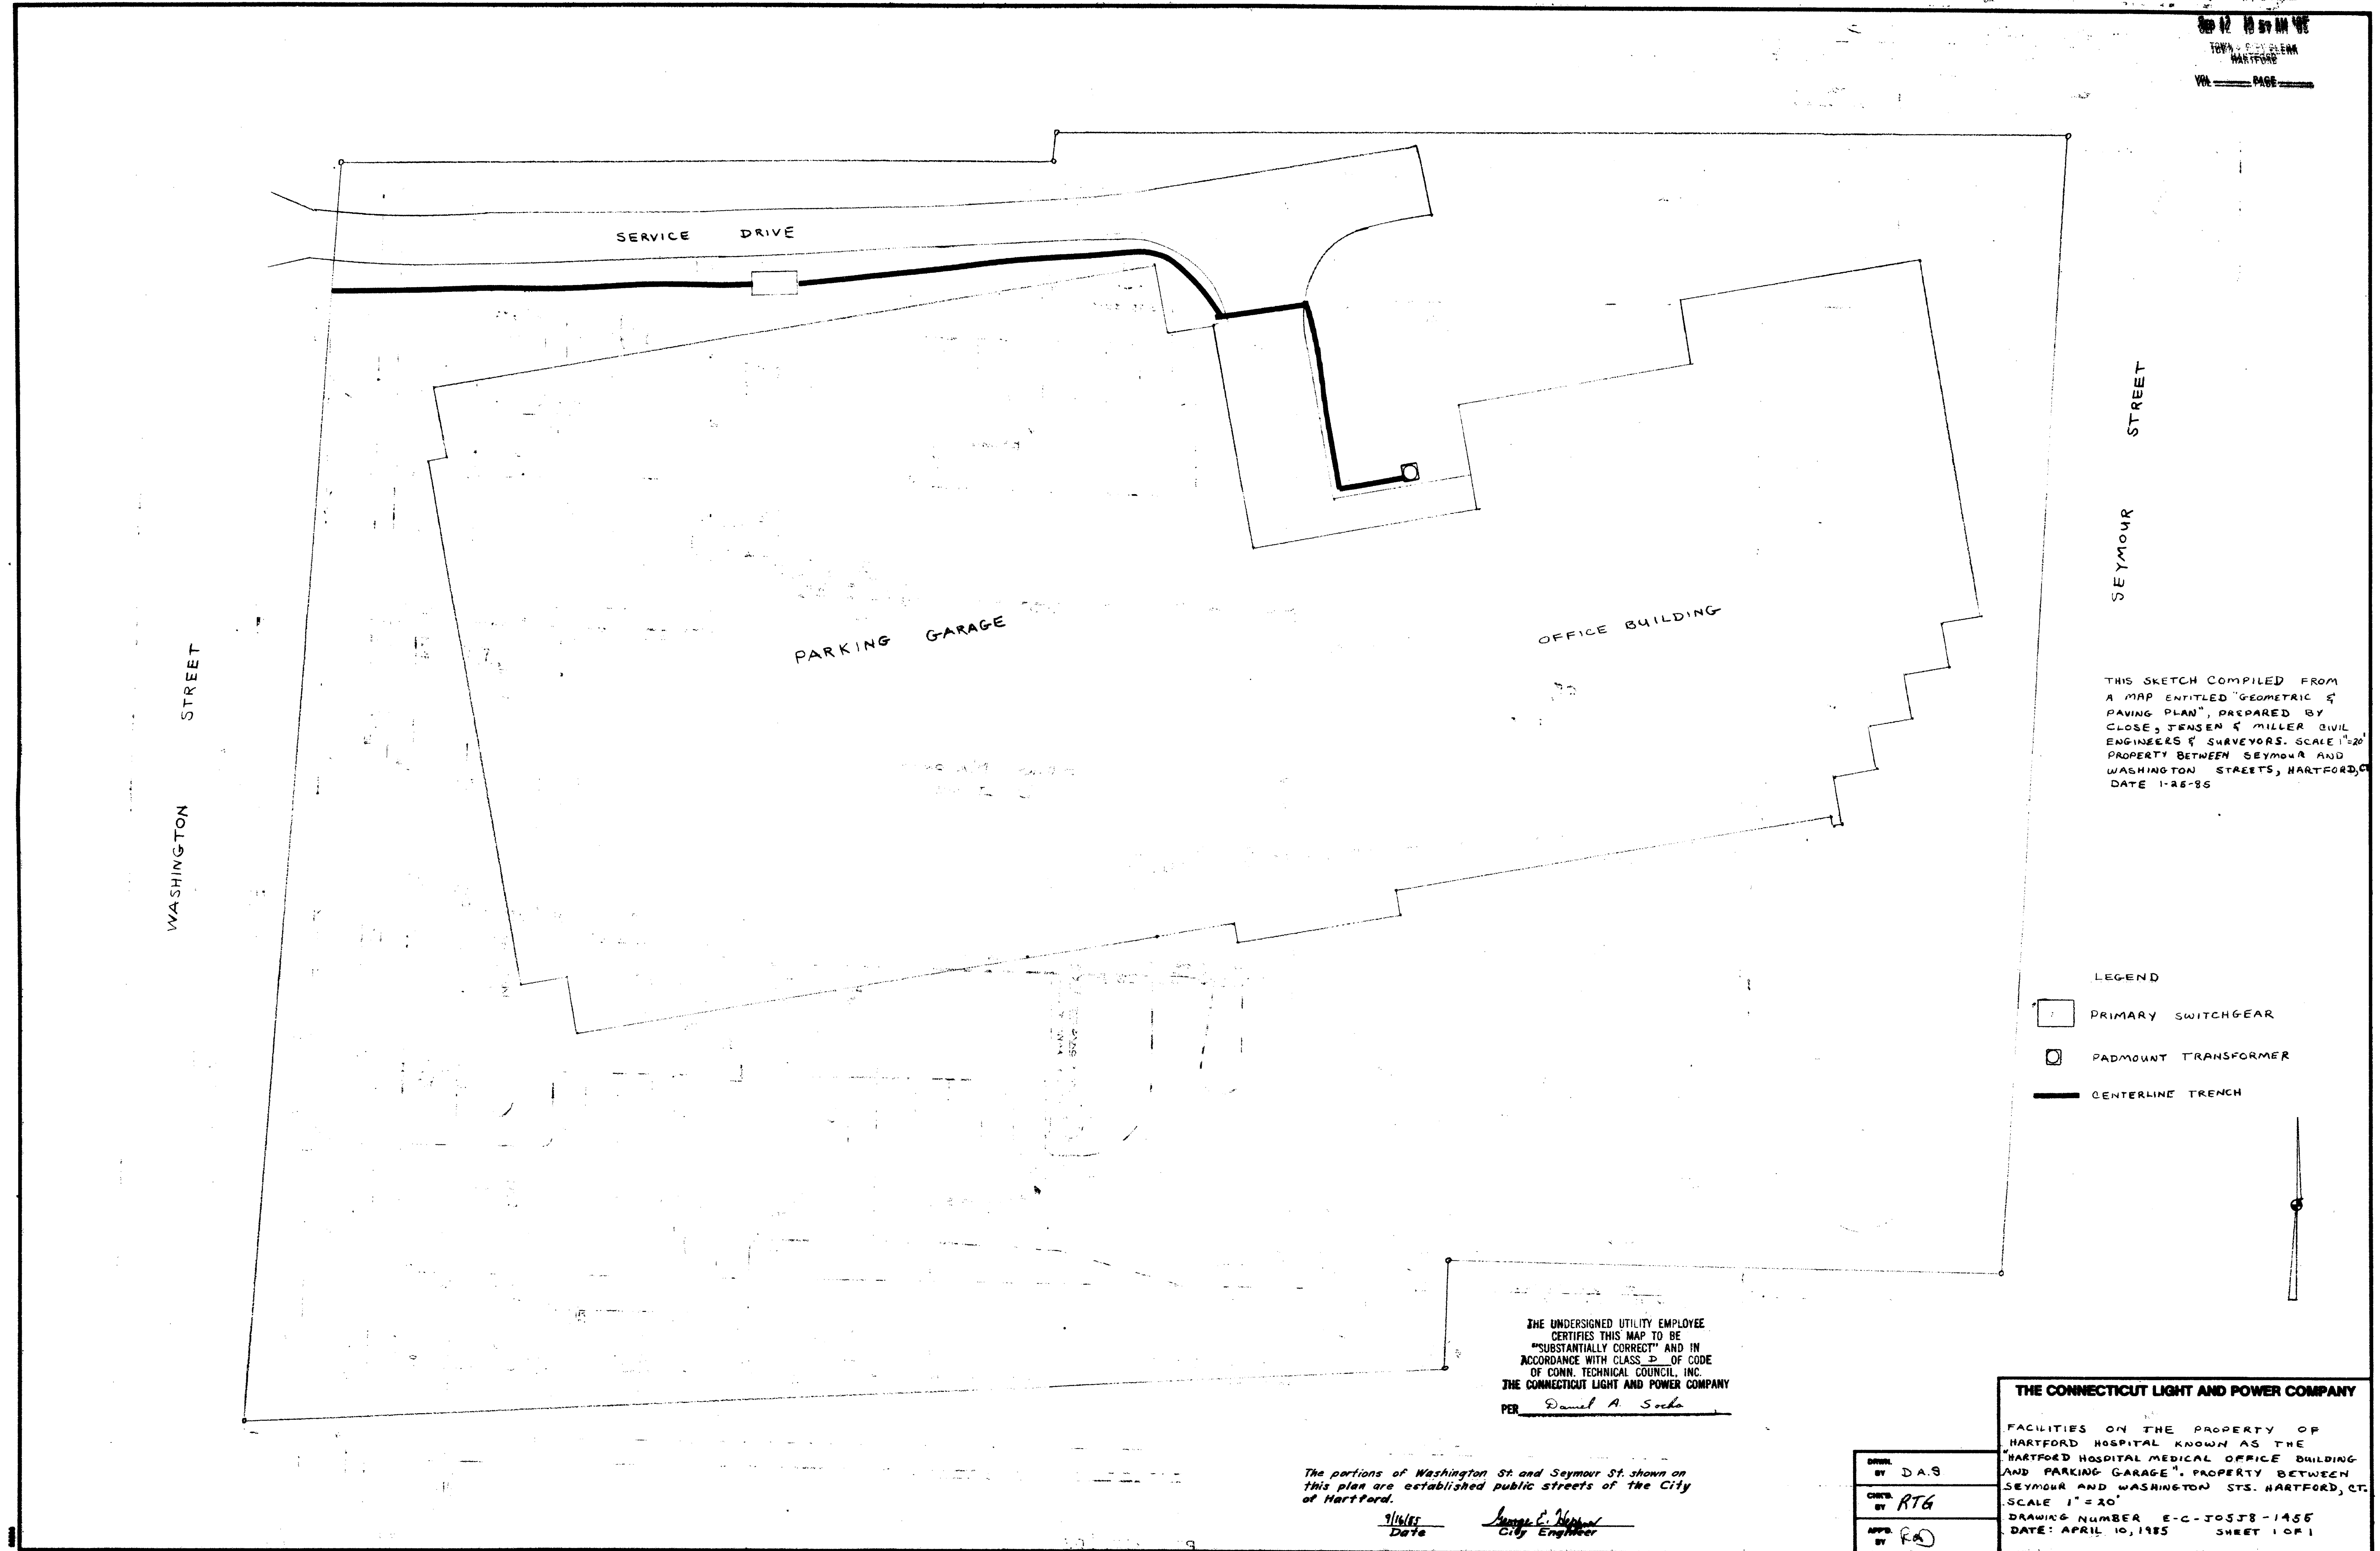

FOR FILE COPY NUMBER 1452

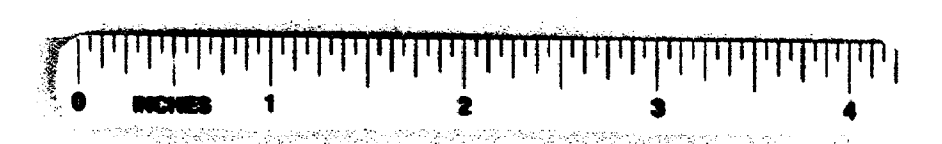

14

1452