


HUNGERFORD STREET

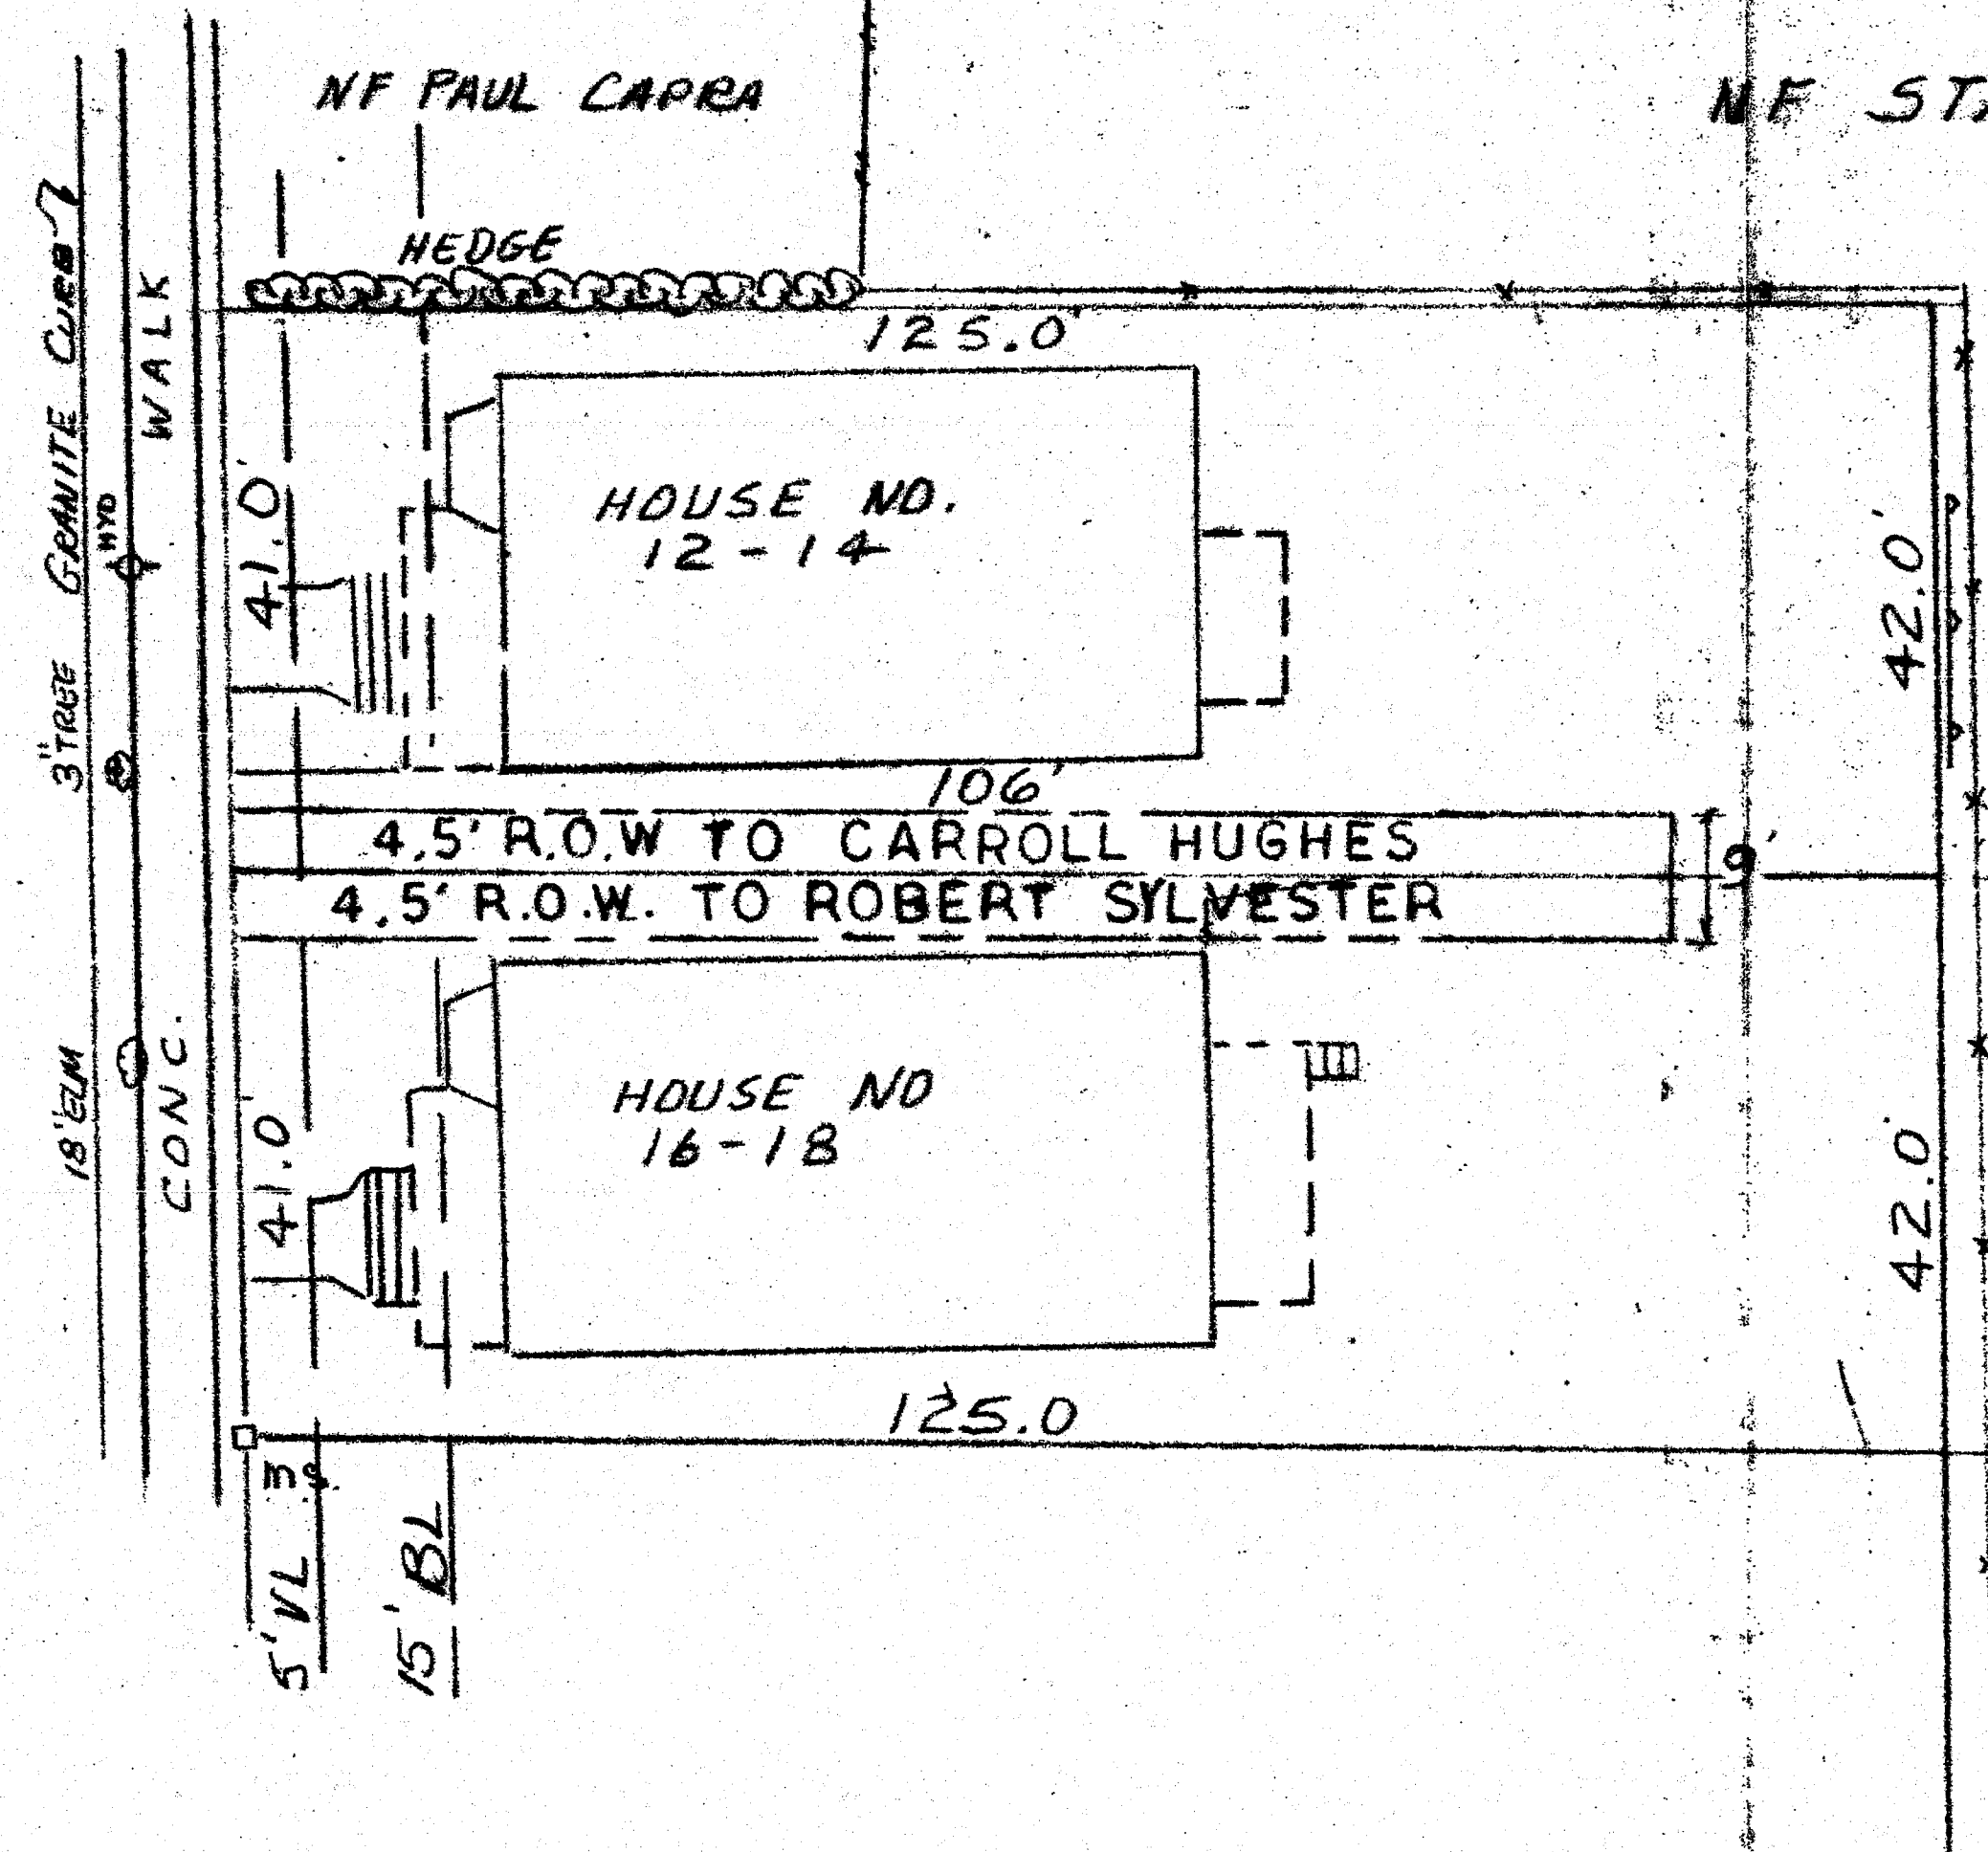

DRIVEWAY RIGHTS
 PROPERTY OF
 ROBERT SYLVESTER AND CARROLL HUGHES
 LOCATED AT
 12-14 AND 16-18 HUNGERFORD ST.
 HARTFORD CONN.
 SCALE 1" = 20'
 JULY, 1985

RECEIVED BY
John A. Delmastro
 OCT 16 12 30 PM '85
 TOWN & CITY CLERK
 HARTFORD
 VOL. 6157 PAGE 1

I HEREBY CERTIFY THIS MAP SUBSTANTIALLY
 CORRECT, BUILDINGS AND LOT LINES LOCATED AS
 SHOWN *Emilio J. Delmastro LS 7384*
 EMILIO J. DELMASTRO
 LAND SURVEYOR

The portion of Hungerford St. shown on this plan
 is an established public street of the City of
 Hartford.

10/18/85 *John A. Delmastro*
 Date City Engineer

1463

