

EAST FILE CORP IRVINE CA
1980




1480-1

RECEIVED AT
Hartford, Conn.
Nov 18 2 50 PM '85
TOWN OF GLENN
HARTFORD
VOL. PAGE

457-469 PARK STREET &
17-19 SQUIRE STREET
SCALE: 1"=40'

MORTGAGE SURVEY
FOR
FRANK CITINO

HARTFORD, CONNECTICUT
APRIL 25, 1985

 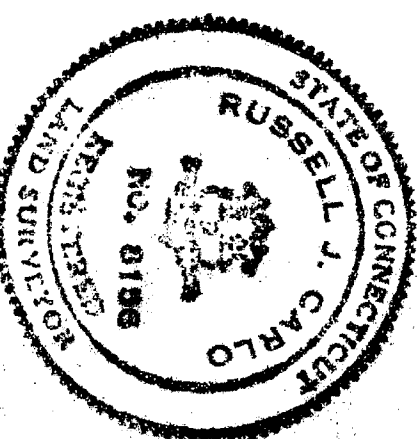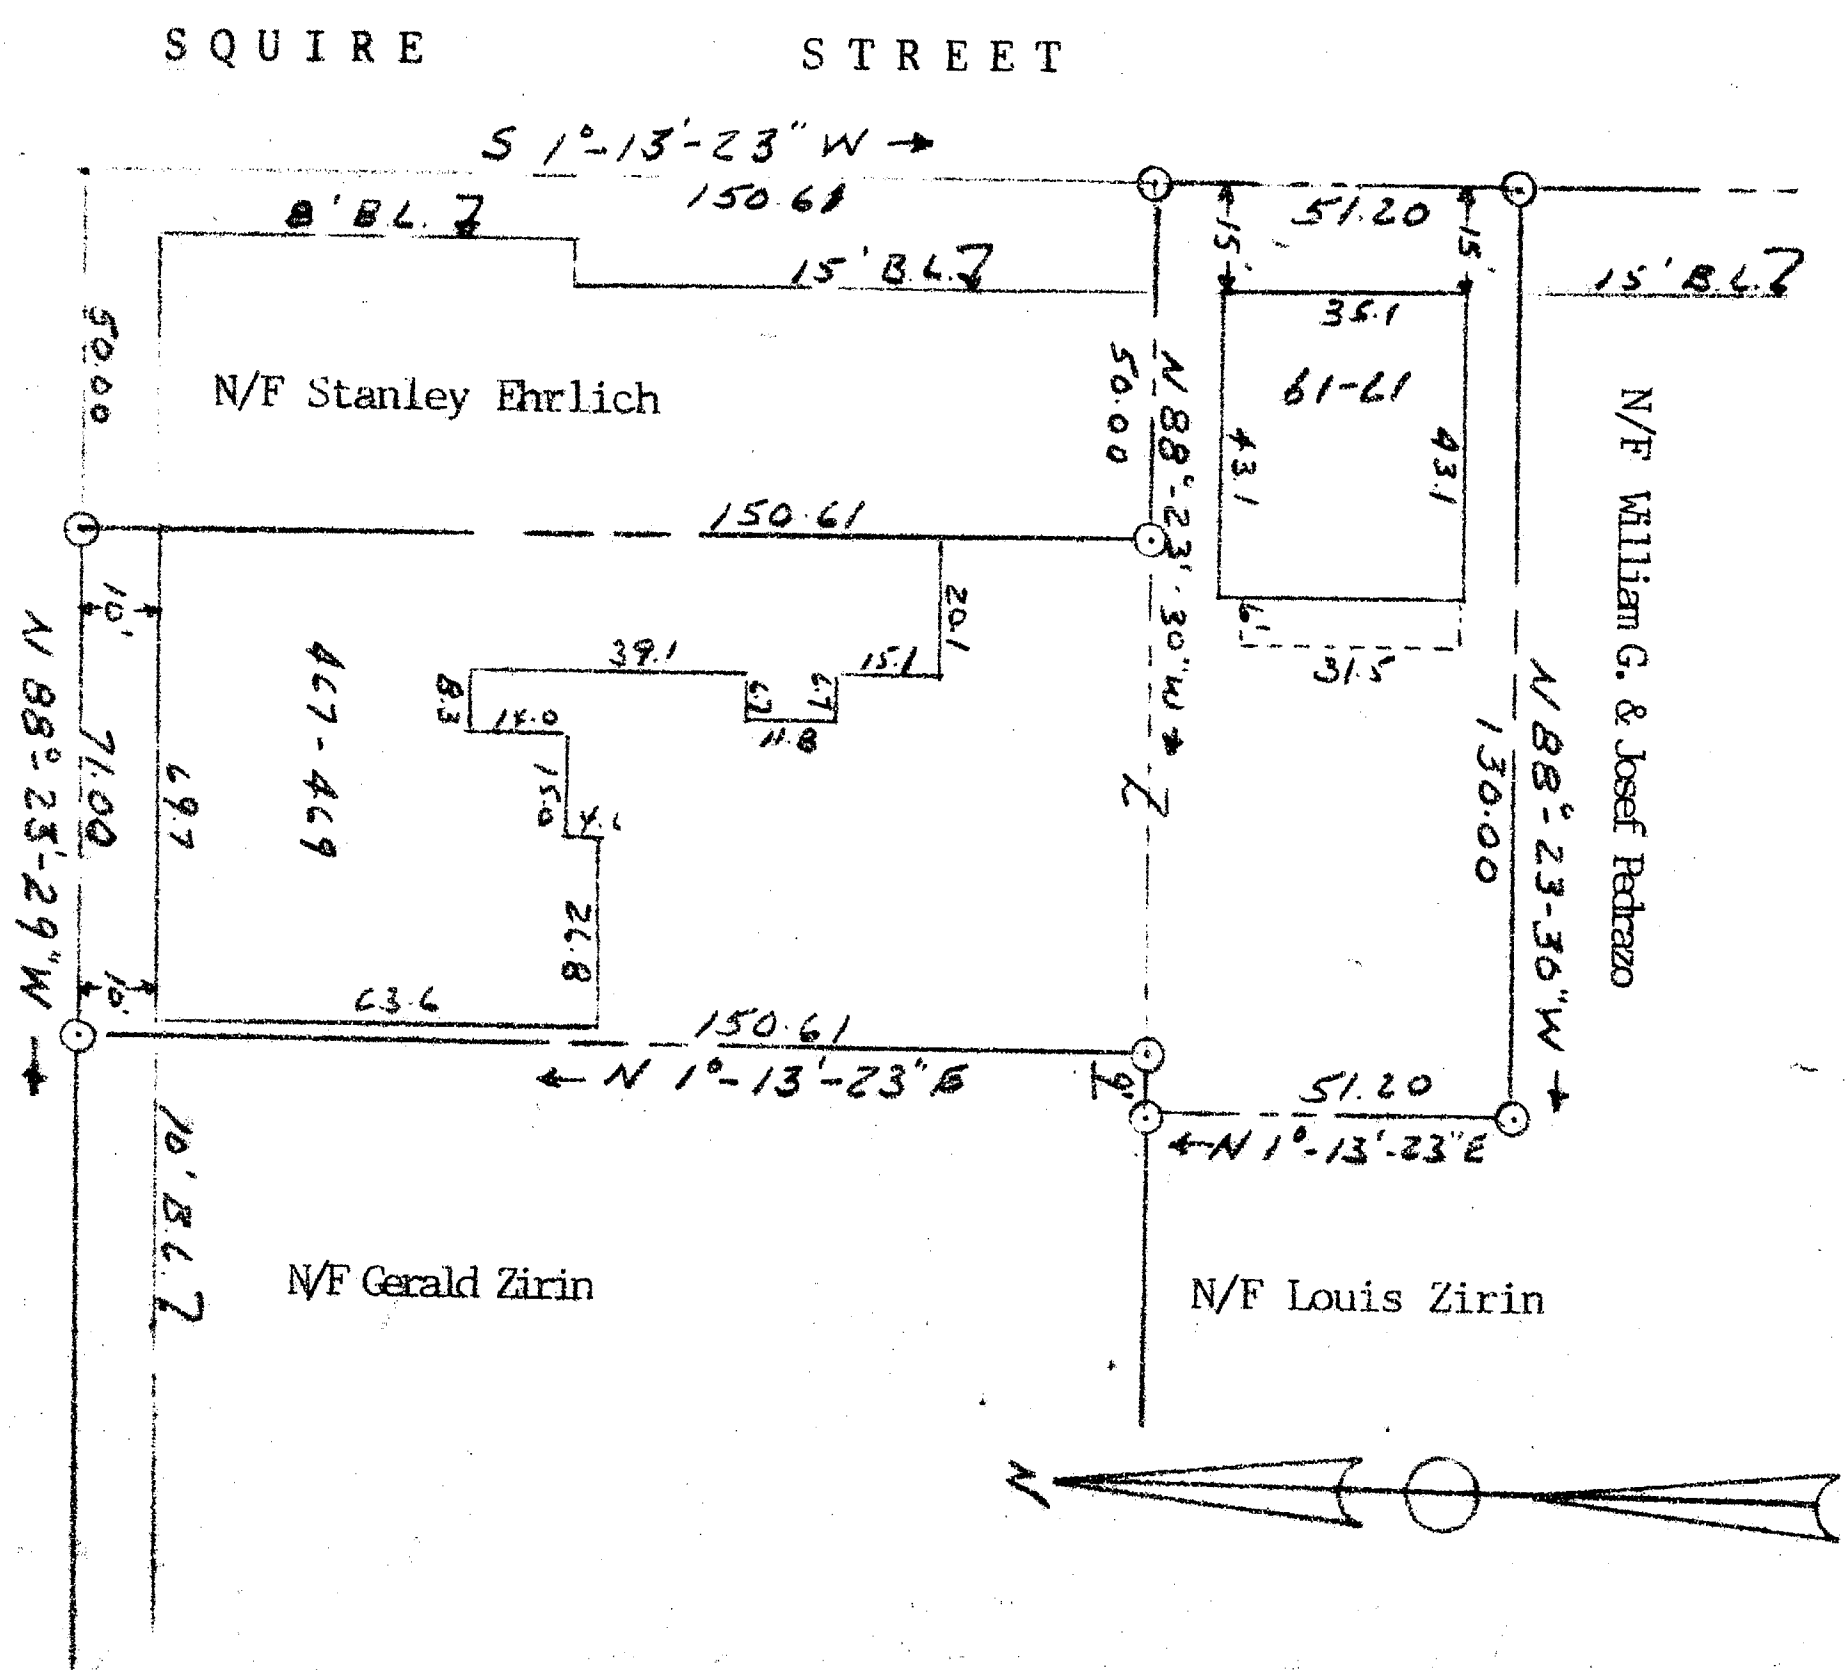

I HEREBY CERTIFY THAT THIS MAP AND SURVEY WERE PREPARED IN ACCORDANCE WITH THE STANDARDS OF A CLASS A-2 SURVEY AS DEMAND IN THE CODE OF PRACTICE FOR STANDARDS OF ACCURACY OF SURVEYS AND MAPS, ADOPTED DECEMBER 10, 1975 AND AMENDED BY THE CONNECTICUT ASSOCIATION OF LAND SURVEYORS INC. RUSSELL J. CARLO, L.S. #6196
The portions of Park St and Squire St shown on this plan are established public streets of the City of Hartford.
Date: May 18, 1985
By: Russell J. Carlo, L.S. #6196
City Engineer

Russell J. Carlo, L.S. #6196
Registered Land Surveyor



1480

50