


Area = 57 466 s.f.
1.319 acr.

SUMMIT STREET

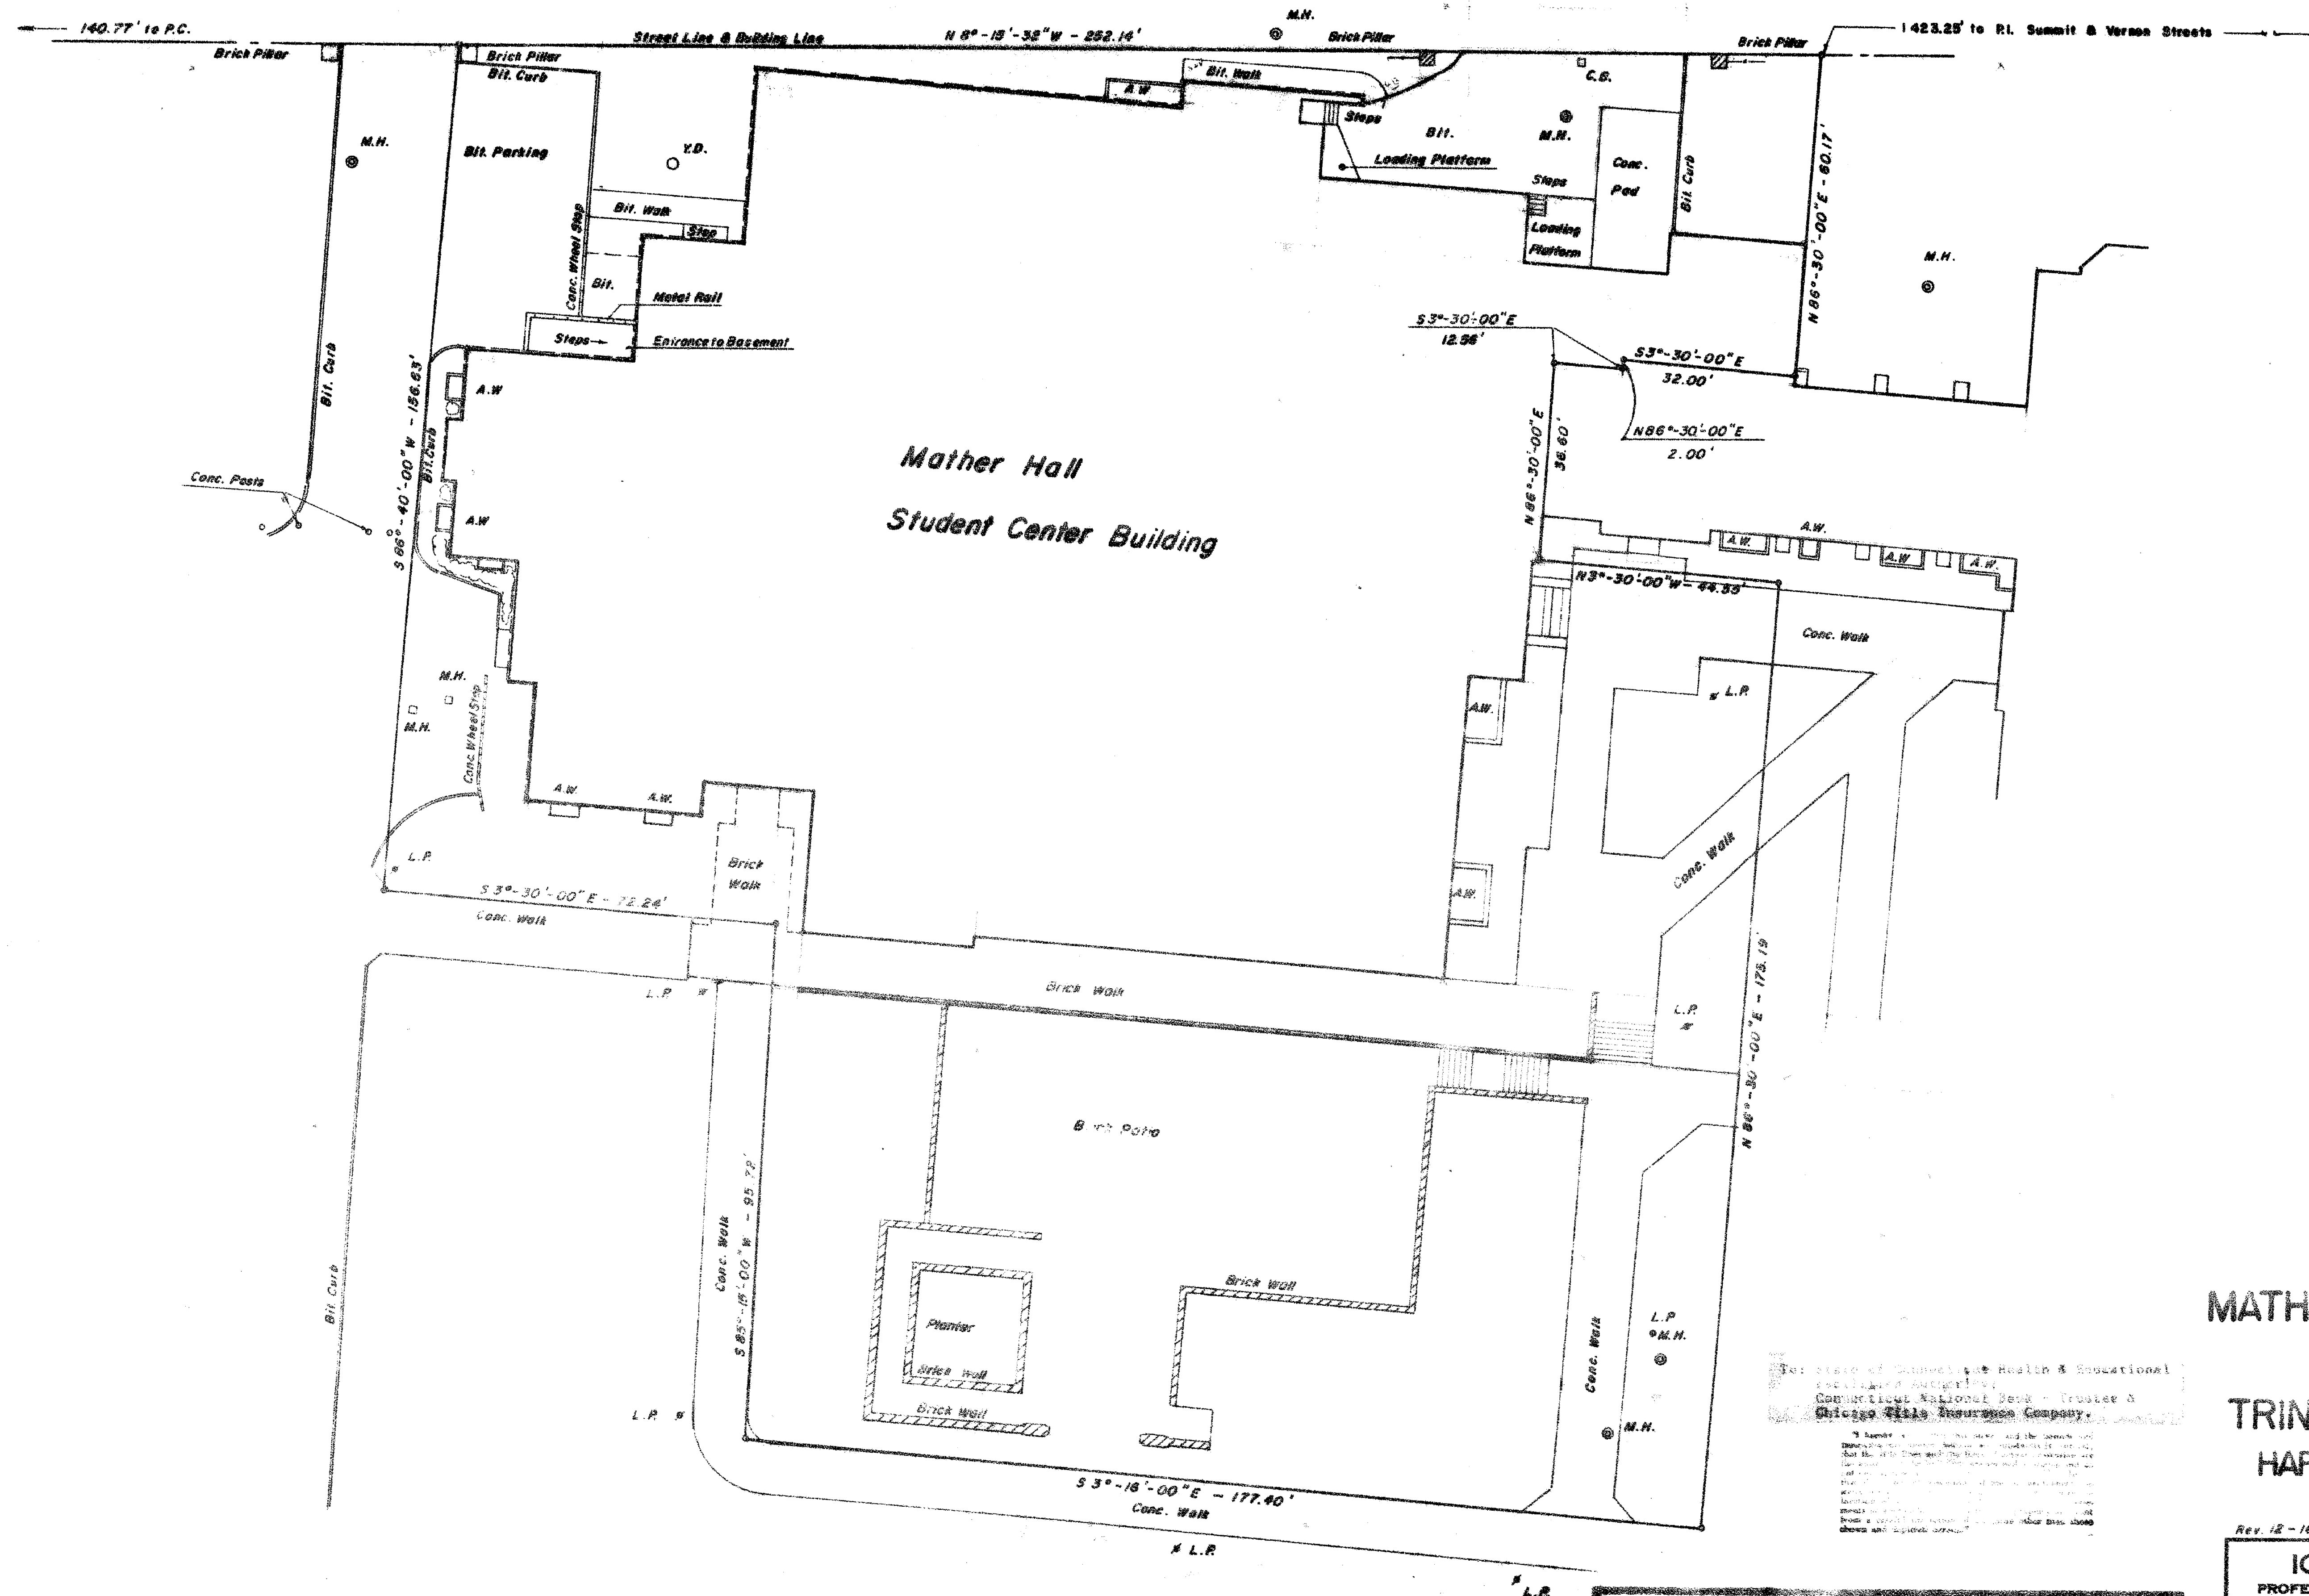


The portion of Summit St. shown on this plan is an established public street of the City of Hartford.
Date 12-8-85
City Engineer

I HEREBY CERTIFY THAT THIS MAP AND SURVEY WERE PREPARED IN ACCORDANCE WITH THE STANDARDS OF A CLASS 'A' SURVEY AS DEFINED IN THE CODE OF PRACTICE FOR STANDARDS OF THE PRACTICE OF SURVEYS AND MAPS, ADOPTED OCTOBER 10, 1975 AS AMENDED BY THE CONNECTICUT ASSOCIATION OF LAND SURVEYORS, INC.
12-8-85 3756
DATE REGISTRATION NO.

MATHER CAMPUS
CENTER
TRINITY COLLEGE
HARTFORD, CONN.

Rev. 12-18-85
IGOR VECHESLOFF
PROFESSIONAL ENGINEER & LAND SURVEYOR
51 LORRAINE STREET
HARTFORD, CONNECTICUT
SCALE 1" = 10' DATE 12-8-85
DRAWING NO. 8026

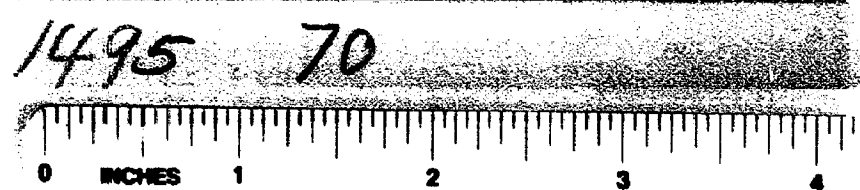

1495