



EASH FILE CORP IRVING GA	
BPM 14	
1500	

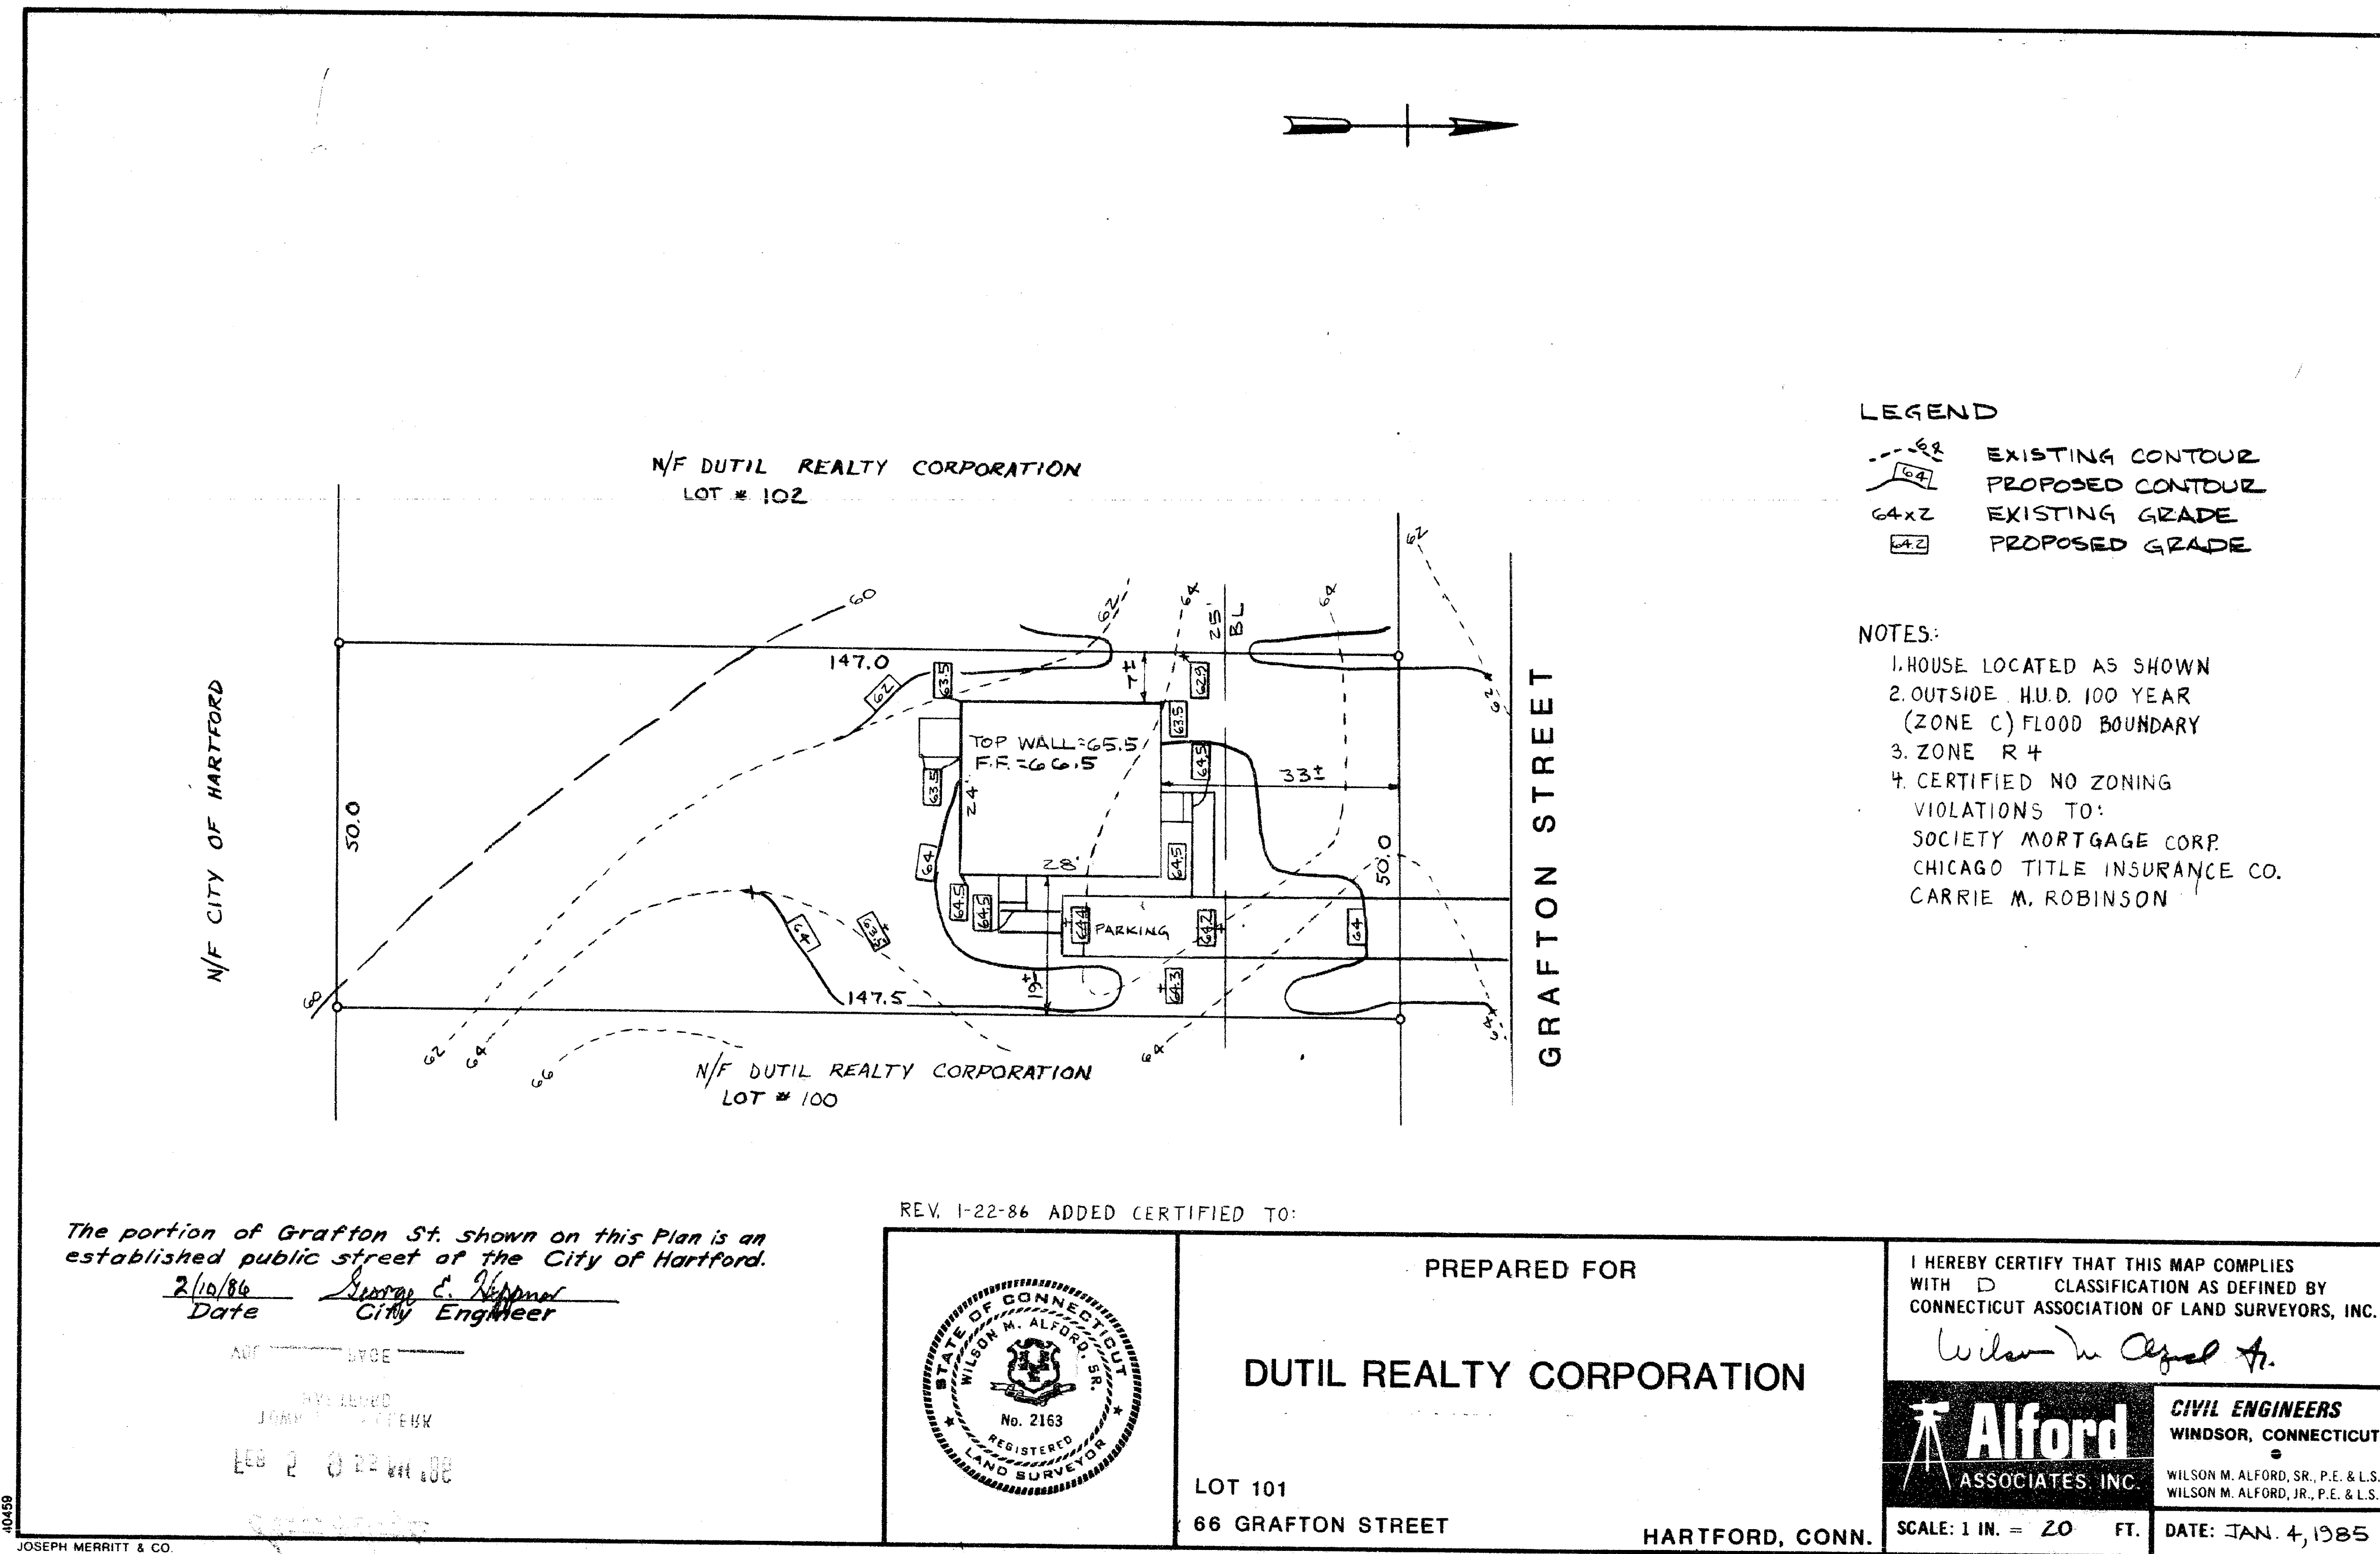

The portion of Grafton St. shown on this Plan is an established public street of the City of Hartford.

Date 2/10/86 James E. Nether
City Engineer

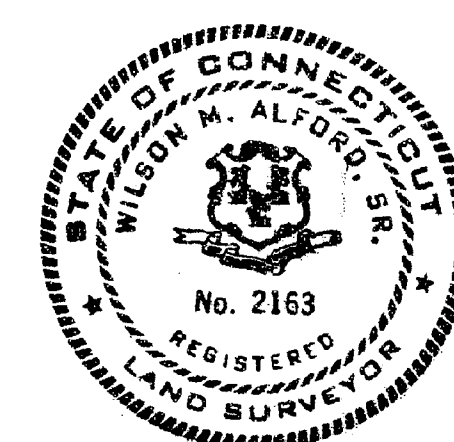

ADP BYCE

WILSON M. ALFORD, JR.

LEG 2 0 0 2 10 0 2

JOSEPH MERRITT & CO.

1415

76

1500

