


1462

FEB 5 9 55 AM '85
TOWN OF HARTFORD
ENGINEERING

VOL. _____ PAGE _____

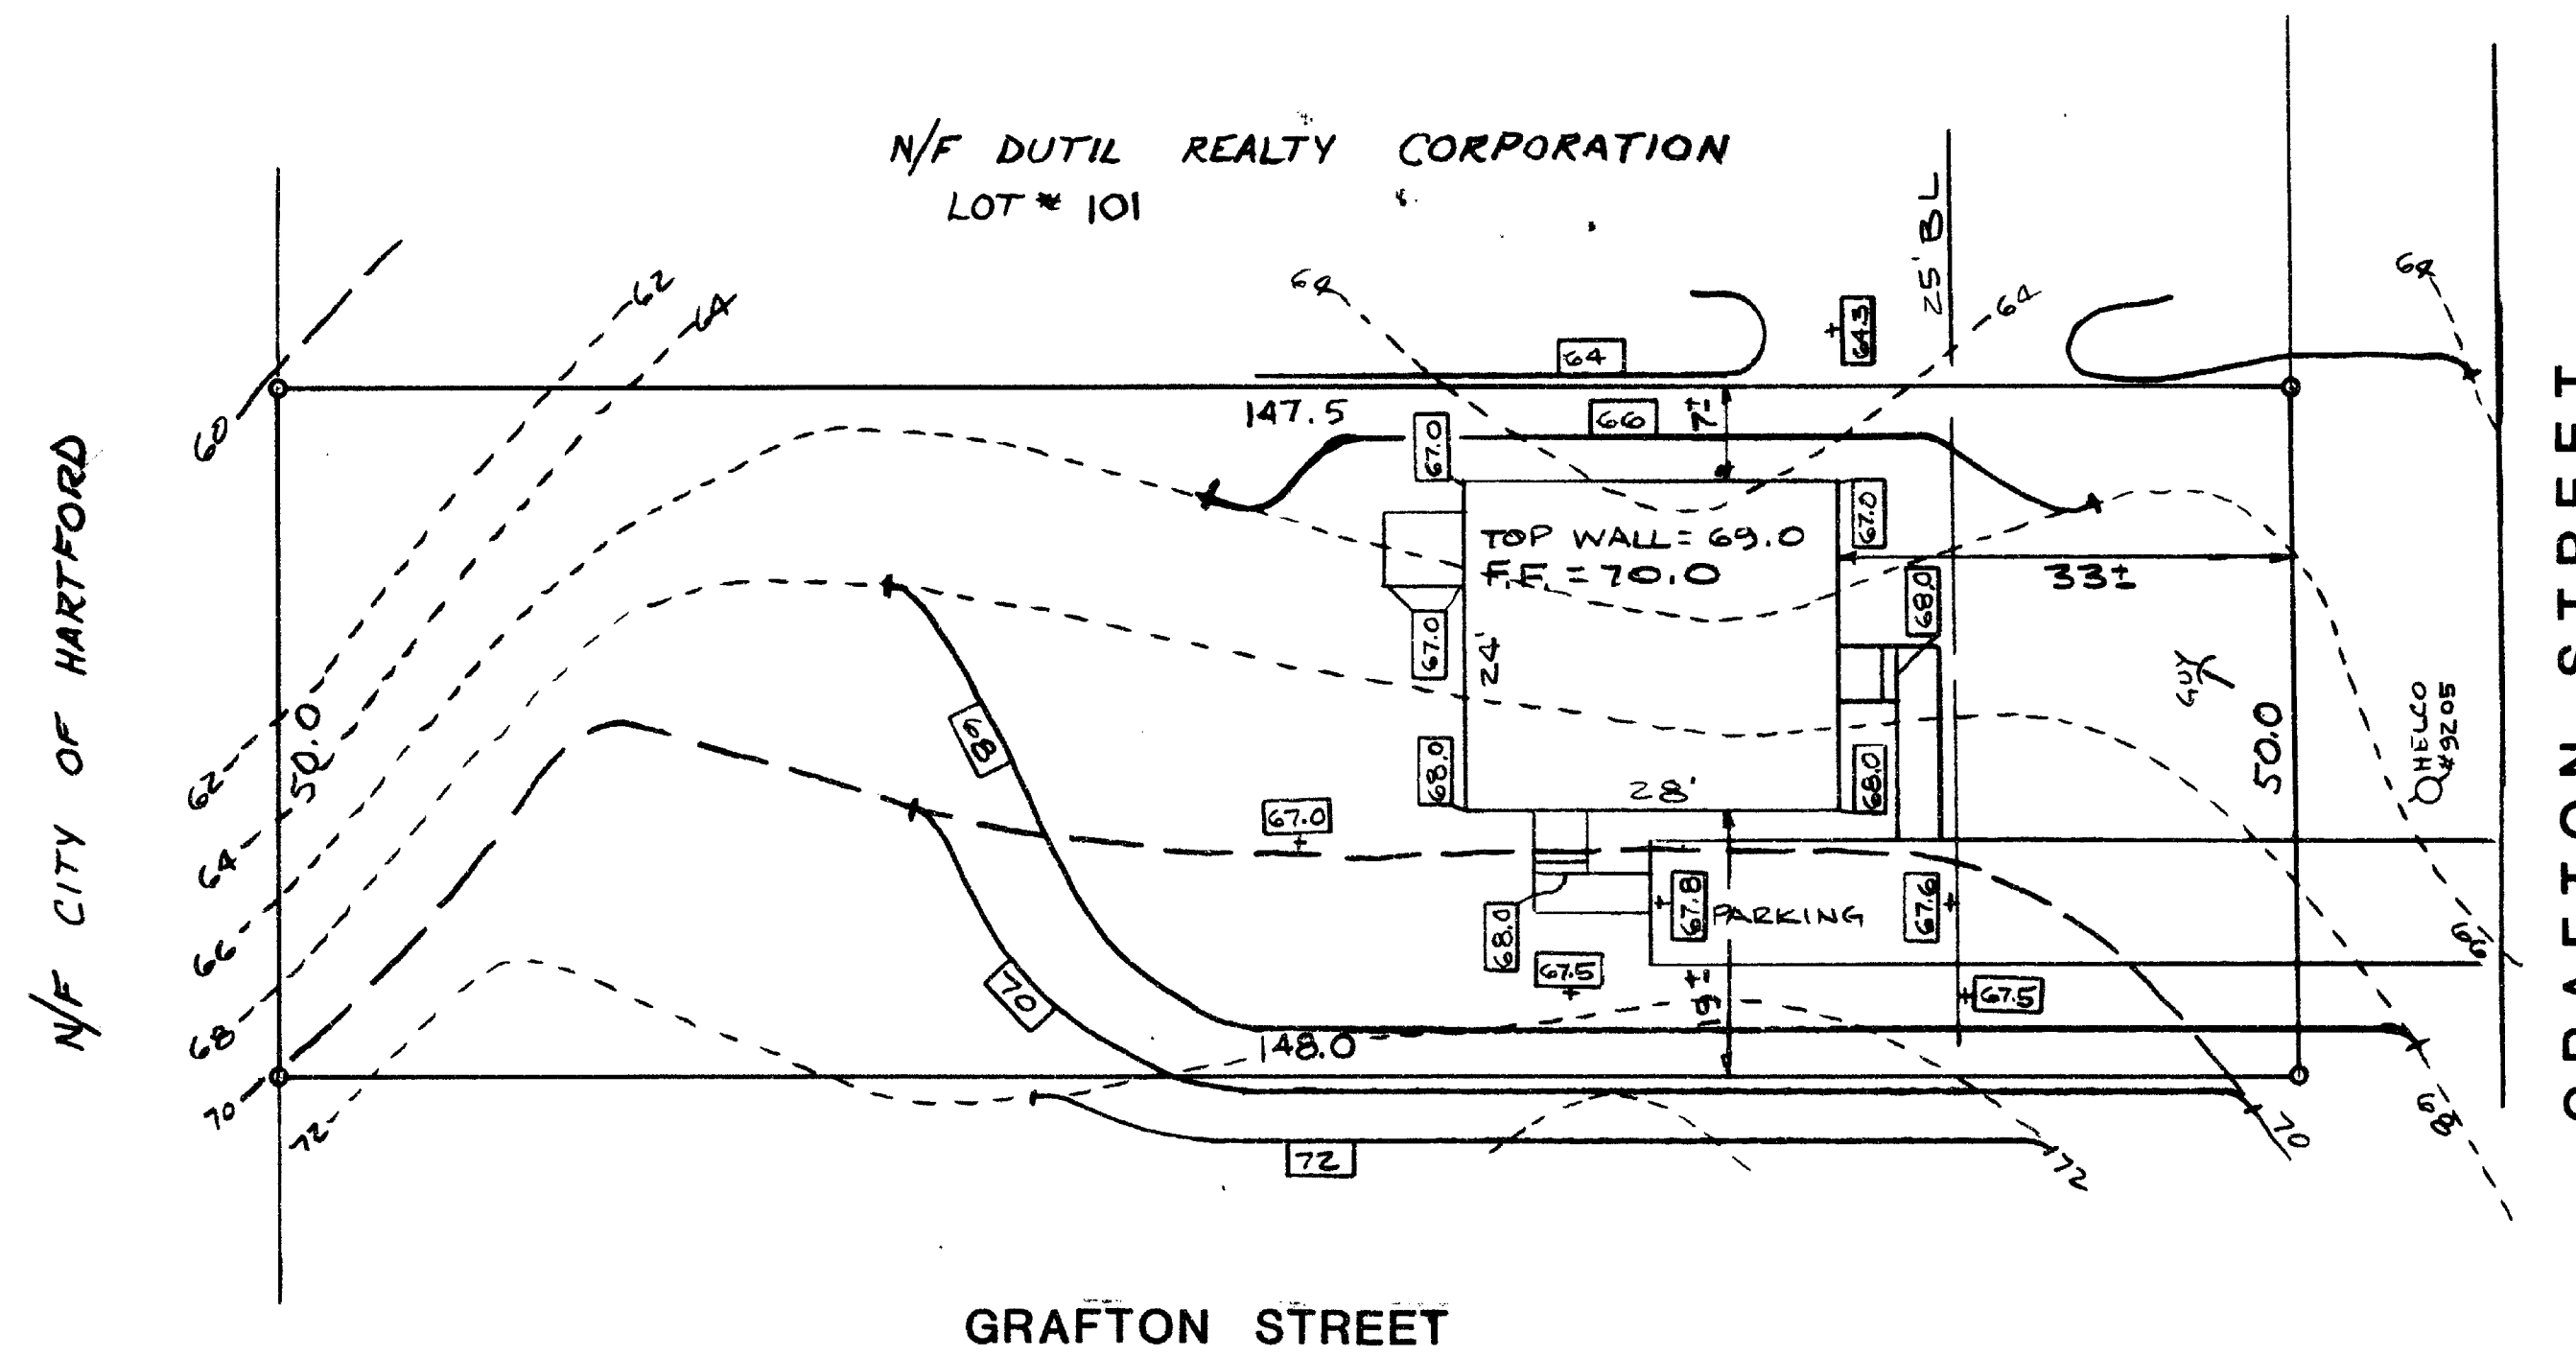

LEGEND

- EXISTING CONTOUR
- PROPOSED CONTOUR
- EXISTING GRADE
- PROPOSED GRADE

NOTES:

- HOUSE LOCATED AS SHOWN
- OUTSIDE H.U.D. 100 YEAR (ZONE C) FLOOD BOUNDARY
- ZONE 24
- CERTIFIED NO ZONING VIOLATIONS TO: SOCIETY FOR SAVINGS ITS SUCCESSORS & ASSIGNS CHICAGO TITLE INSURANCE CO. ALCIDES ORTIZ AND MARIA ORTIZ

REV. HO # 1 NOTE #4
REV. 9-11-85 ADDED NOTES 1-4



PREPARED FOR
DUTIL REALTY CORPORATION

62 GRAFTON ST.
HARTFORD, CONN.

I HEREBY CERTIFY THAT THIS MAP COMPLIES WITH CLASSIFICATION AS DEFINED BY CONNECTICUT ASSOCIATION OF LAND SURVEYORS, INC.

Wilson M. Alford, Jr.

Alford
ASSOCIATES, INC.

CIVIL ENGINEERS
WINDSOR, CONNECTICUT
WILSON M. ALFORD, SR., P.E. & L.S.
WILSON M. ALFORD, JR., P.E. & L.S.

SCALE: 1 IN. = 20 FT.

DATE: JAN. 3, 1985

The portion of Grafton St. north of lot shown on this plan is an established public street of the City of Hartford.

2/10/86
Date
George E. Nappier
City Engineer

JOSEPH MERRITT & CO.

