


1504

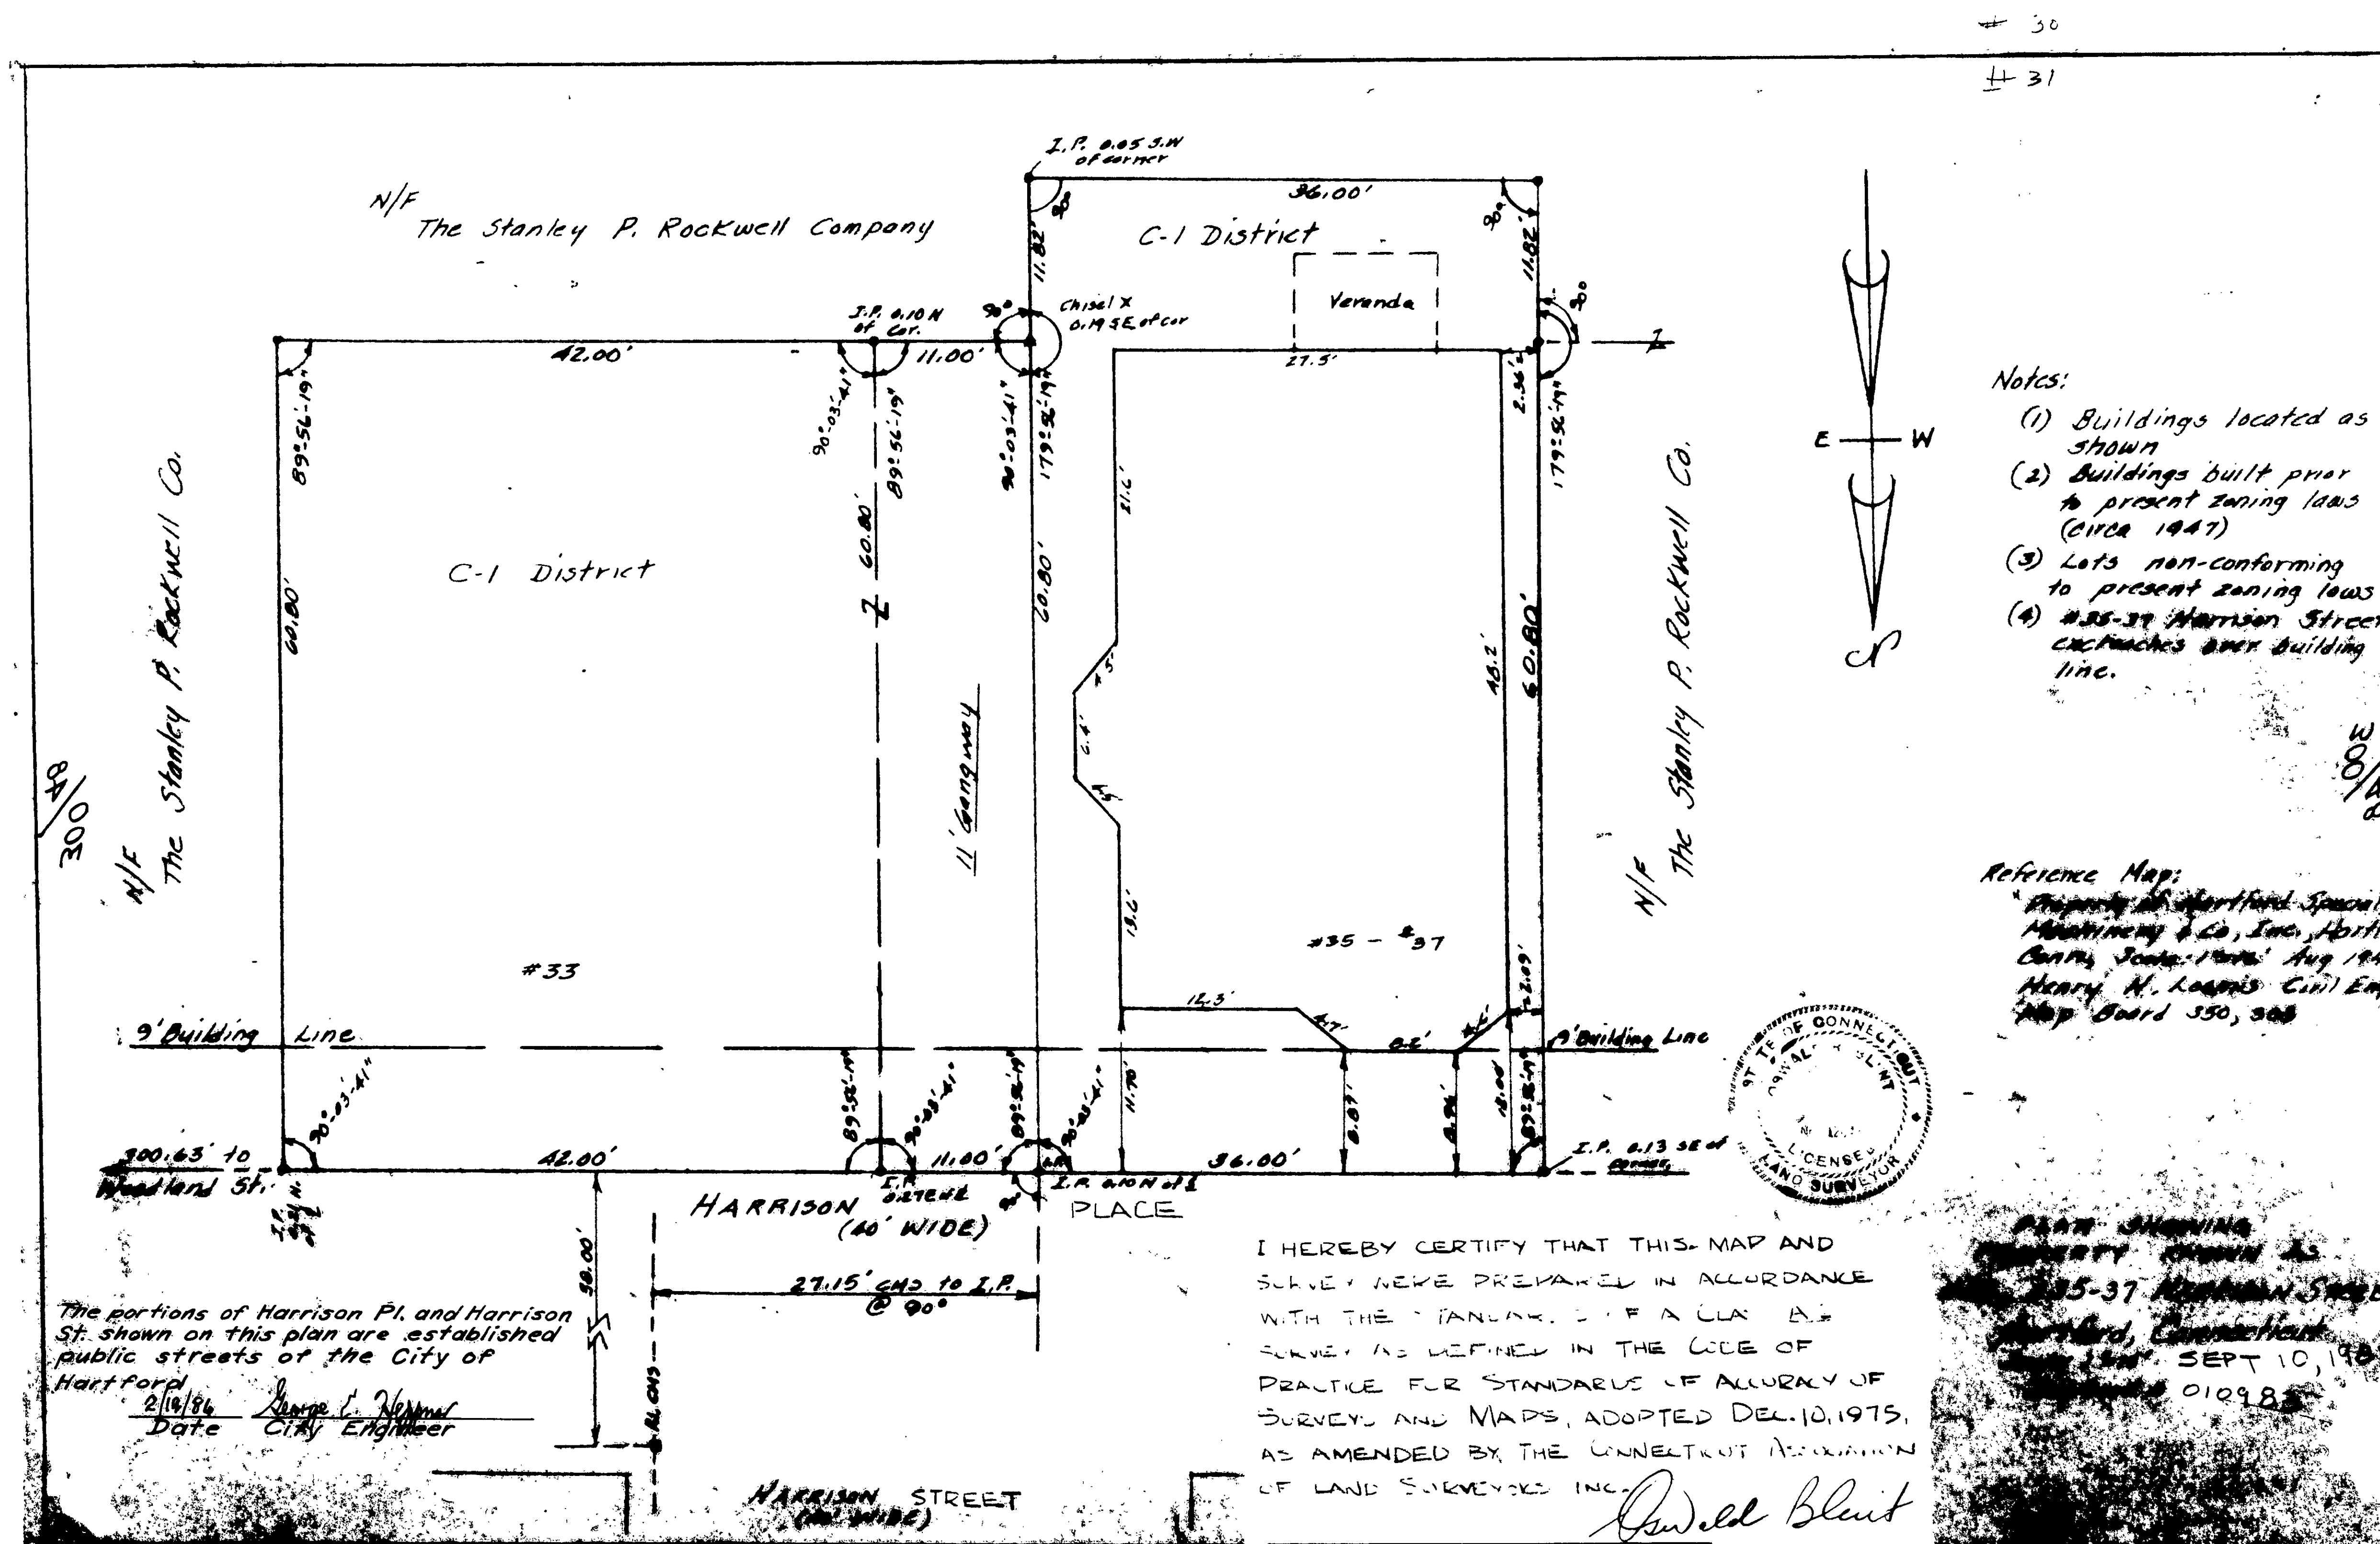

1504

85-

