



1504-1

EAST FILE CORP. WYHME CA	EPH 94
1504	

MORTGAGE SURVEY (CLASS A-2)
For
DEOWRAJ BUDDHU & URMILA BUDDHU
HARTFORD, CONNECTICUT
Feb., 1986

958-960 BROAD STREET
SCALE: 1"=20'
Zone: R-2
B.L.=10'
V.L.=4'
S.Y.=5', 15' total*
R.Y.=30'
Lot Width=50'
Lot Area=6,000 s.f. *

Note: *Non-conforming to present zoning
(House & lot pre-exists present zoning)

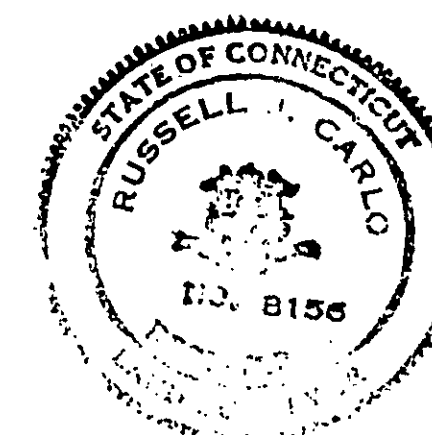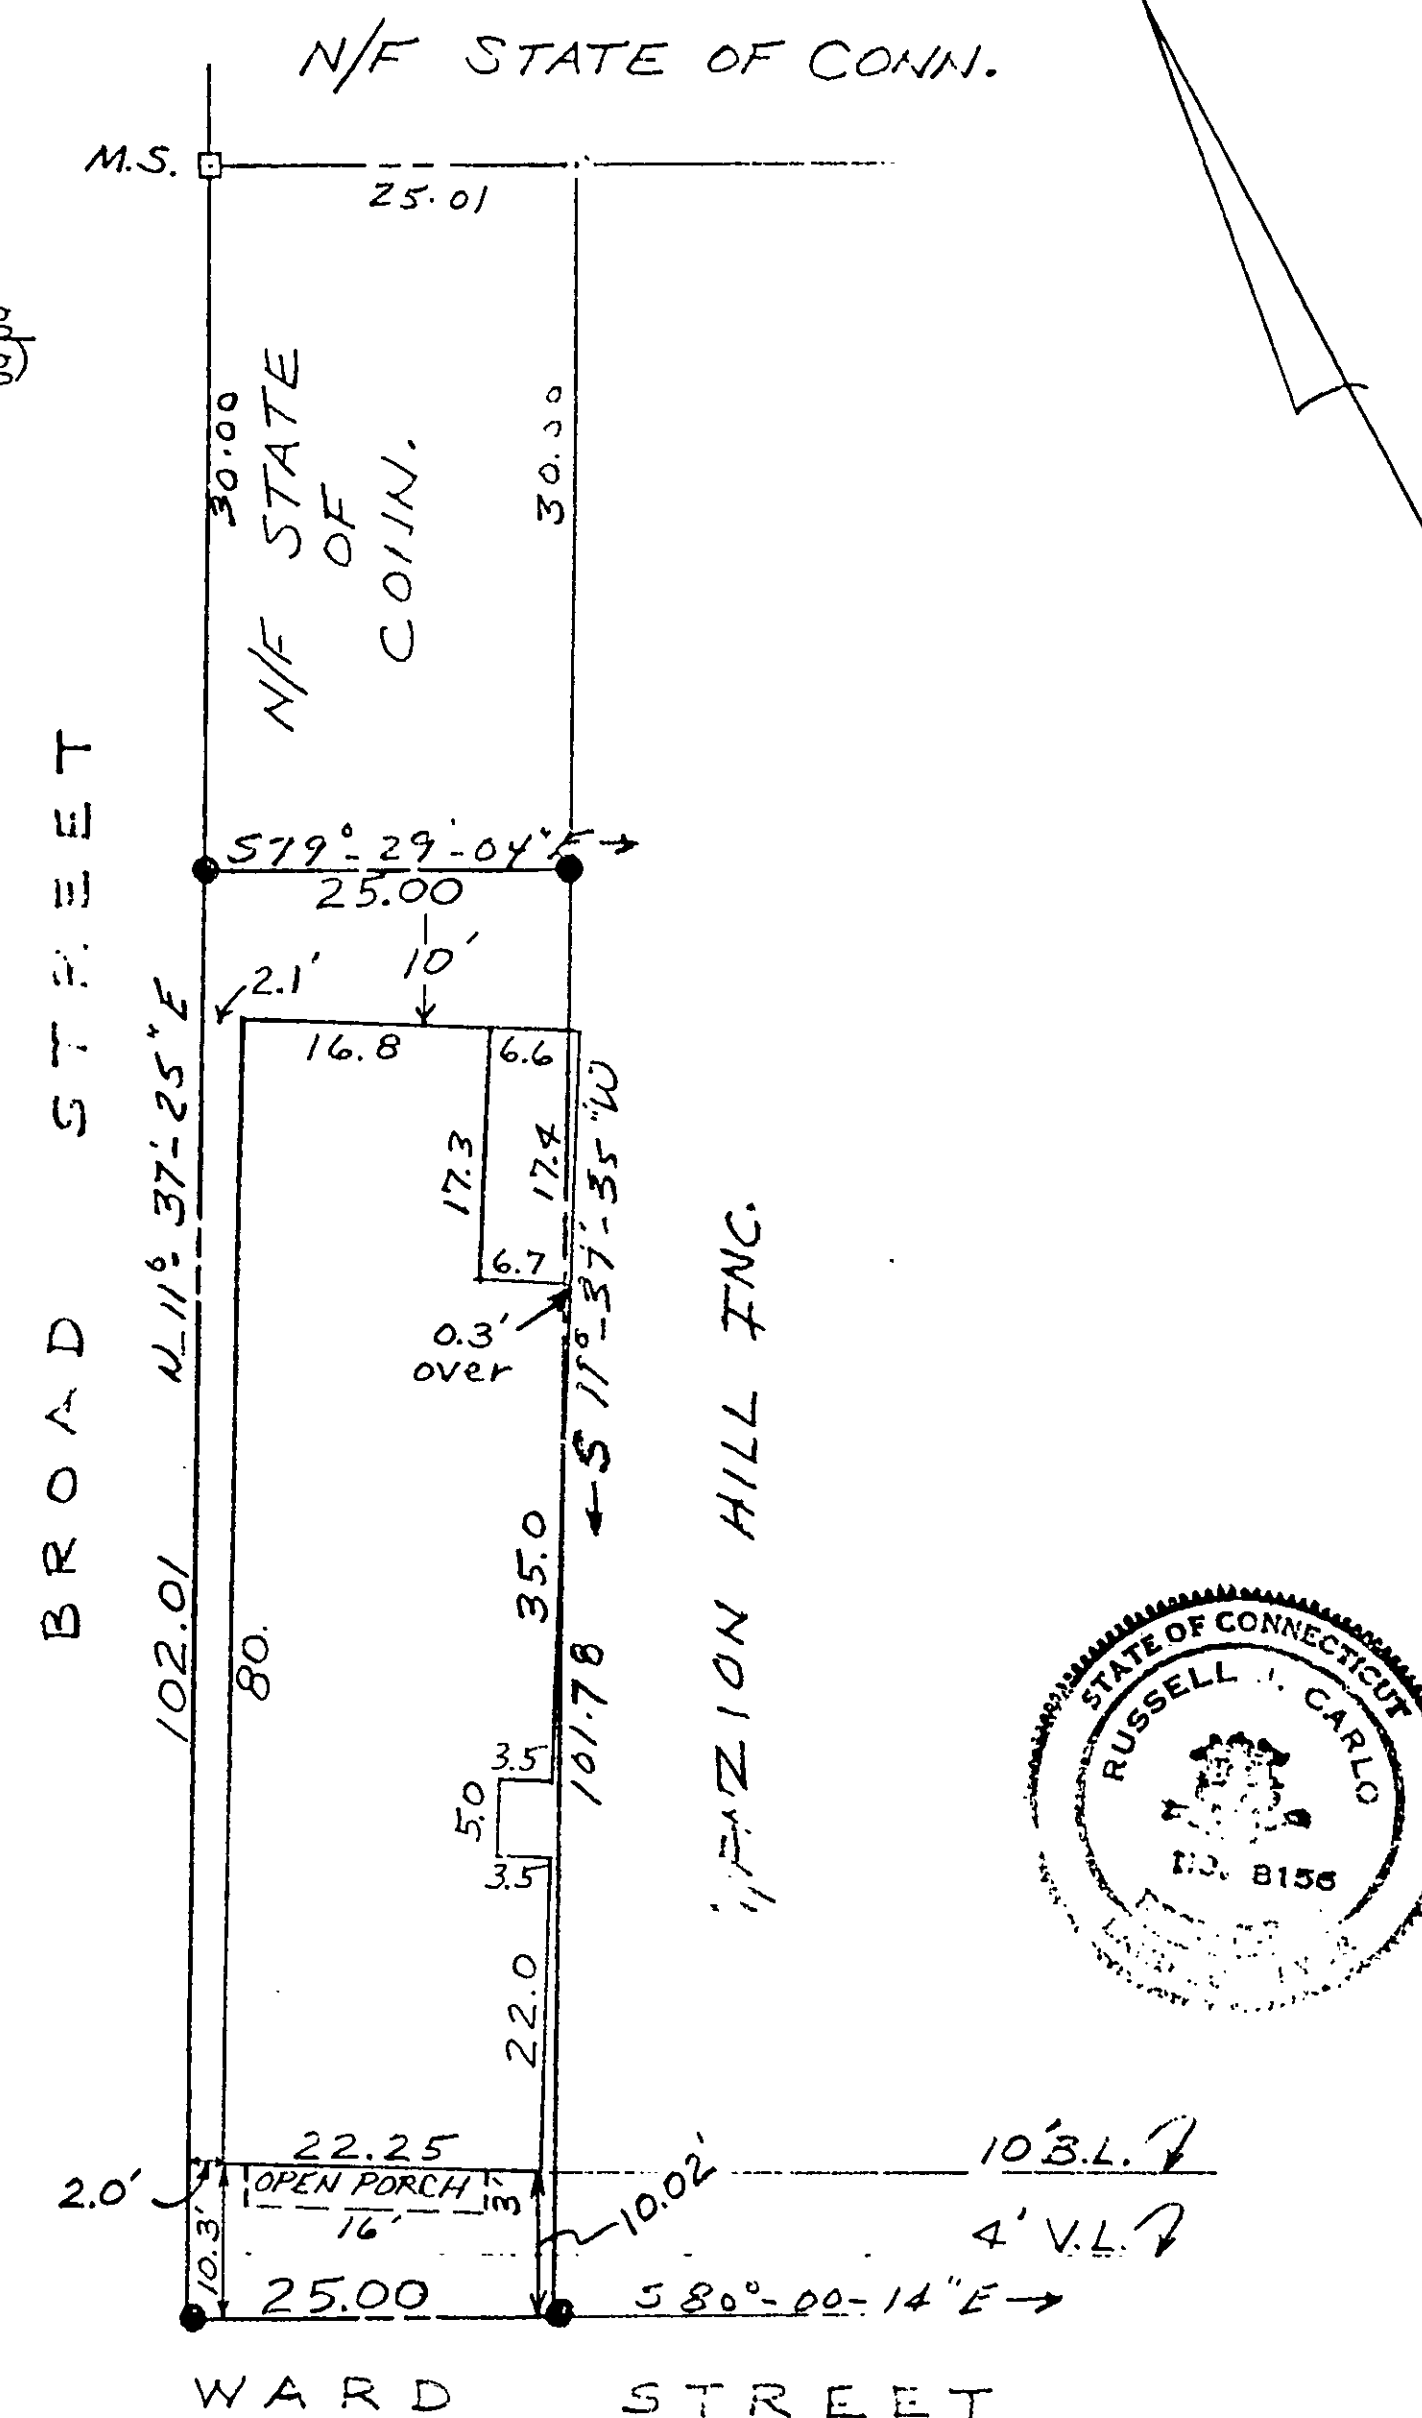

I HEREBY CERTIFY TO: THE BANK OF HARTFORD, INC. sa & AMERICAN TITLE INSURANCE COMPANY THAT THIS MAP IS SUBSTANTIALLY CORRECT, THE STRUCTURE IS LOCATED AS SHOWN, AND UNLESS OTHERWISE NOTED, (SEE NOTE) DOES NOT VIOLATE THE ZONING REGULATIONS OF THE CITY OF HARTFORD, CONNECTICUT.

The portions of Ward St. and Broad St. shown on this plan are established public streets of the City of Hartford

3/6/86
Date

George E. Hopper
City Engineer

RUSSELL J. CARLO, L.S. #8156
Registered Land Surveyor

89 1504

