


1510-1

EAS: FILE CORP. IRVINE, CA		EPH 14
1510		

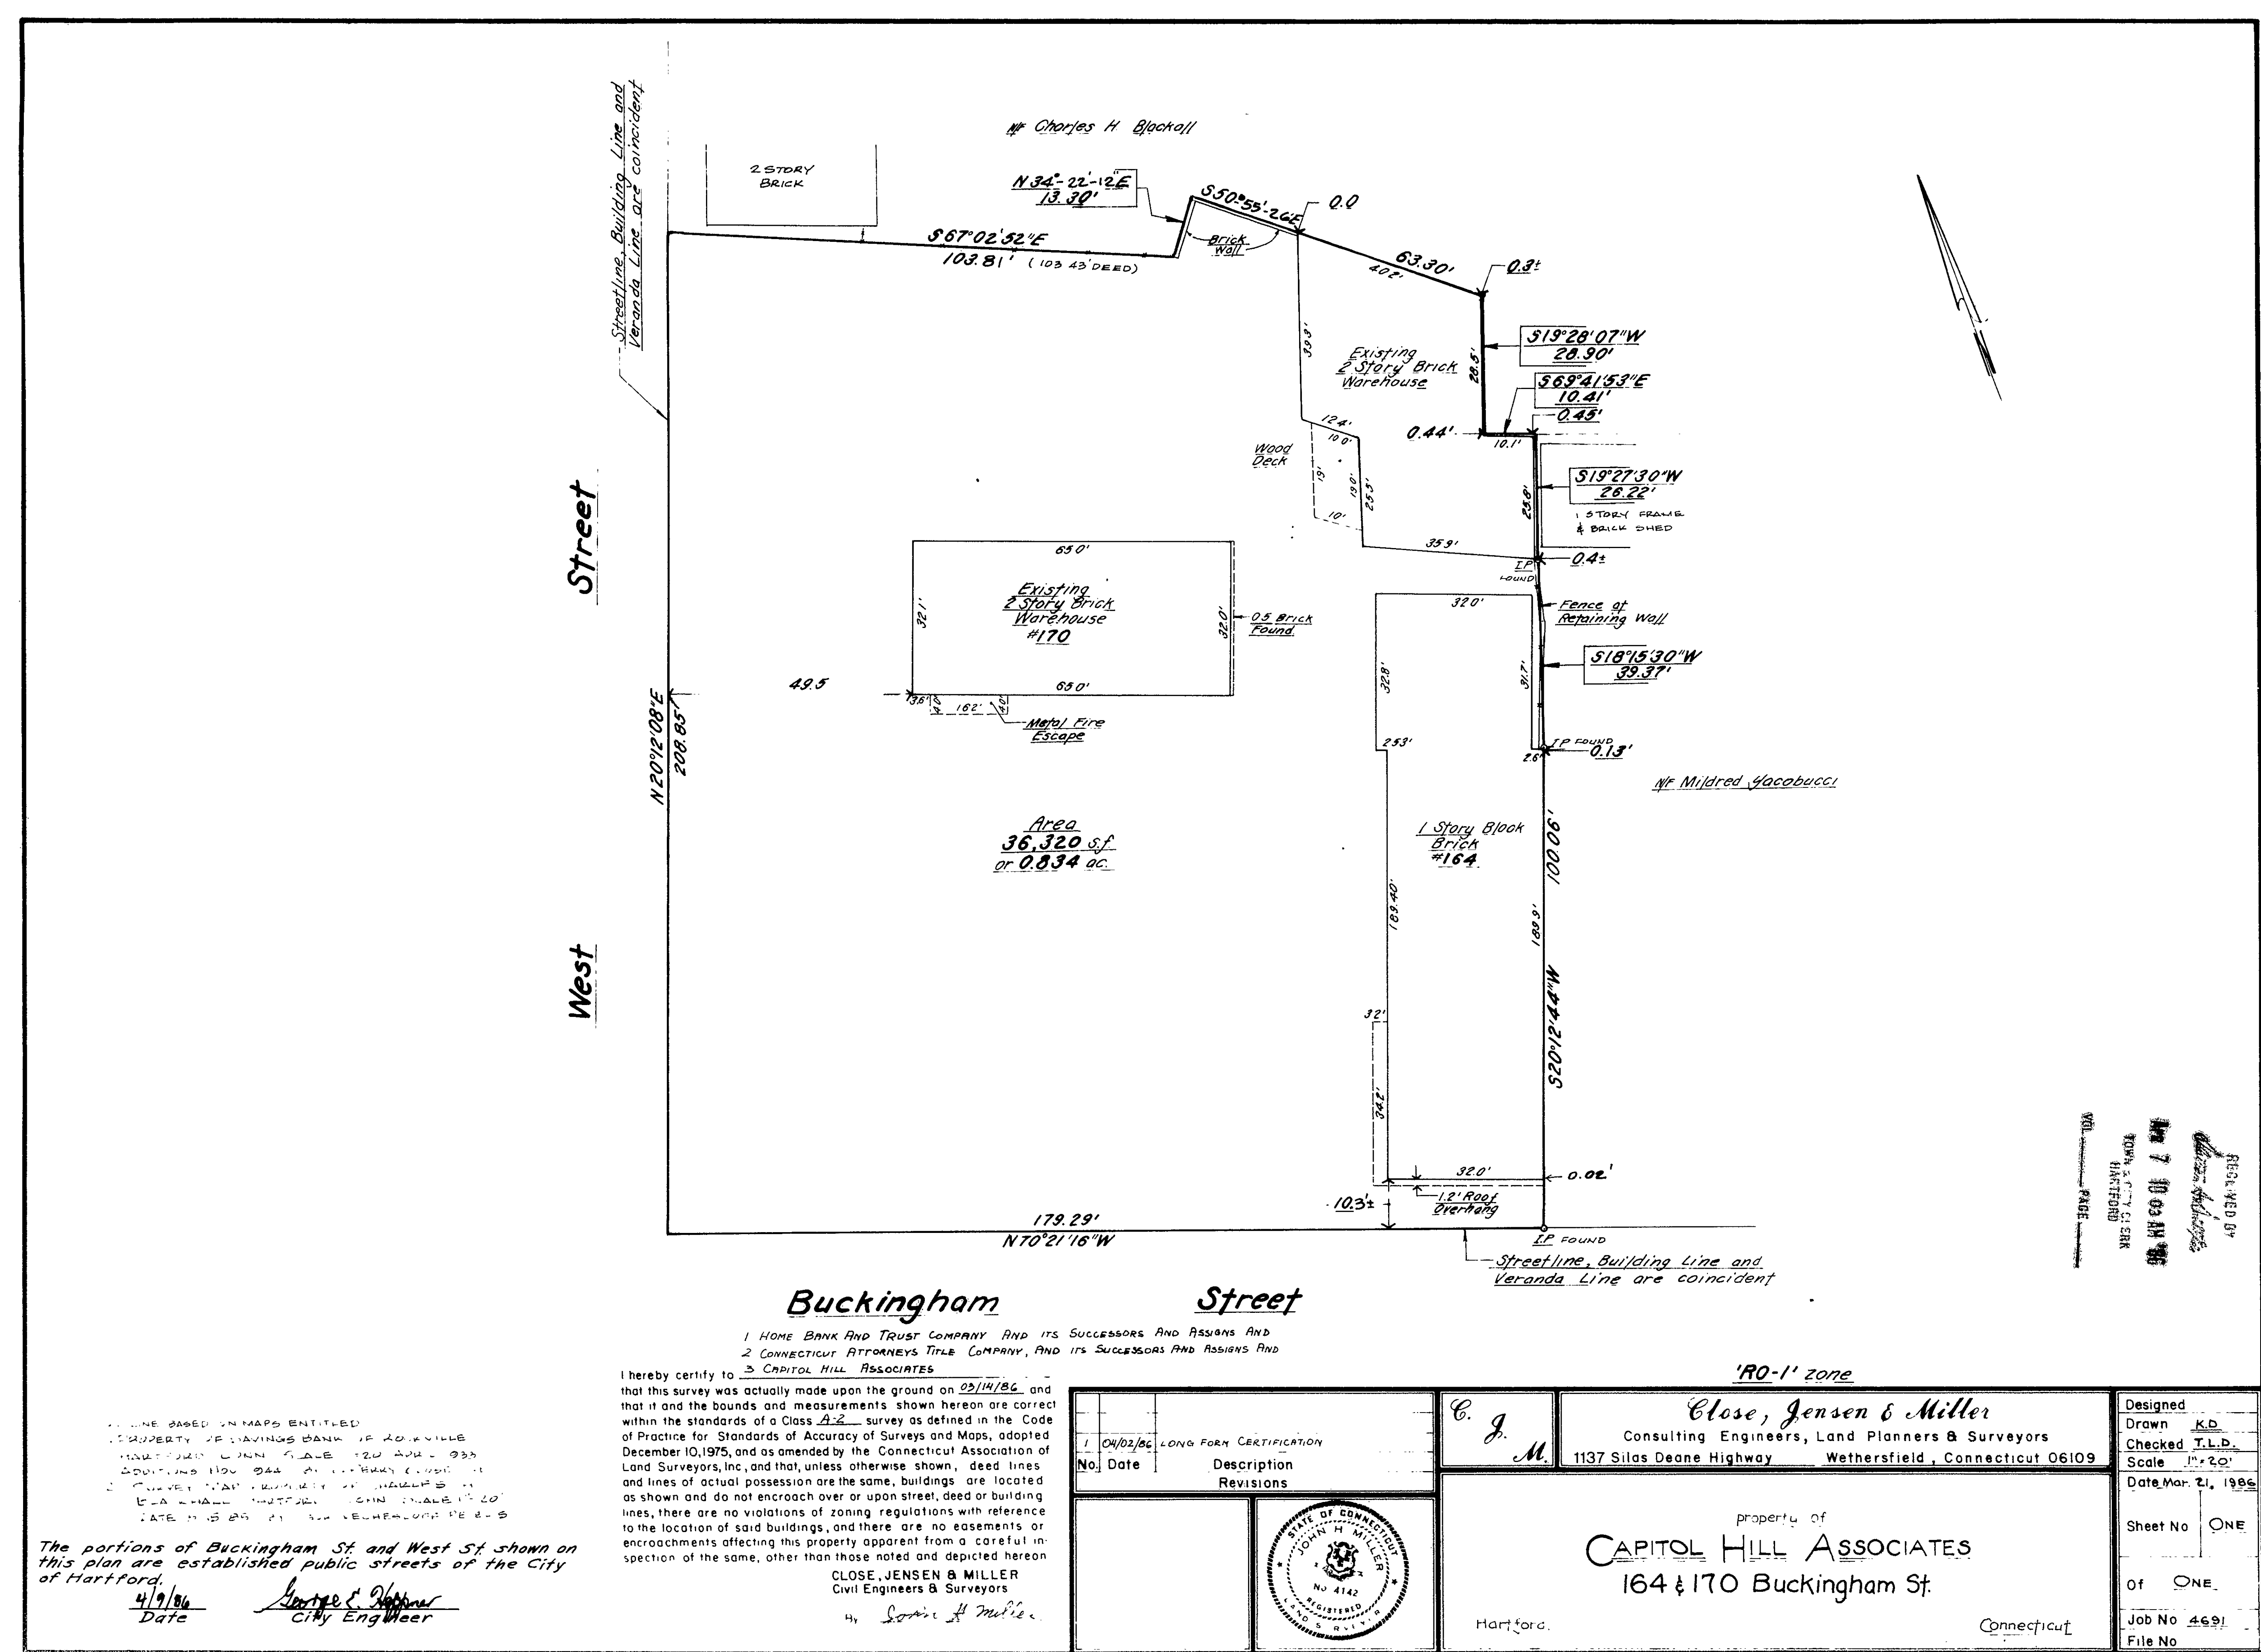



The portions of Buckingham St and West St shown on this plan are established public streets of the City of Hartford.
4/9/86 Date
George C. Miller City Engineer

I hereby certify to
1 HOME BANK AND TRUST COMPANY AND ITS SUCCESSORS AND ASSIGNS AND
2 CONNECTICUT ATTORNEYS TITLE COMPANY, AND ITS SUCCESSORS AND ASSIGNS AND
3 CAPITOL HILL ASSOCIATES
that this survey was actually made upon the ground on 05/14/86, and that it and the bounds and measurements shown hereon are correct within the standards of a Class A-2 survey as defined in the Code of Practice for Standards of Accuracy of Surveys and Maps, adopted December 10, 1975, and as amended by the Connecticut Association of Land Surveyors, Inc. and that, unless otherwise shown, deed lines and lines of actual possession are the same, buildings are located as shown and do not encroach over or upon street, deed or building lines, there are no violations of zoning regulations with reference to the location of said buildings, and there are no easements or encroachments affecting this property apparent from a careful inspection of the same, other than those noted and depicted hereon.
CLOSE, JENSEN & MILLER
Civil Engineers & Surveyors
4. Susan H. Miller

LONG FORM CERTIFICATION	
No.	Date
1	04/02/86
Description	
Revisions	

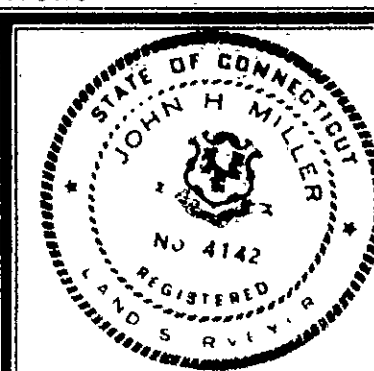

C. J. M.	
Close, Jensen & Miller Consulting Engineers, Land Planners & Surveyors 1137 Silas Deane Highway Wethersfield, Connecticut 06109	
property of CAPITOL HILL ASSOCIATES 164 & 170 Buckingham St. Hartford, Connecticut	

Designed	
Drawn	K.D.
Checked	T.L.B.
Scale	1"=20'
Date	Mar. 21, 1986
Sheet No.	ONE
Of	ONE
Job No.	4691
File No.	

