
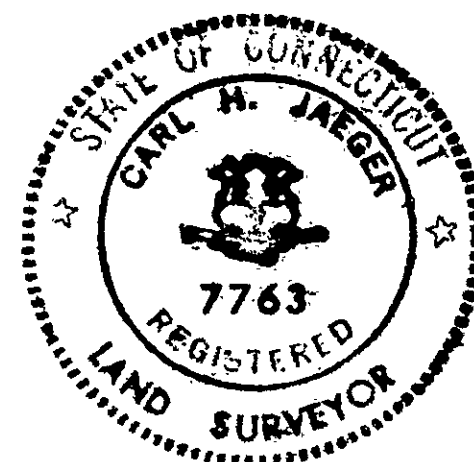


1513-1

EASI FILE CORP. IRVINE CA EPH 14	
1513	

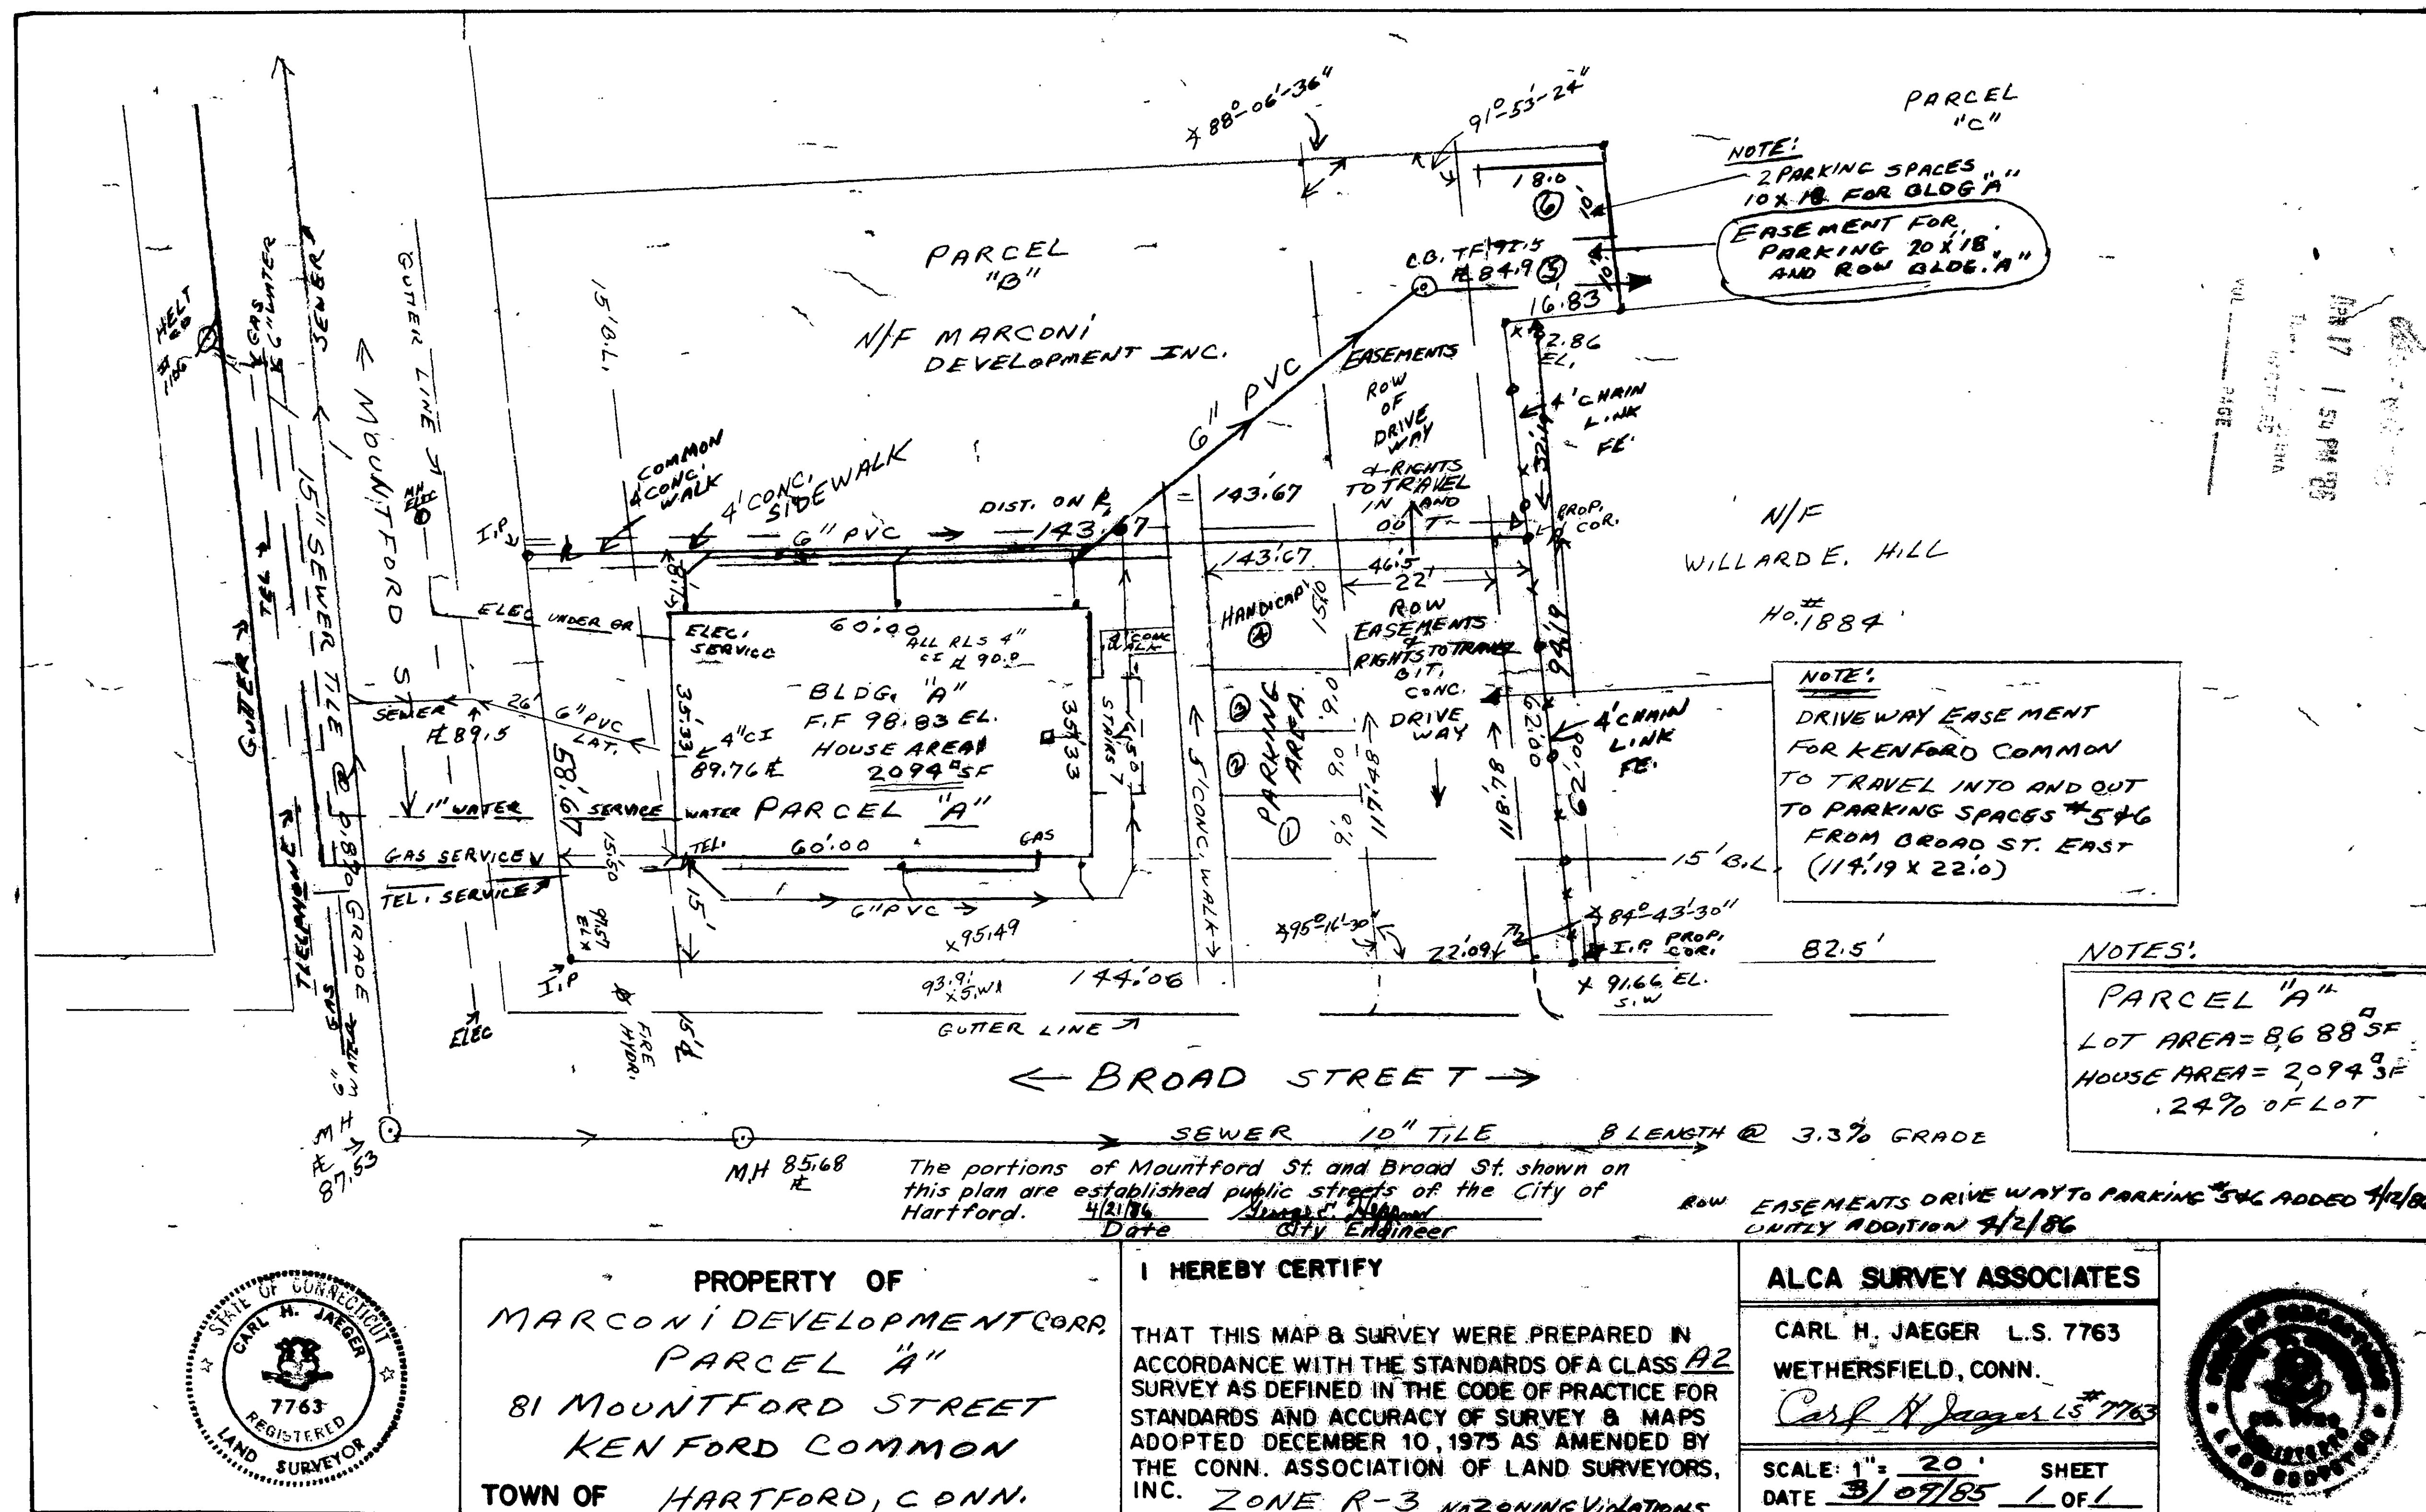

0 INCHES 1 2 3 4

plan size 12x18