



1514-1

EAST FILE COMP IRVINE, CA	EPH 74
1514	

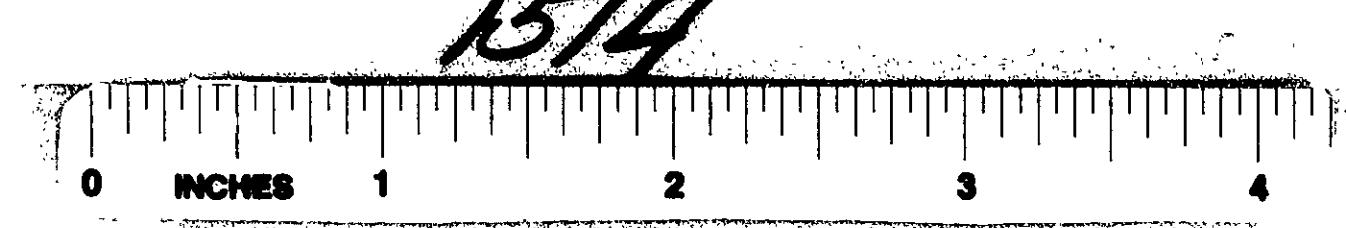

C. J. Miller Consulting Engineers, Land Planners & Surveyors 449 Siles-Denbe Highway, Waterfield, Connecticut 06097	
No.	Date
Revisions	1
<p style="text-align: center;">Scale: <u>1" = 30'</u></p>	
Sheet No.	One
Or	One
Job No.	1514
File No. S 1860	

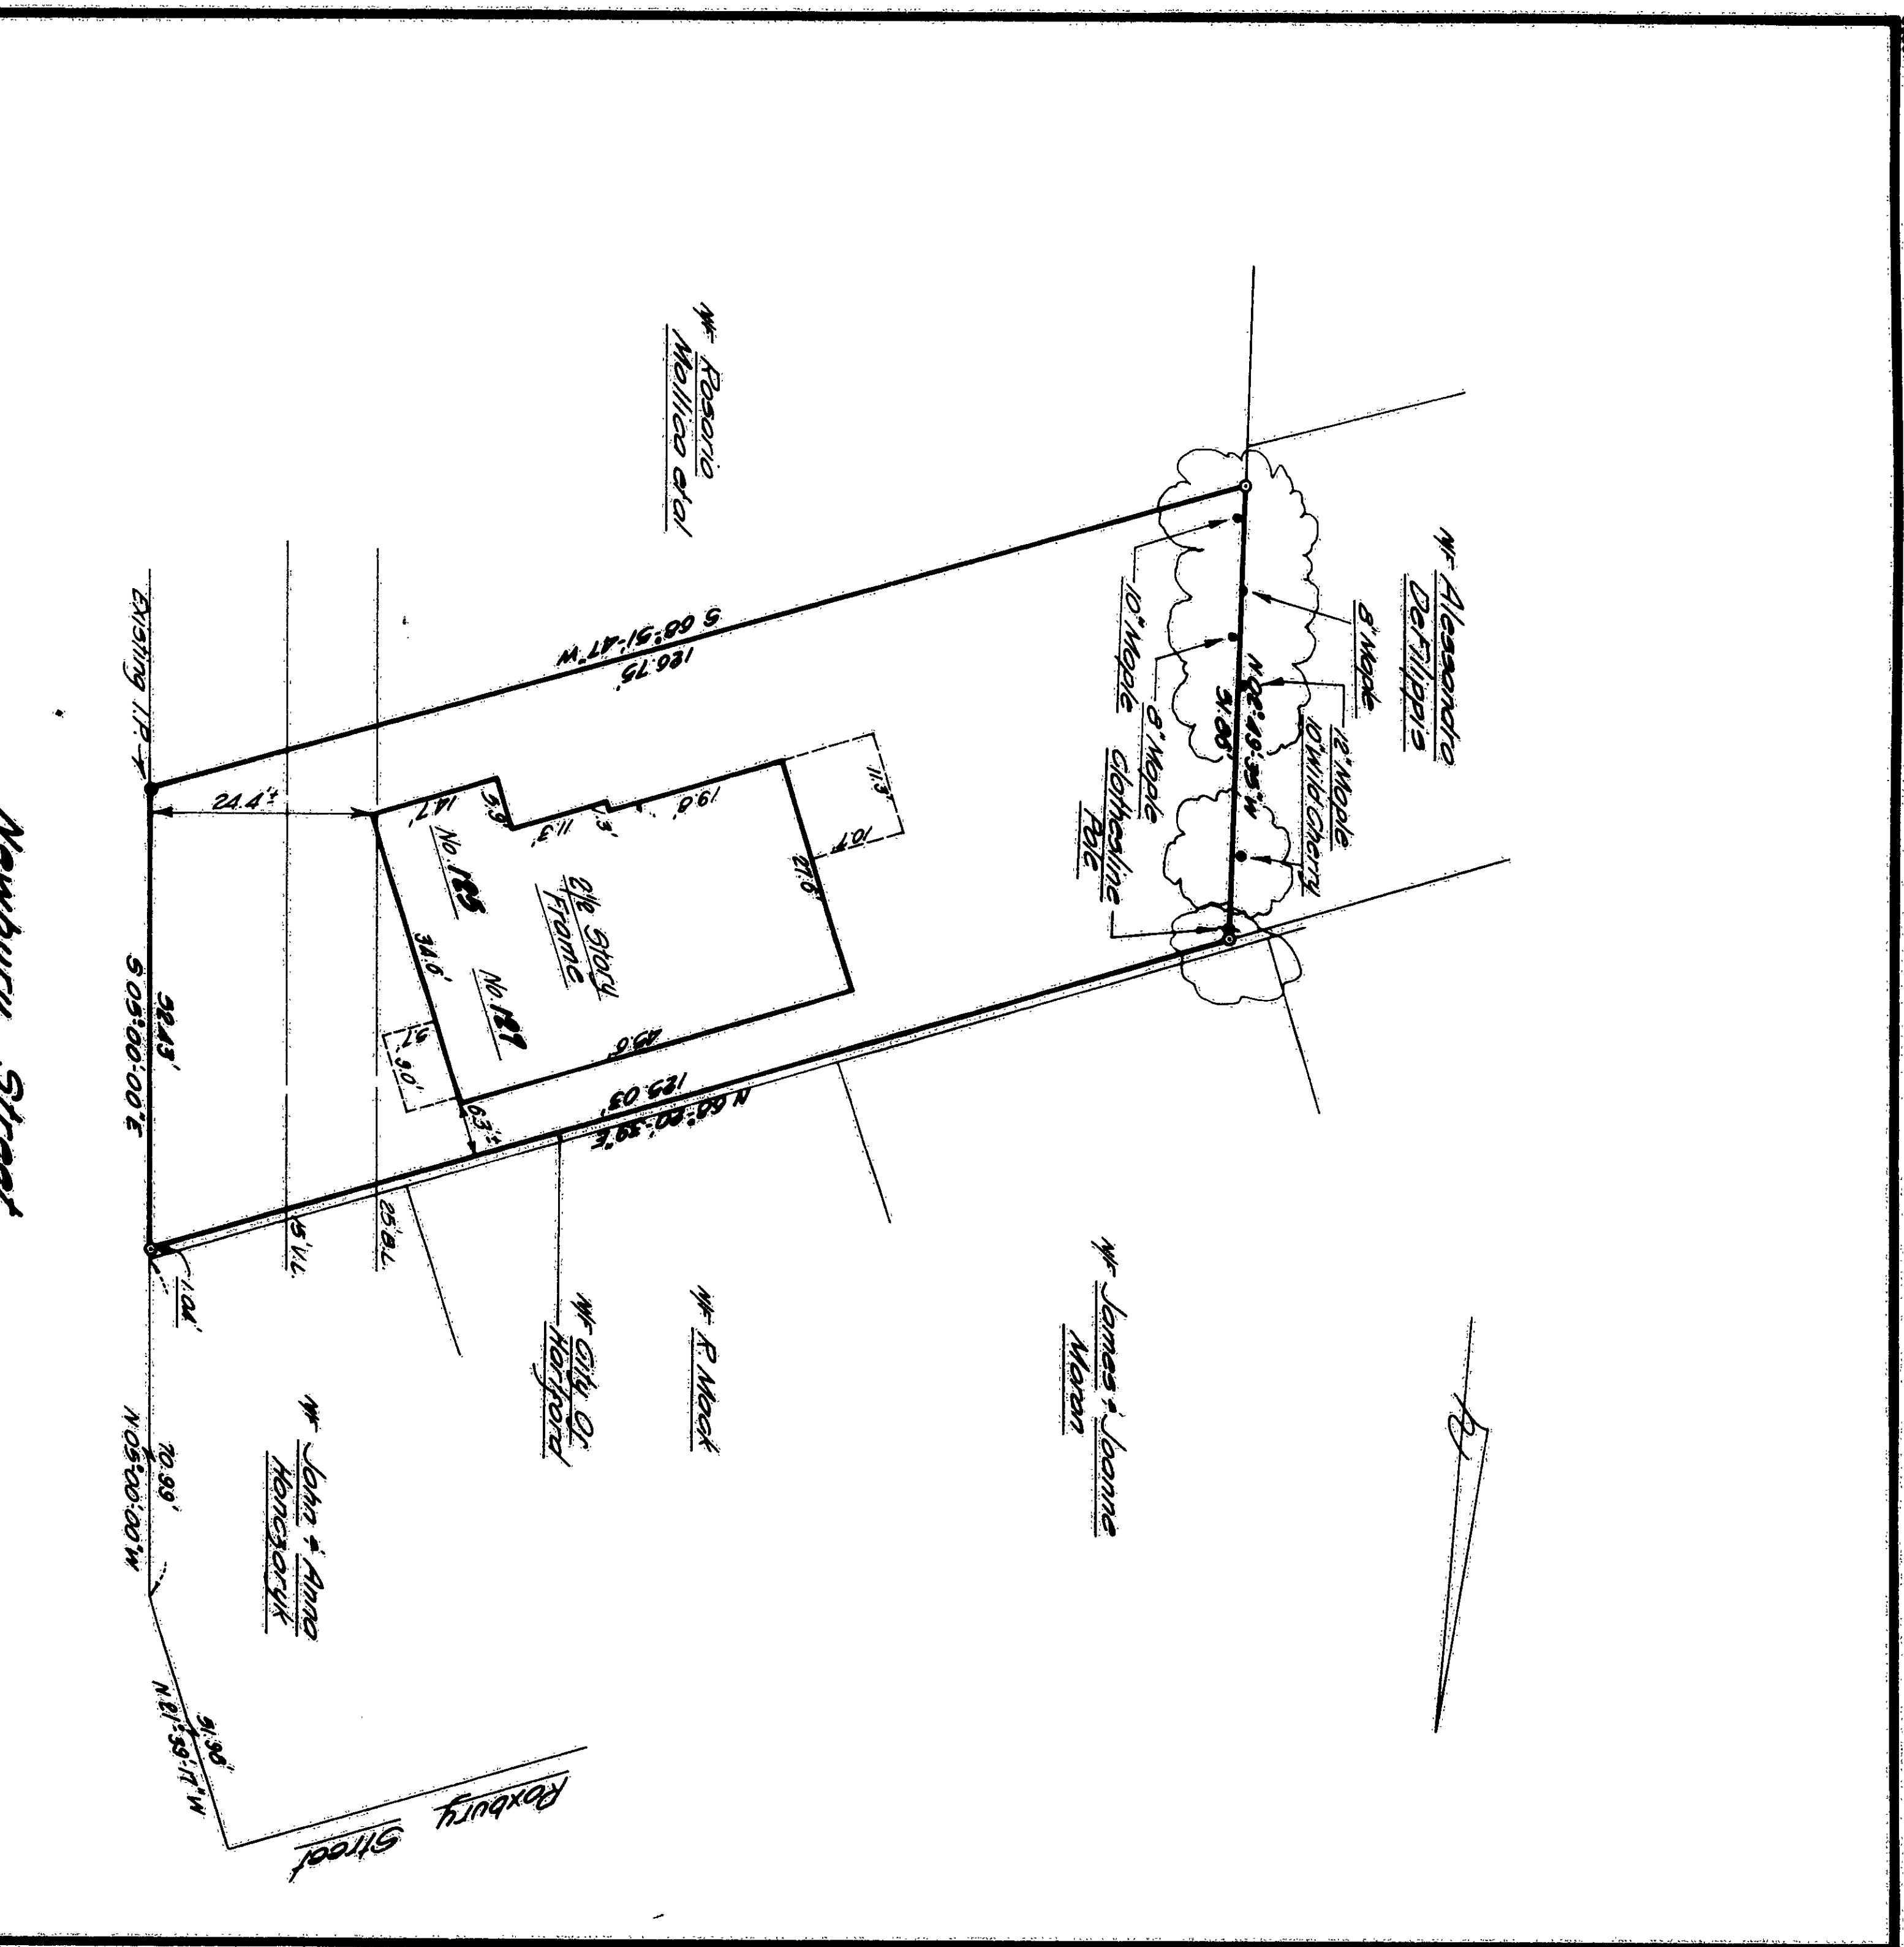


No. 4142  
OFFICE OF THE STATE SURVEYOR

The portion of Roxbury St. and Newbury St. shown on this plan are established  
as public streets of the City of Hartford.  
4/21/86  
George J. Miller,  
City Engineer  
  
I hereby certify that this map and survey were  
prepared in accordance with the standards of a  
Class A<sup>2</sup> survey as defined in the Code of Practice  
for Standards of Accuracy of Surveys and  
Maps, adopted December 10, 1975, and as  
amended by the Connecticut Association of  
Land Surveyors, Inc.  
  
CLOSE, JENSEN & MILLER  
Civil Engineers & Surveyors

By *John J. Miller*

*Note:*  
① Indicates Non-Plan Set  
Property is in R-2 Zone  
Lot Area - 8200 SF  
Building covers 80% of lot  
From Year Non-conforming  
Under Present Zoning

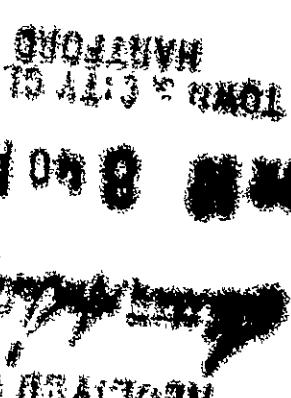

1514

1/01