


EASI FILE CORP IRVINE CA EPH 34  
**1536**

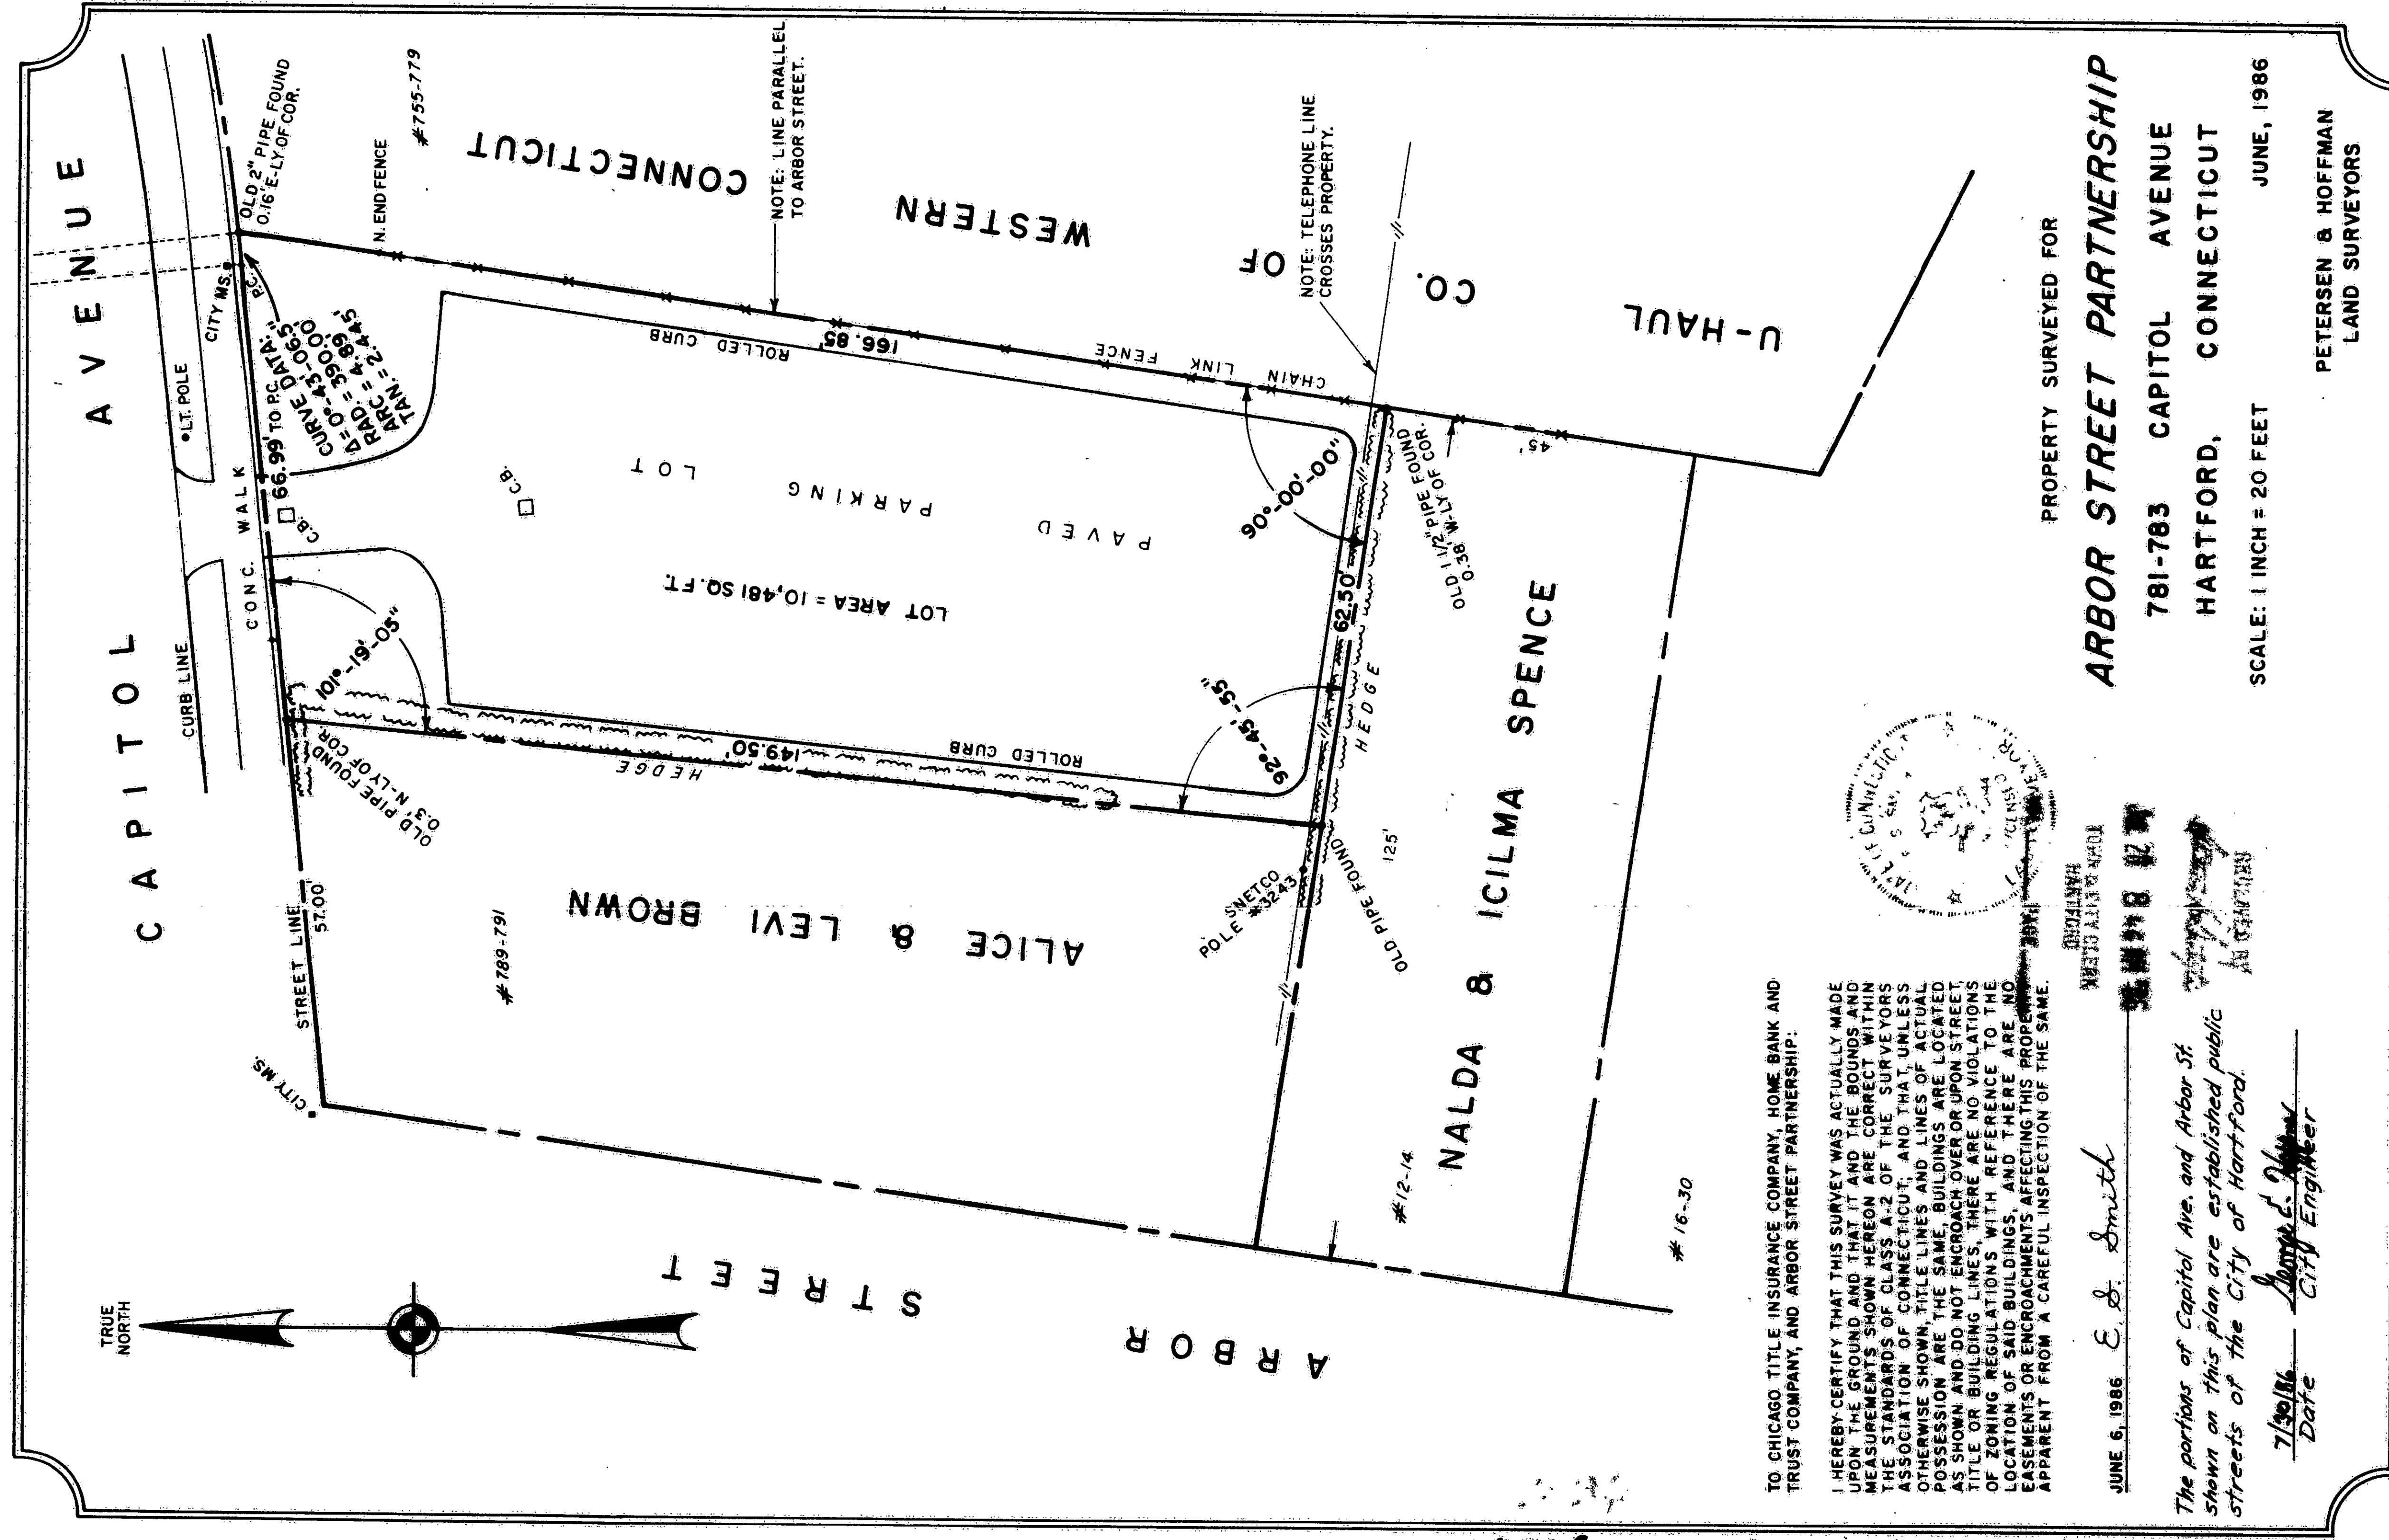

TO CHICAGO TITLE INSURANCE COMPANY, HOME BANK AND TRUST COMPANY, AND ARBOR STREET PARTNERSHIP:



JUNE 6, 1986 *E. J. Smith*  
E. J. Smith  
Surveyor


The portions of Capital Ave. and Arbor St. shown on this plan are established public streets of the City of Hartford.

Date *7/30/86* *Joseph E. Hoffman*  
City Engineer

PROPERTY SURVEYED FOR  
**ARBOR STREET PARTNERSHIP**  
781-783 CAPITOL AVENUE  
HARTFORD, CONNECTICUT

SCALE: 1 INCH = 20 FEET  
JUNE, 1986

PETERSEN & HOFFMAN  
LAND SURVEYORS

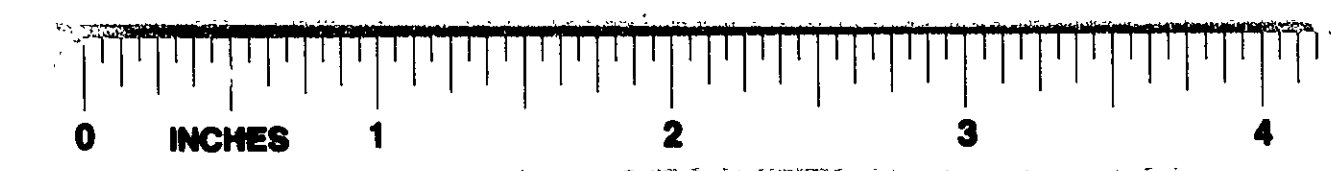

N.B. 6112-142 FEB 83-187

133