SURVEY FOR
PREPARED FOR
ALDERIC LE BLANC
JEANNE LE BLANC
68 HILLSIDE AVENUE
HARTFORD CONN.
SCALE 1" = 20'
AUGUST 22, 1986

NORTH

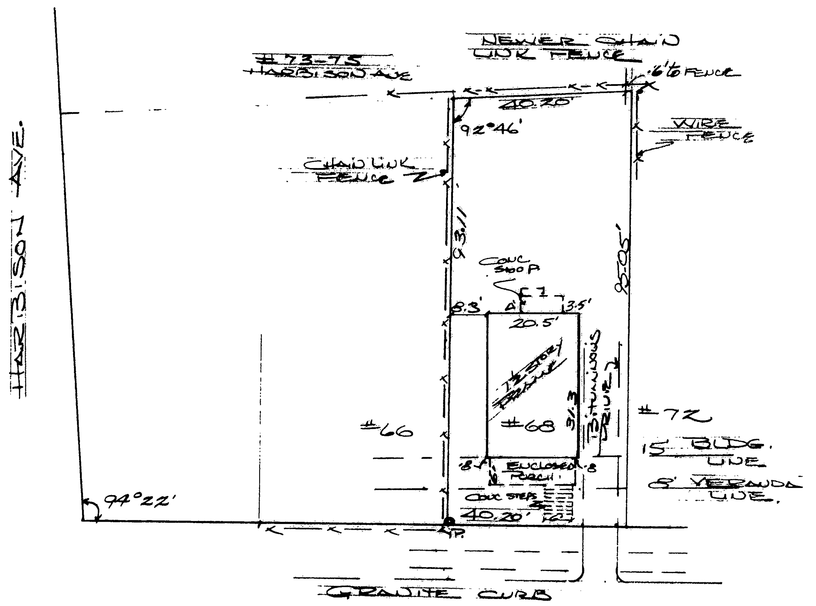

VOL 519
PAGE 264

ZONE R-4		LOT.
MIN WIDTH	50'	40.2'
MIN AREA	6000 SF	3782 SF
MIN SIDEYARD	5'	8.3'
TOTAL	15'	19.7
REAR YARD	30'	48'

I STATE ON THE BASIS OF MY KNOWLEDGE, INFORMATION AND BELIEF AS A PROFESSIONAL LAND SURVEYOR THAT THIS MAP WAS PREPARED IN ACCORDANCE WITH THE STANDARDS OF A CLASS A-2 SURVEY AS DEFINED IN THE CODE OF PRACTICE FOR STANDARDS OF ACCURACY OF SURVEYS AND MAPS. THAT THE BUILDING IS LOCATED AS SHOWN, THERE ARE NO VIOLATIONS OF ZONING REGULATIONS WITH REFERENCE TO LOCATION OF SAID BUILDING.

John Lawrence LS.

The portions of Hillside Ave. and Harbison Ave. shown on this plan are established public streets of the City of Hartford.

9/2/86 Date — George E. Wagner, City Engineer

JOHN LAWRENCE & ASSOC.
Engineers - Surveyors
486 Prospect Ave. Hartford, CT 06105
Phone 232-4740

1541

EAS FILE CORP IRVINE CA EFN 14

0 INCHES 1 2 3 4

4