


1541-1

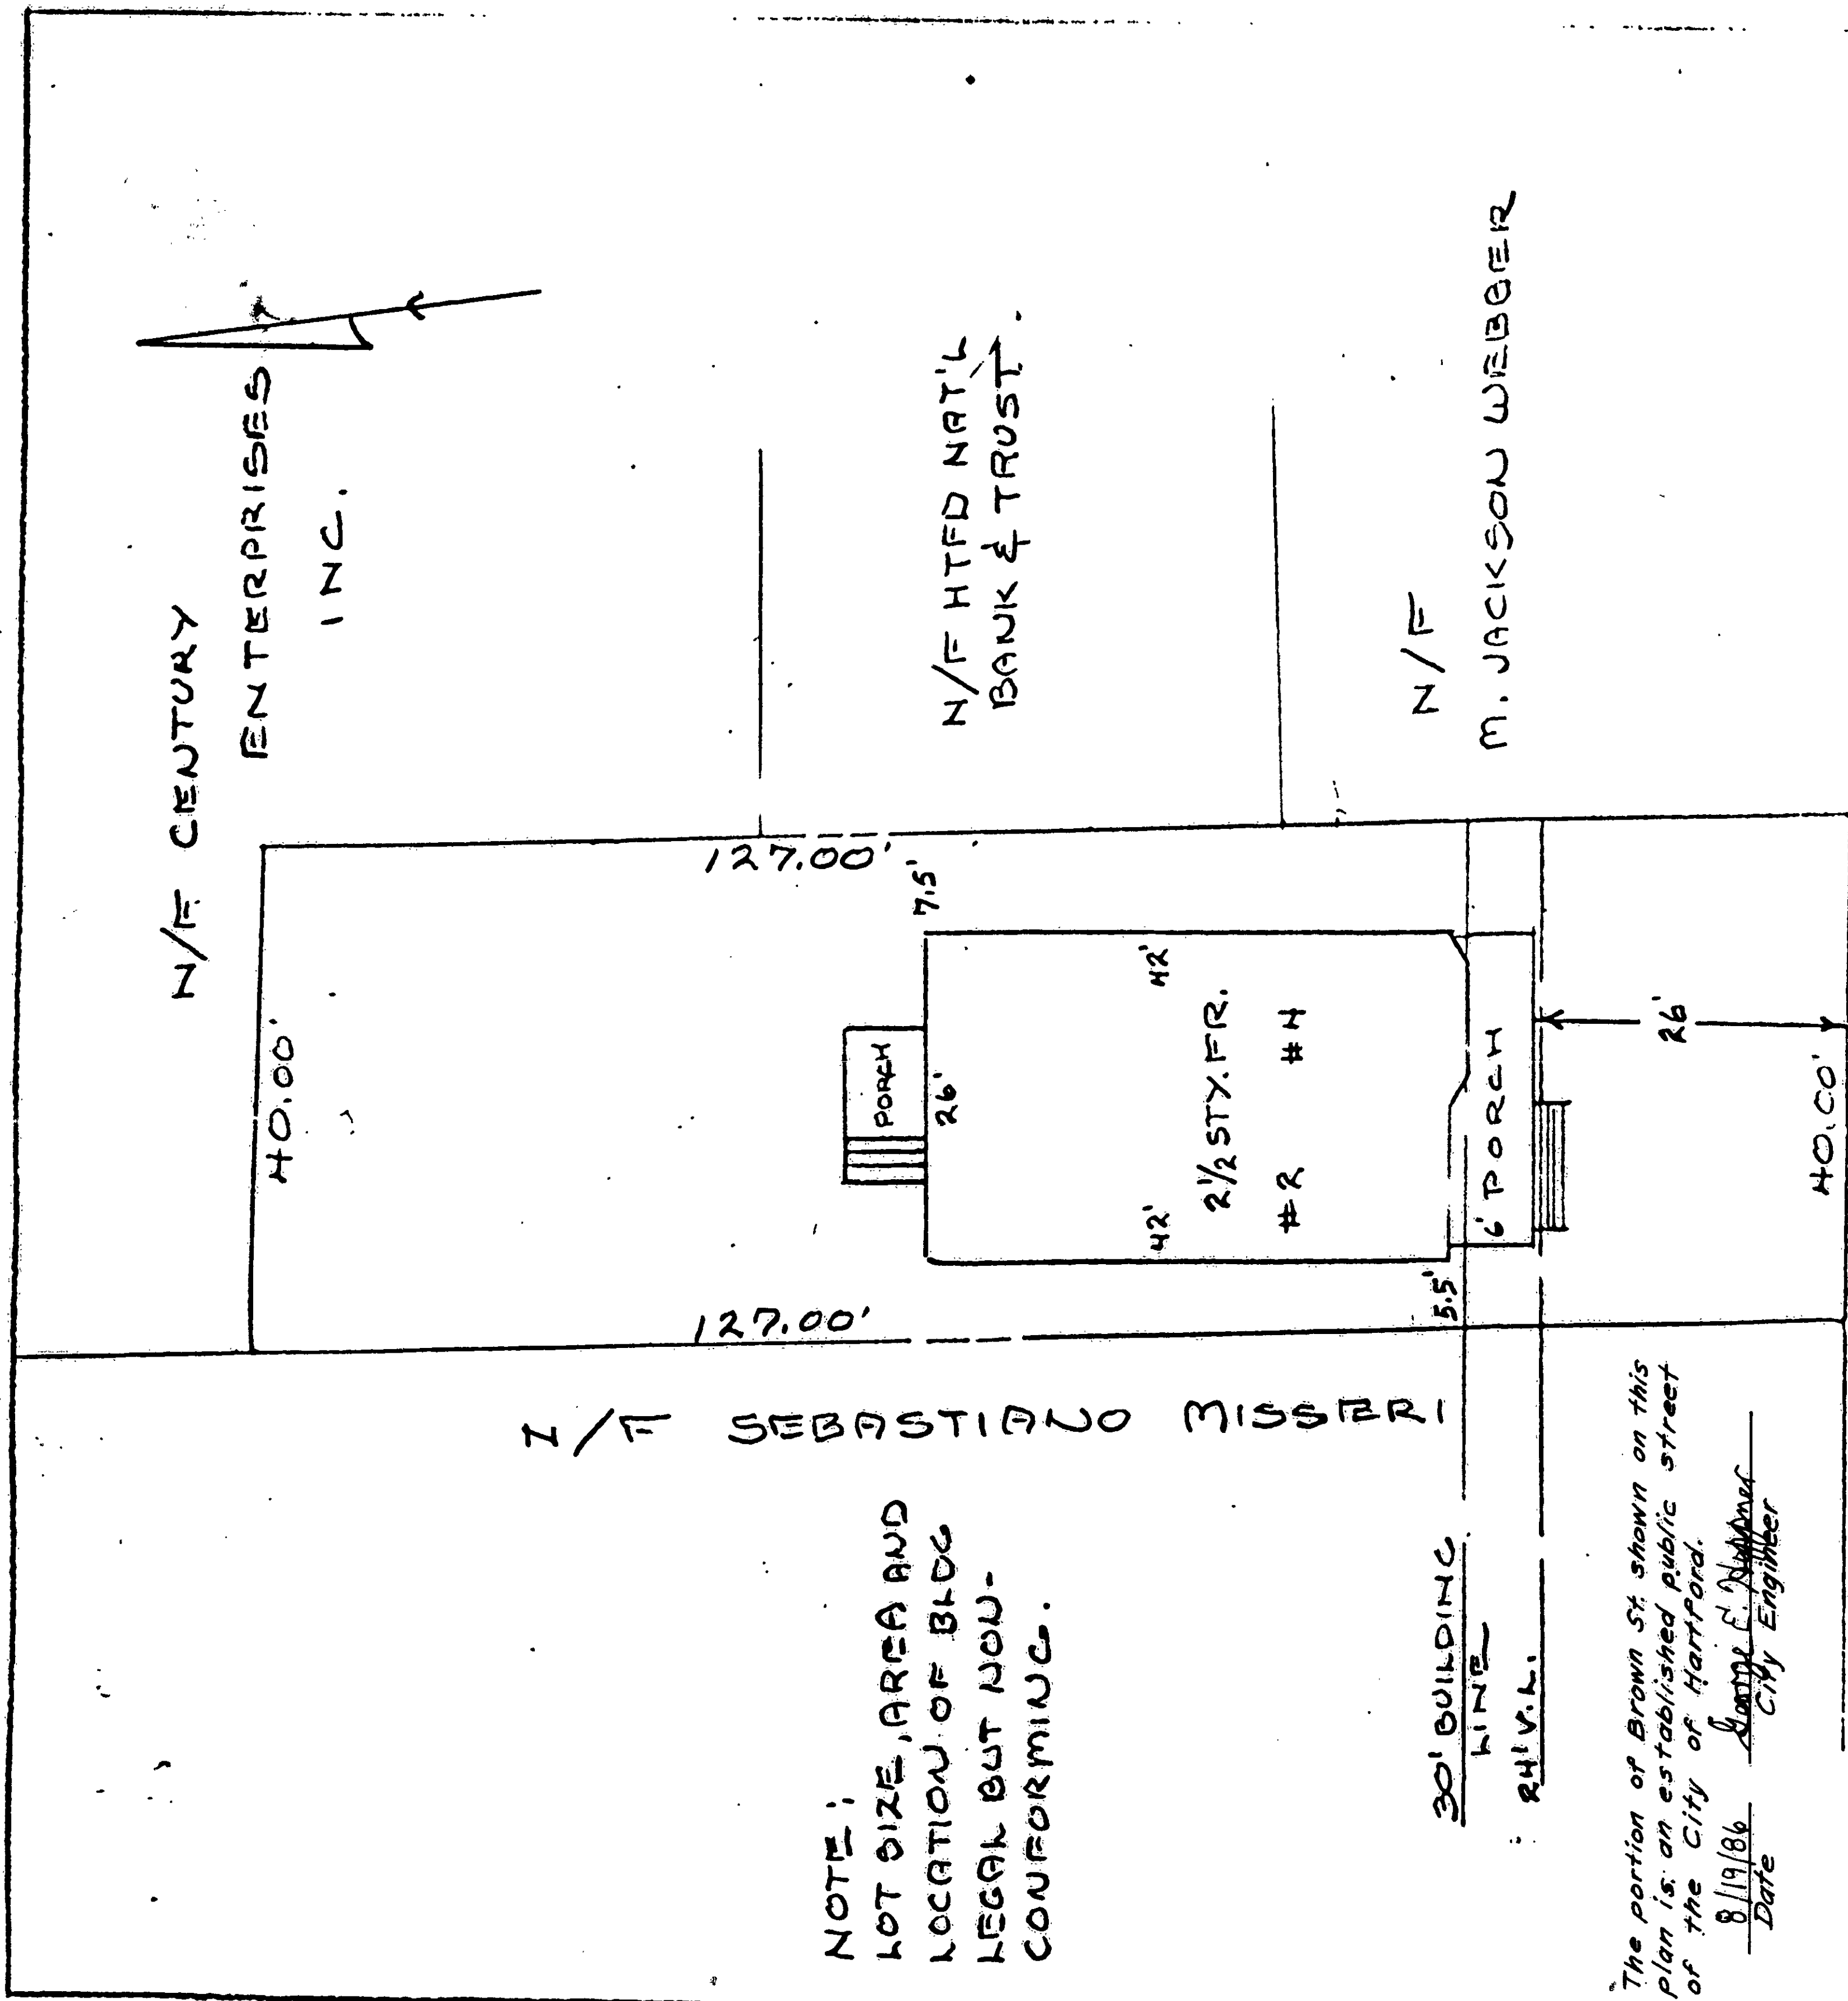

I HEREBY CERTIFY TO
CONNECTICUT NAT'L BANK & TRUST &
TICOR TITLE INSURANCE CO.
THIS PLAN IS SUBSTANTIALLY
CORRECT AND THE ZONING ORDINANCES
WITH REGARD TO LOT SIZE, LOT
DIMENSIONS AND LOCATION OF
STRUCTURES ARE NOT VIOLATED
Richard T. Tourville L.S. #8177
SURVEYOR
RICHARD T. TOURVILLE L.S.
24 WINDING LANE, AVON CT.
Richard T. Tourville L.S. #8177

MORTGAGE SURVEY
CITY OF HARTFORD
PLAN SHOWING PROPERTY
OF
M. JACKSON WEBBER &
ROBERT K. WEBBER
2-4 BROWN STREET
VOLUME 17, PAGE 20
SCALE 1" = 20'
JUL 15 12 58 PM '86
TOWN & CITY CLERK
HARTFORD
RECEIVED BY
Richard T. Tourville
L.S. #8177
6-30-83



1541