


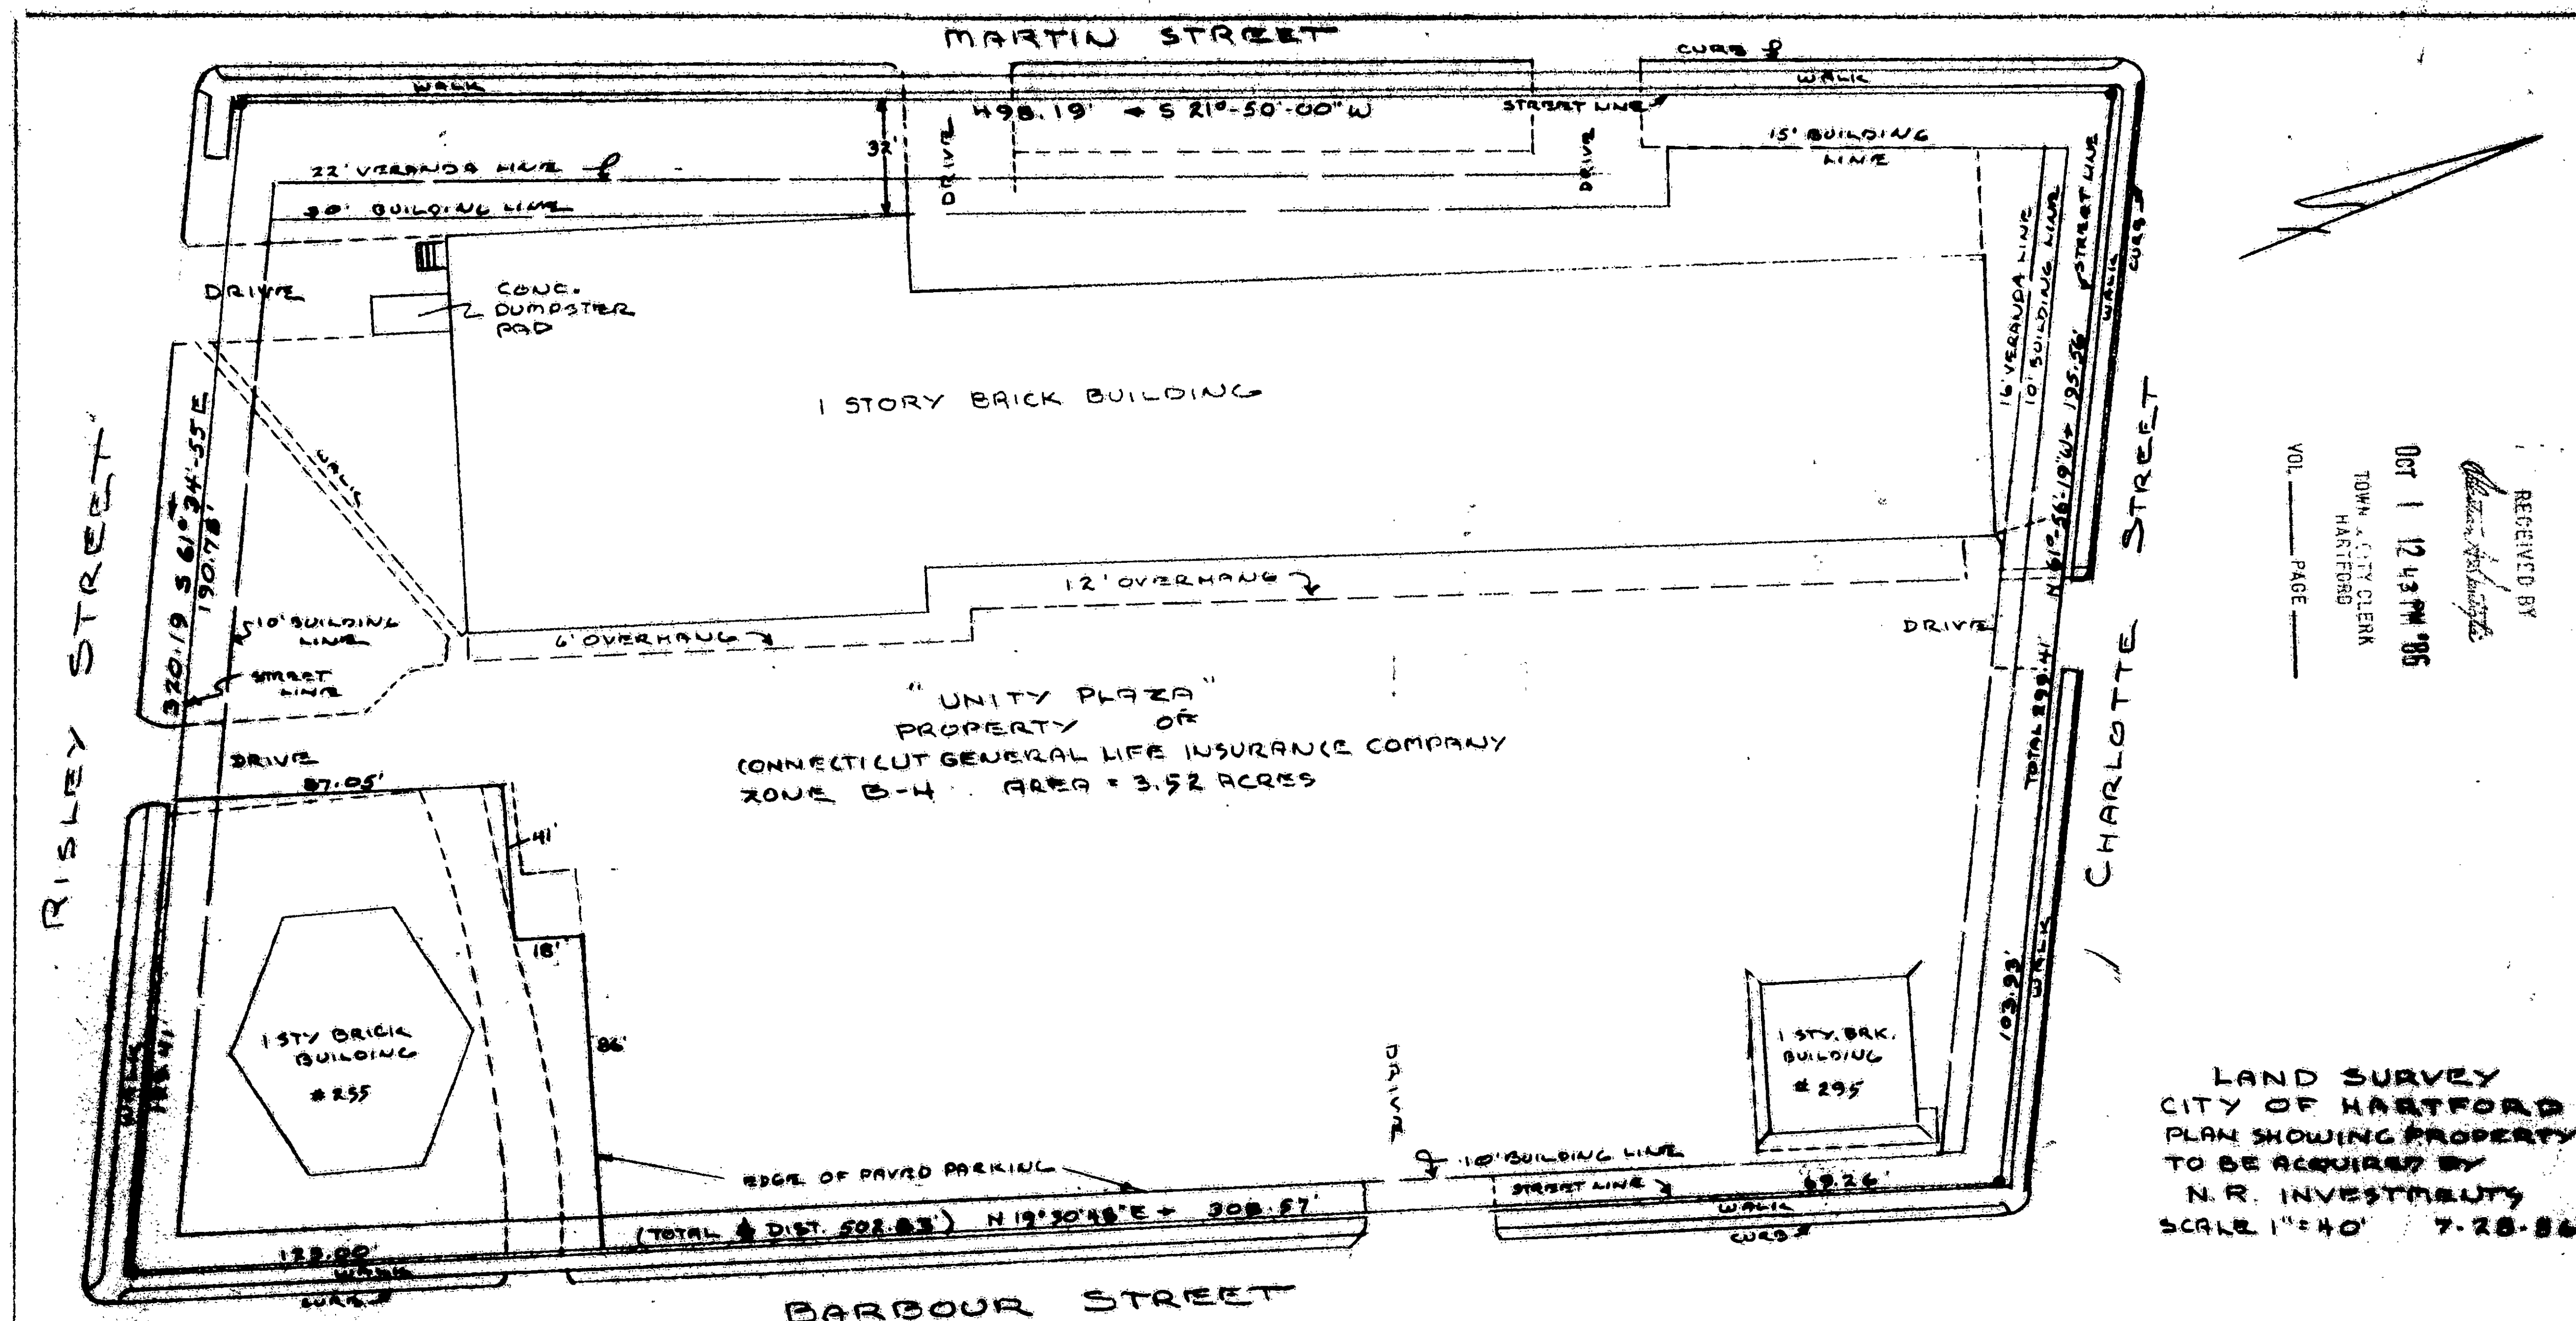

RECEIVED BY
 Oct 1 12 43 PM '86
 TOWN & CITY CLERK
 HARTFORD
 VOL. PAGE

LAND SURVEY
 CITY OF HARTFORD
 PLAN SHOWING PROPERTY
 TO BE ACQUIRED BY
 N.R. INVESTMENTS
 SCALE 1"=40' 7-28-86

HOME BANK AND TRUST COMPANY, N.R. INVESTMENT & SECURITY TITLE AND GUARANTY COMPANY
 THAT THIS SURVEY WAS ACTUALLY MADE UPON THE GROUND ON 7-28-86 AND THAT IT AND THE BOUNDS AND MEASUREMENTS
 SHOWN HEREON ARE CORRECT WITHIN THE STANDARD OF ACCURACY OF CLASS A-2 AS DEFINED IN THE CODE OF RECOMMENDED
 PRACTICE FOR STANDARDS OF ACCURACY OF SURVEYS AND MAPS ADOPTED DEC. 10, 1975 AS AMENDED BY THE CONNECTICUT
 ASSOCIATION OF LAND SURVEYORS, INC., AND THAT UNLESS OTHERWISE SHOWN TITLE LINES AND LINES OF ACTUAL
 POSSESSION ARE THE SAME. BUILDINGS ARE LOCATED AS SHOWN AND DO NOT ENCRUMBER OVER OR UPON STREETS;
 TITLE OR BUILDING LINES, THERE ARE NO VIOLATIONS OF ZONING REGULATIONS WITH RESPECT TO THE LOCATION
 AND OR SIZE OF BUILDINGS, THERE ARE NO EASEMENTS OR ENCROACHMENTS AFFECTING THIS PROPERTY
 APPARENT FROM A CAREFUL INSPECTION OF SAME OTHER THAN THOSE SHOWN ON THIS SURVEY.

Richard T. Tourville L.S. #8122 RICHARD T. TOURVILLE L.S., 24 WINDING LAKE AVENUE, CT. 06001



The portions of Risley St., Martin St.,
 Charlotte St. and Barbour St. shown
 on this plan are established public
 streets of the City of Hartford.

10/7/86 Date
 George F. [Signature] City Engineer

