


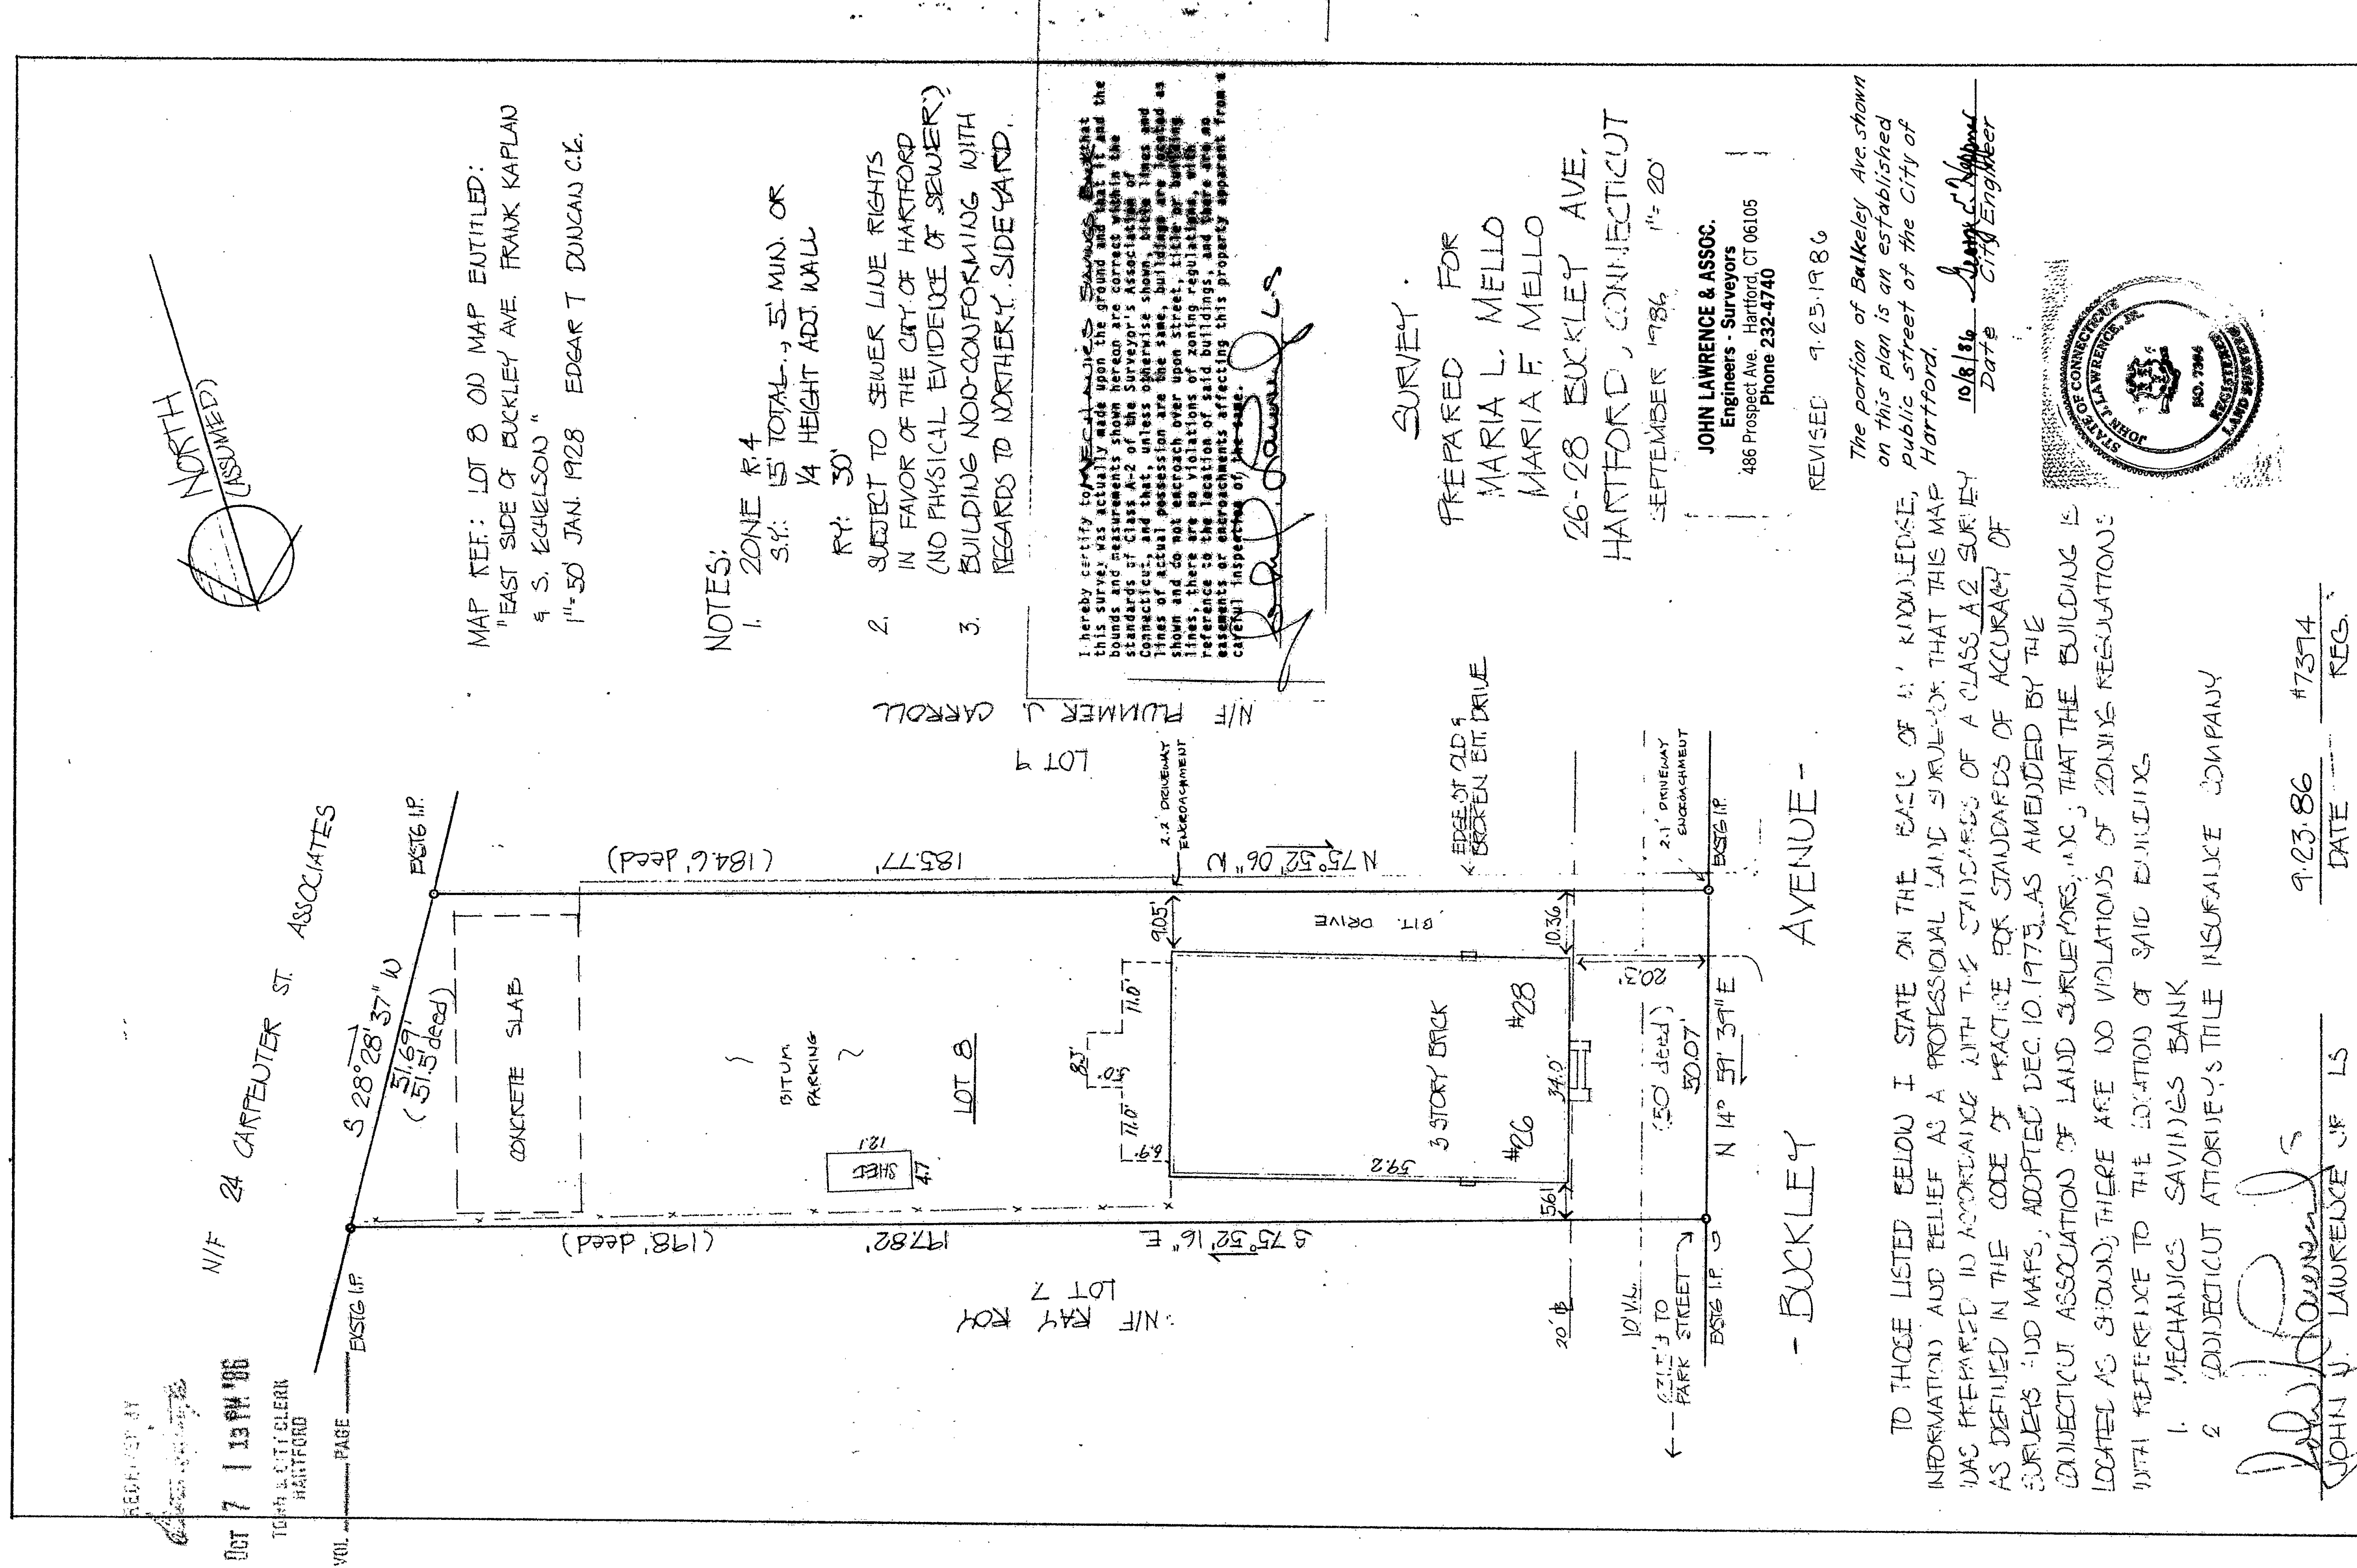

TO THOSE LISTED BELOW I STATE ON THE BASIS OF MY KNOWLEDGE, INFORMATION AND BELIEF AS A PROFESSIONAL LAND SURVEYOR THAT THIS MAP WAS PREPARED IN ACCORDANCE WITH THE STANDARDS OF A CLASS A2 SURVEY AS DEFINED IN THE CODE OF PRACTICE FOR STANDARDS OF ACCURACY OF SURVEYS AND MAPS, ADOPTED DEC. 10, 1973, AS AMENDED BY THE CONNECTICUT ASSOCIATION OF LAND SURVEYORS, INC.; THAT THE BUILDING IS LOCATED AS SHOWN; THERE ARE NO VIOLATIONS OF ZONING REGULATIONS WITH REFERENCE TO THE LOCATION OF SAID BUILDING.

1. MECHANICS SAVINGS BANK
2. CONNECTICUT ATTORNEY'S TITLE INSURANCE COMPANY

John V. Lawrence Jr. LS
9.23.86
#7374
DATE REC.

1548 20

2