


RECEIVED
OCT 7 1 52 PM '86

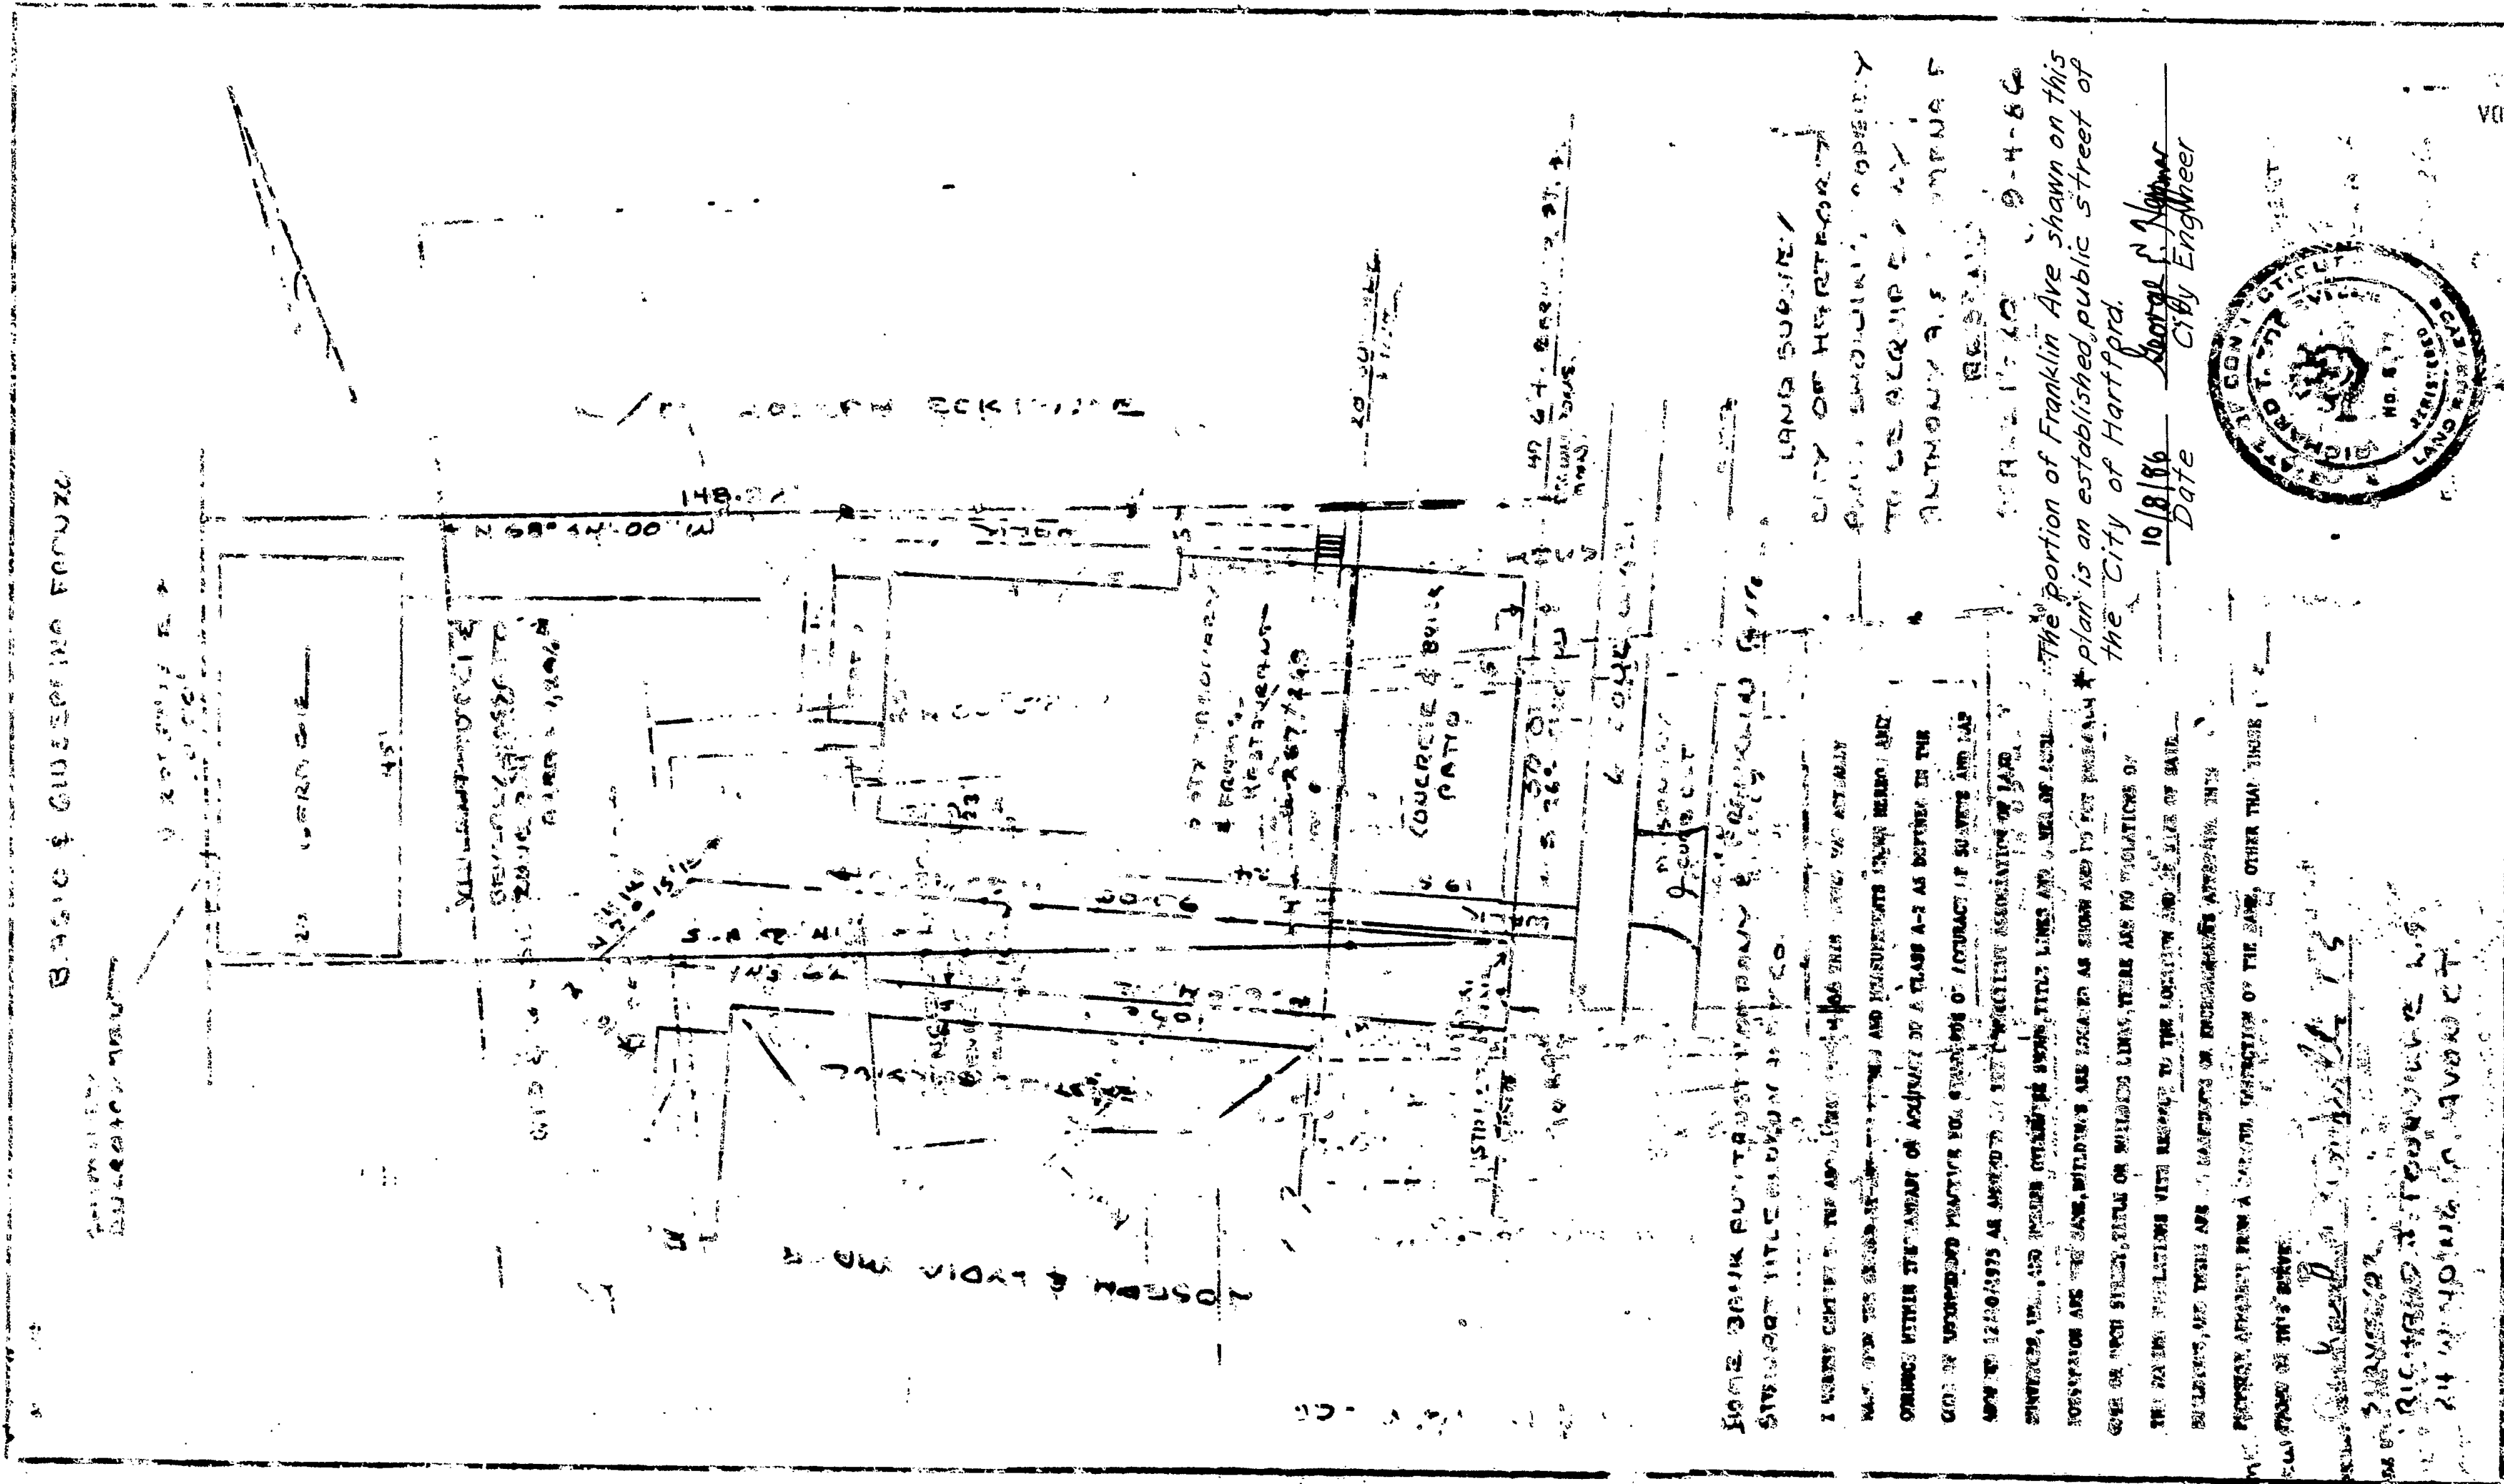

TOWN OF HARTFORD
PAGE



1548