


1550

1550-1

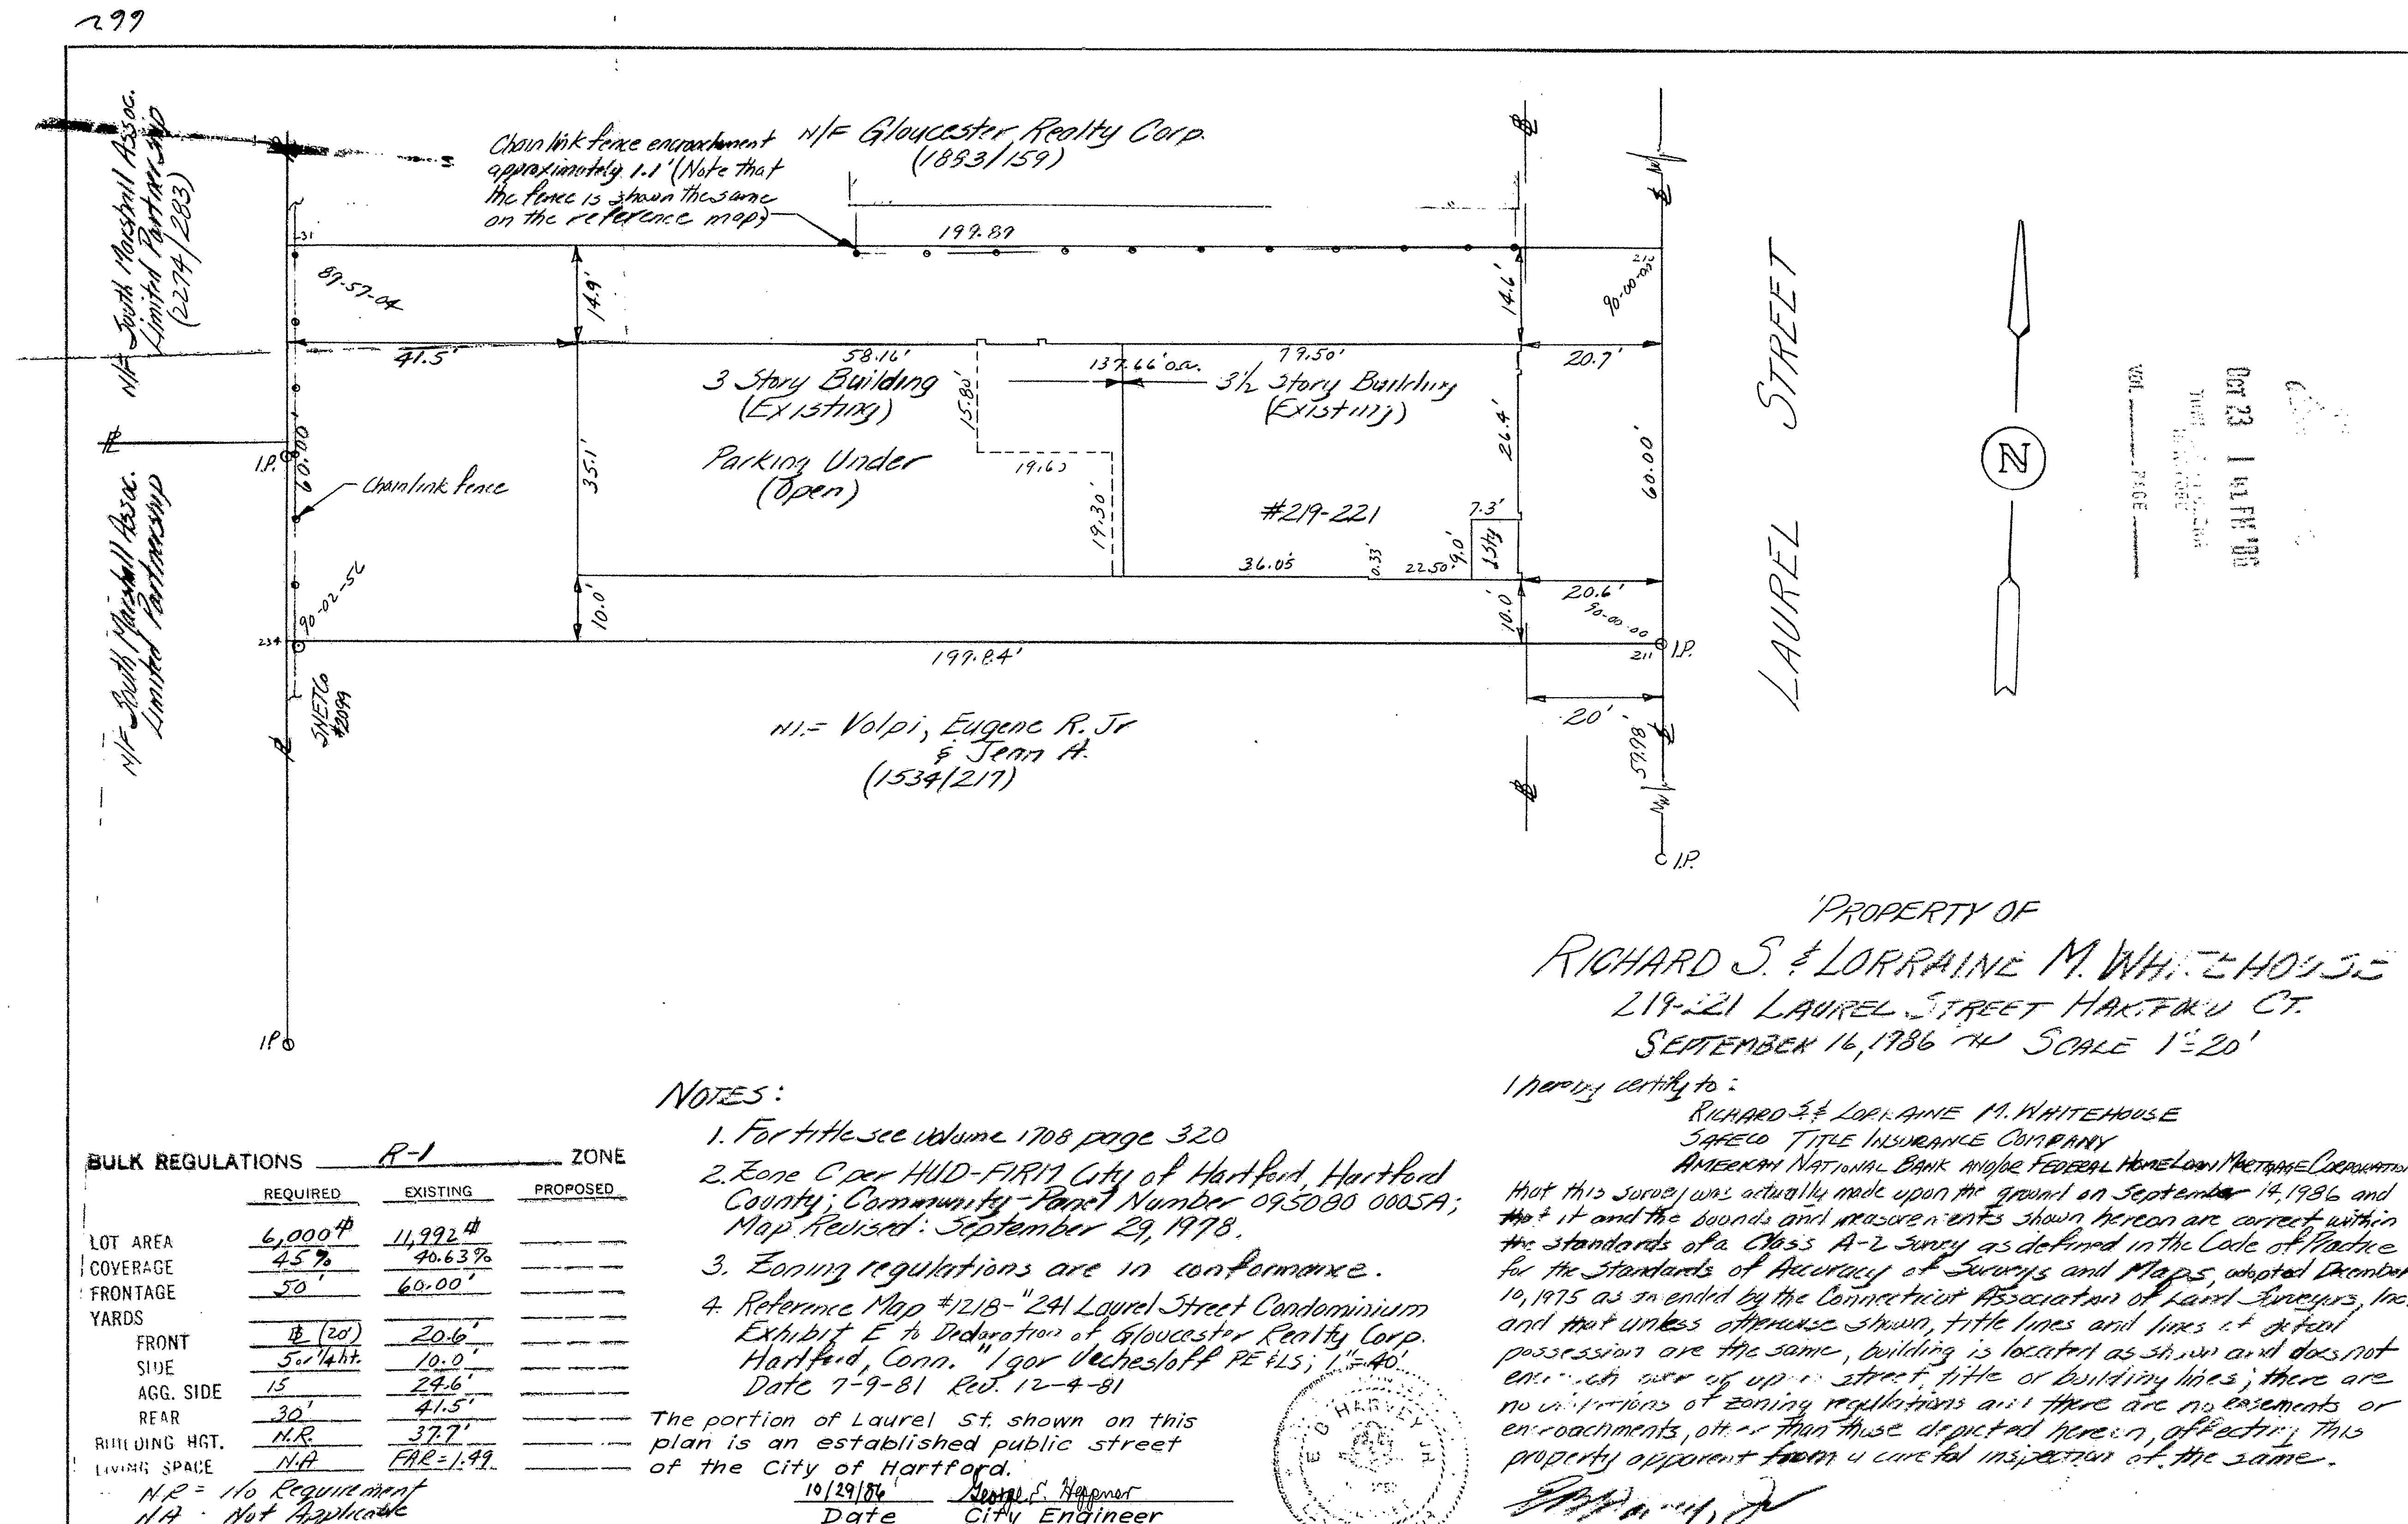

PROPERTY OF

RICHARD S. & LORRAINE M. WHITEHOUSE

219-221 LAUREL STREET HARTFORD CT.

SEPTEMBER 16, 1986 AT SCALE 1"=20'

I hereby certify to:

RICHARD S. & LORRAINE M. WHITEHOUSE

SAFE CO. TITLE INSURANCE COMPANY

AMERICAN NATIONAL BANK AND FEDERAL HOME LOAN CORPORATION

That this survey was actually made upon the ground on September 14, 1986 and that it and the bounds and measurements shown hereon are correct within the standards of a Class A-2 survey as defined in the Code of Practice for the Standards of Accuracy of Surveys and Maps, adopted December 10, 1975 as amended by the Connecticut Association of Land Surveyors, Inc.; and that unless otherwise shown, title lines and lines of actual possession are the same, building is located as shown and does not encroach over or up or across title or building lines; there are no violations of zoning regulations and there are no easements or encroachments, other than those depicted hereon, affecting this property apparent from a careful inspection of the same.

10/29/86 Date
City Engineer

1550

29

662

0 INCHES 1 2 3 4