


1552

1 5 5 2 - 1

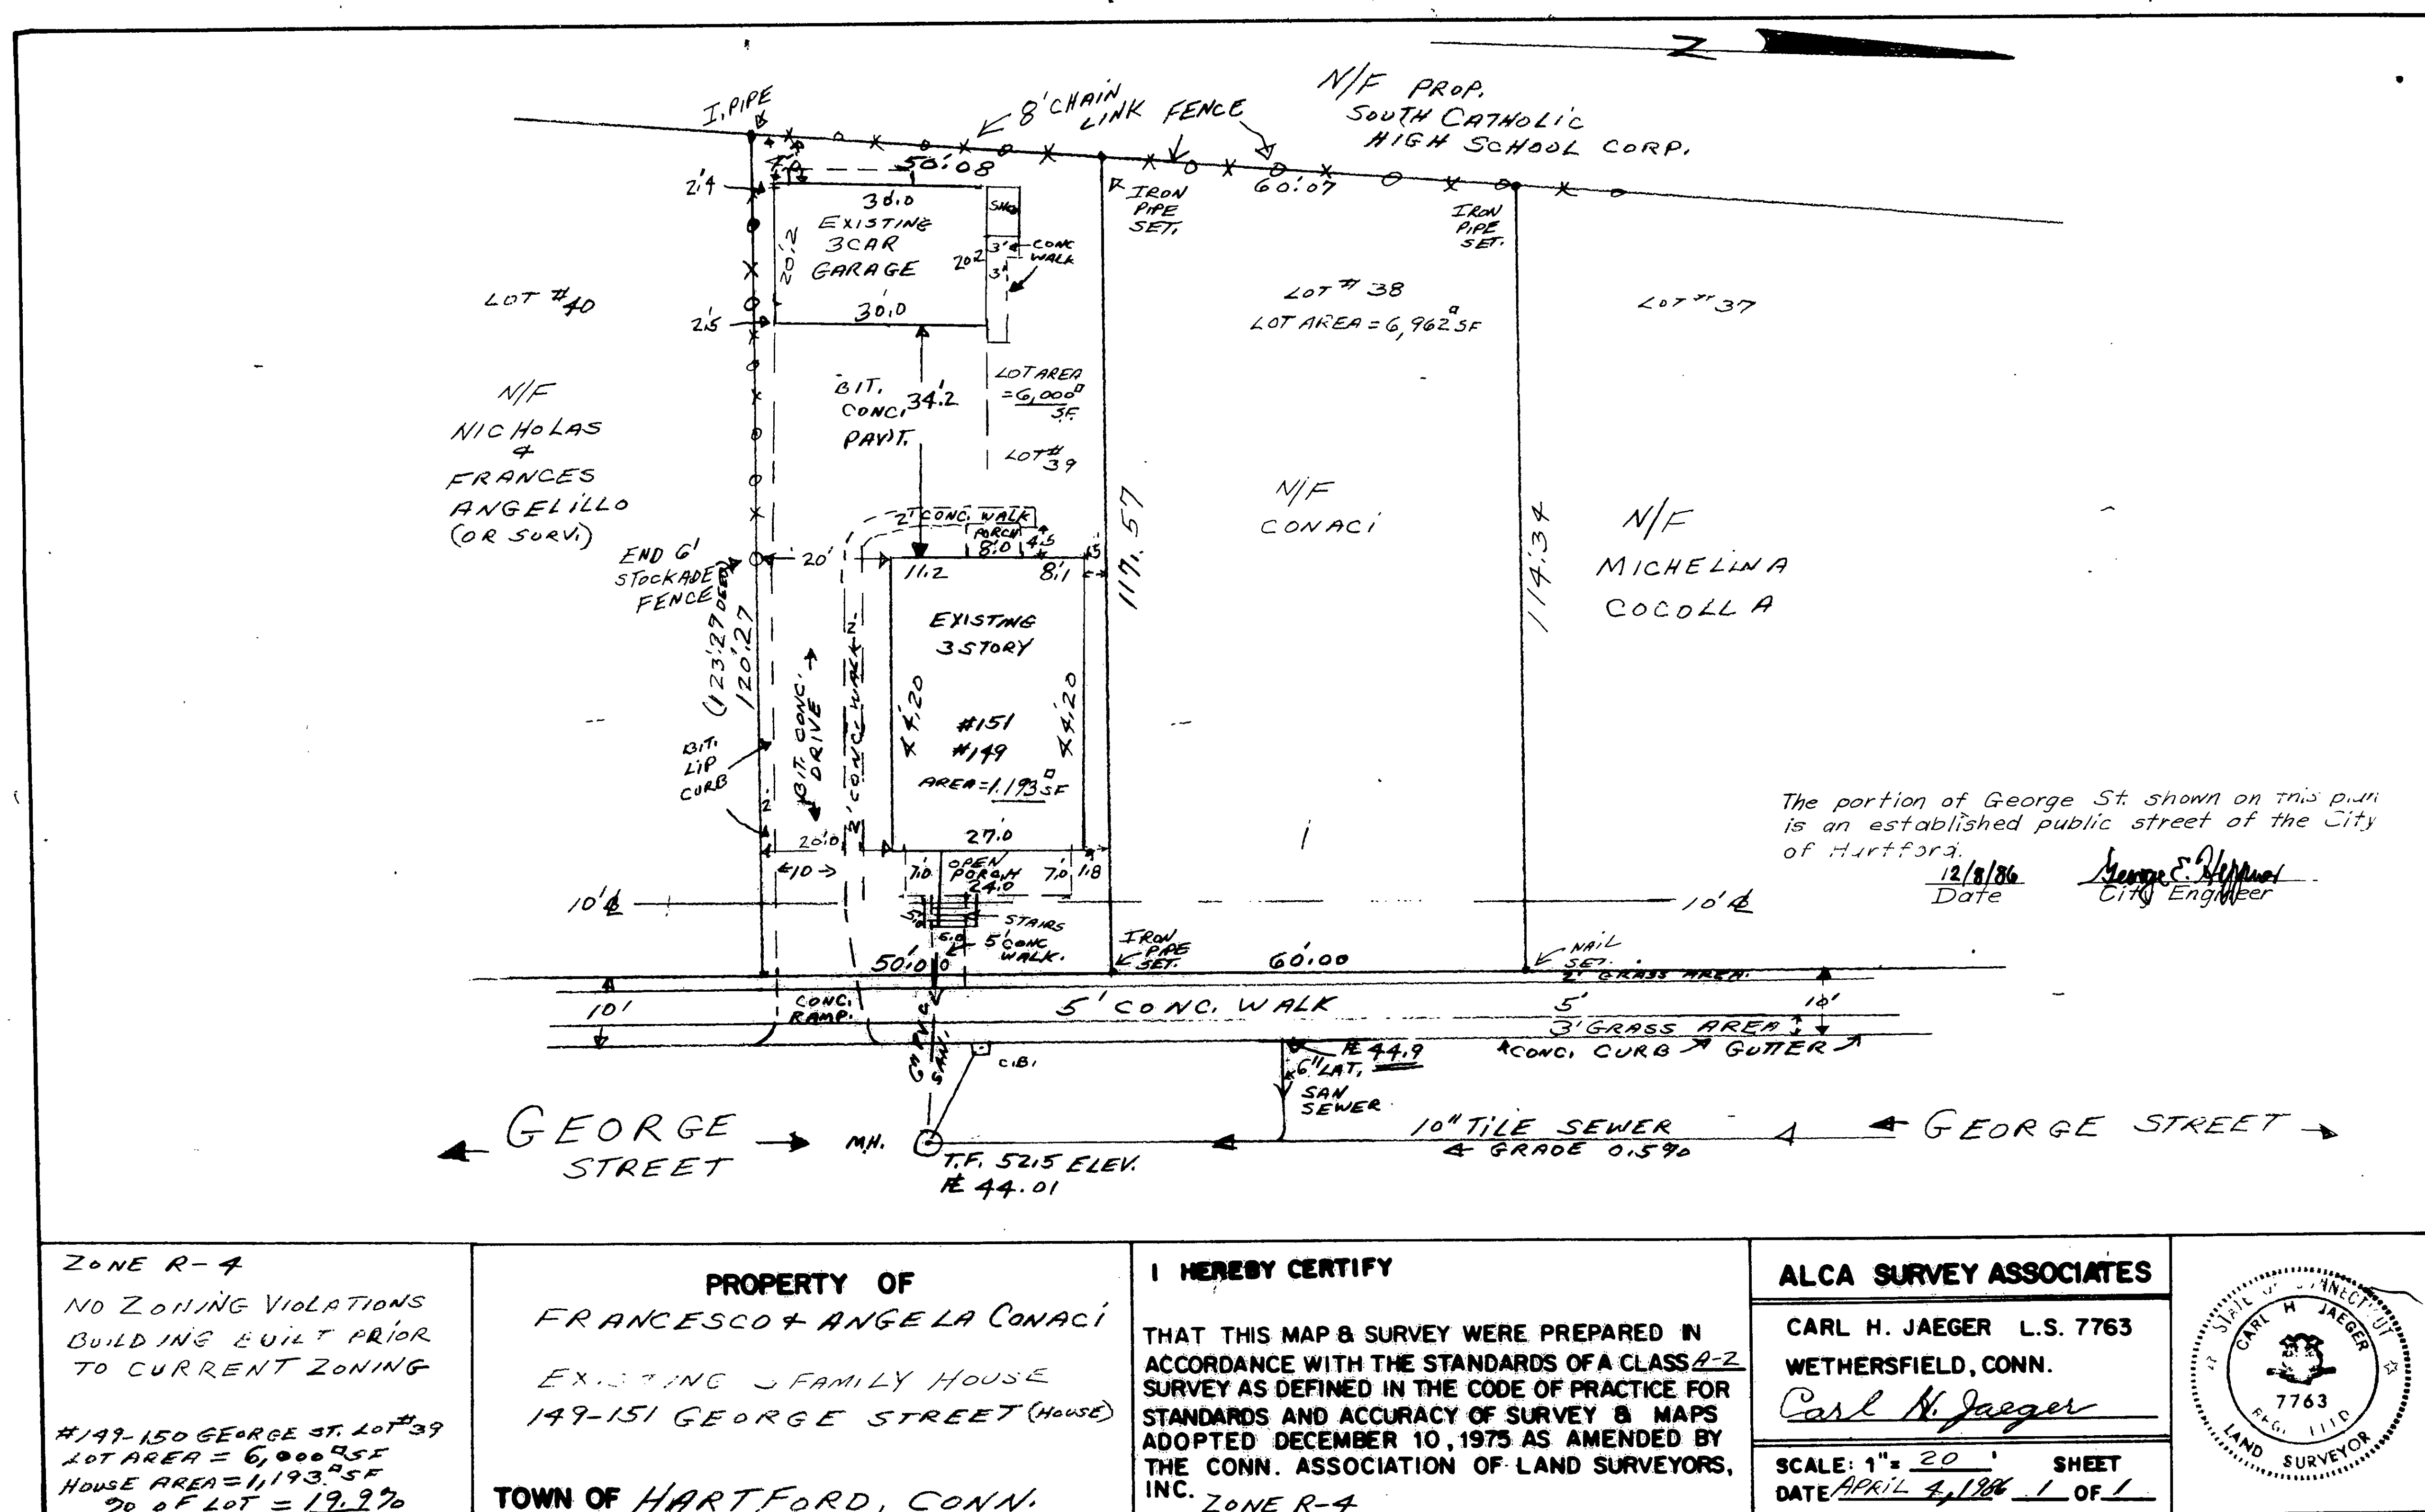

plan size 12x18

1552

42

0 INCHES 1 2 3