


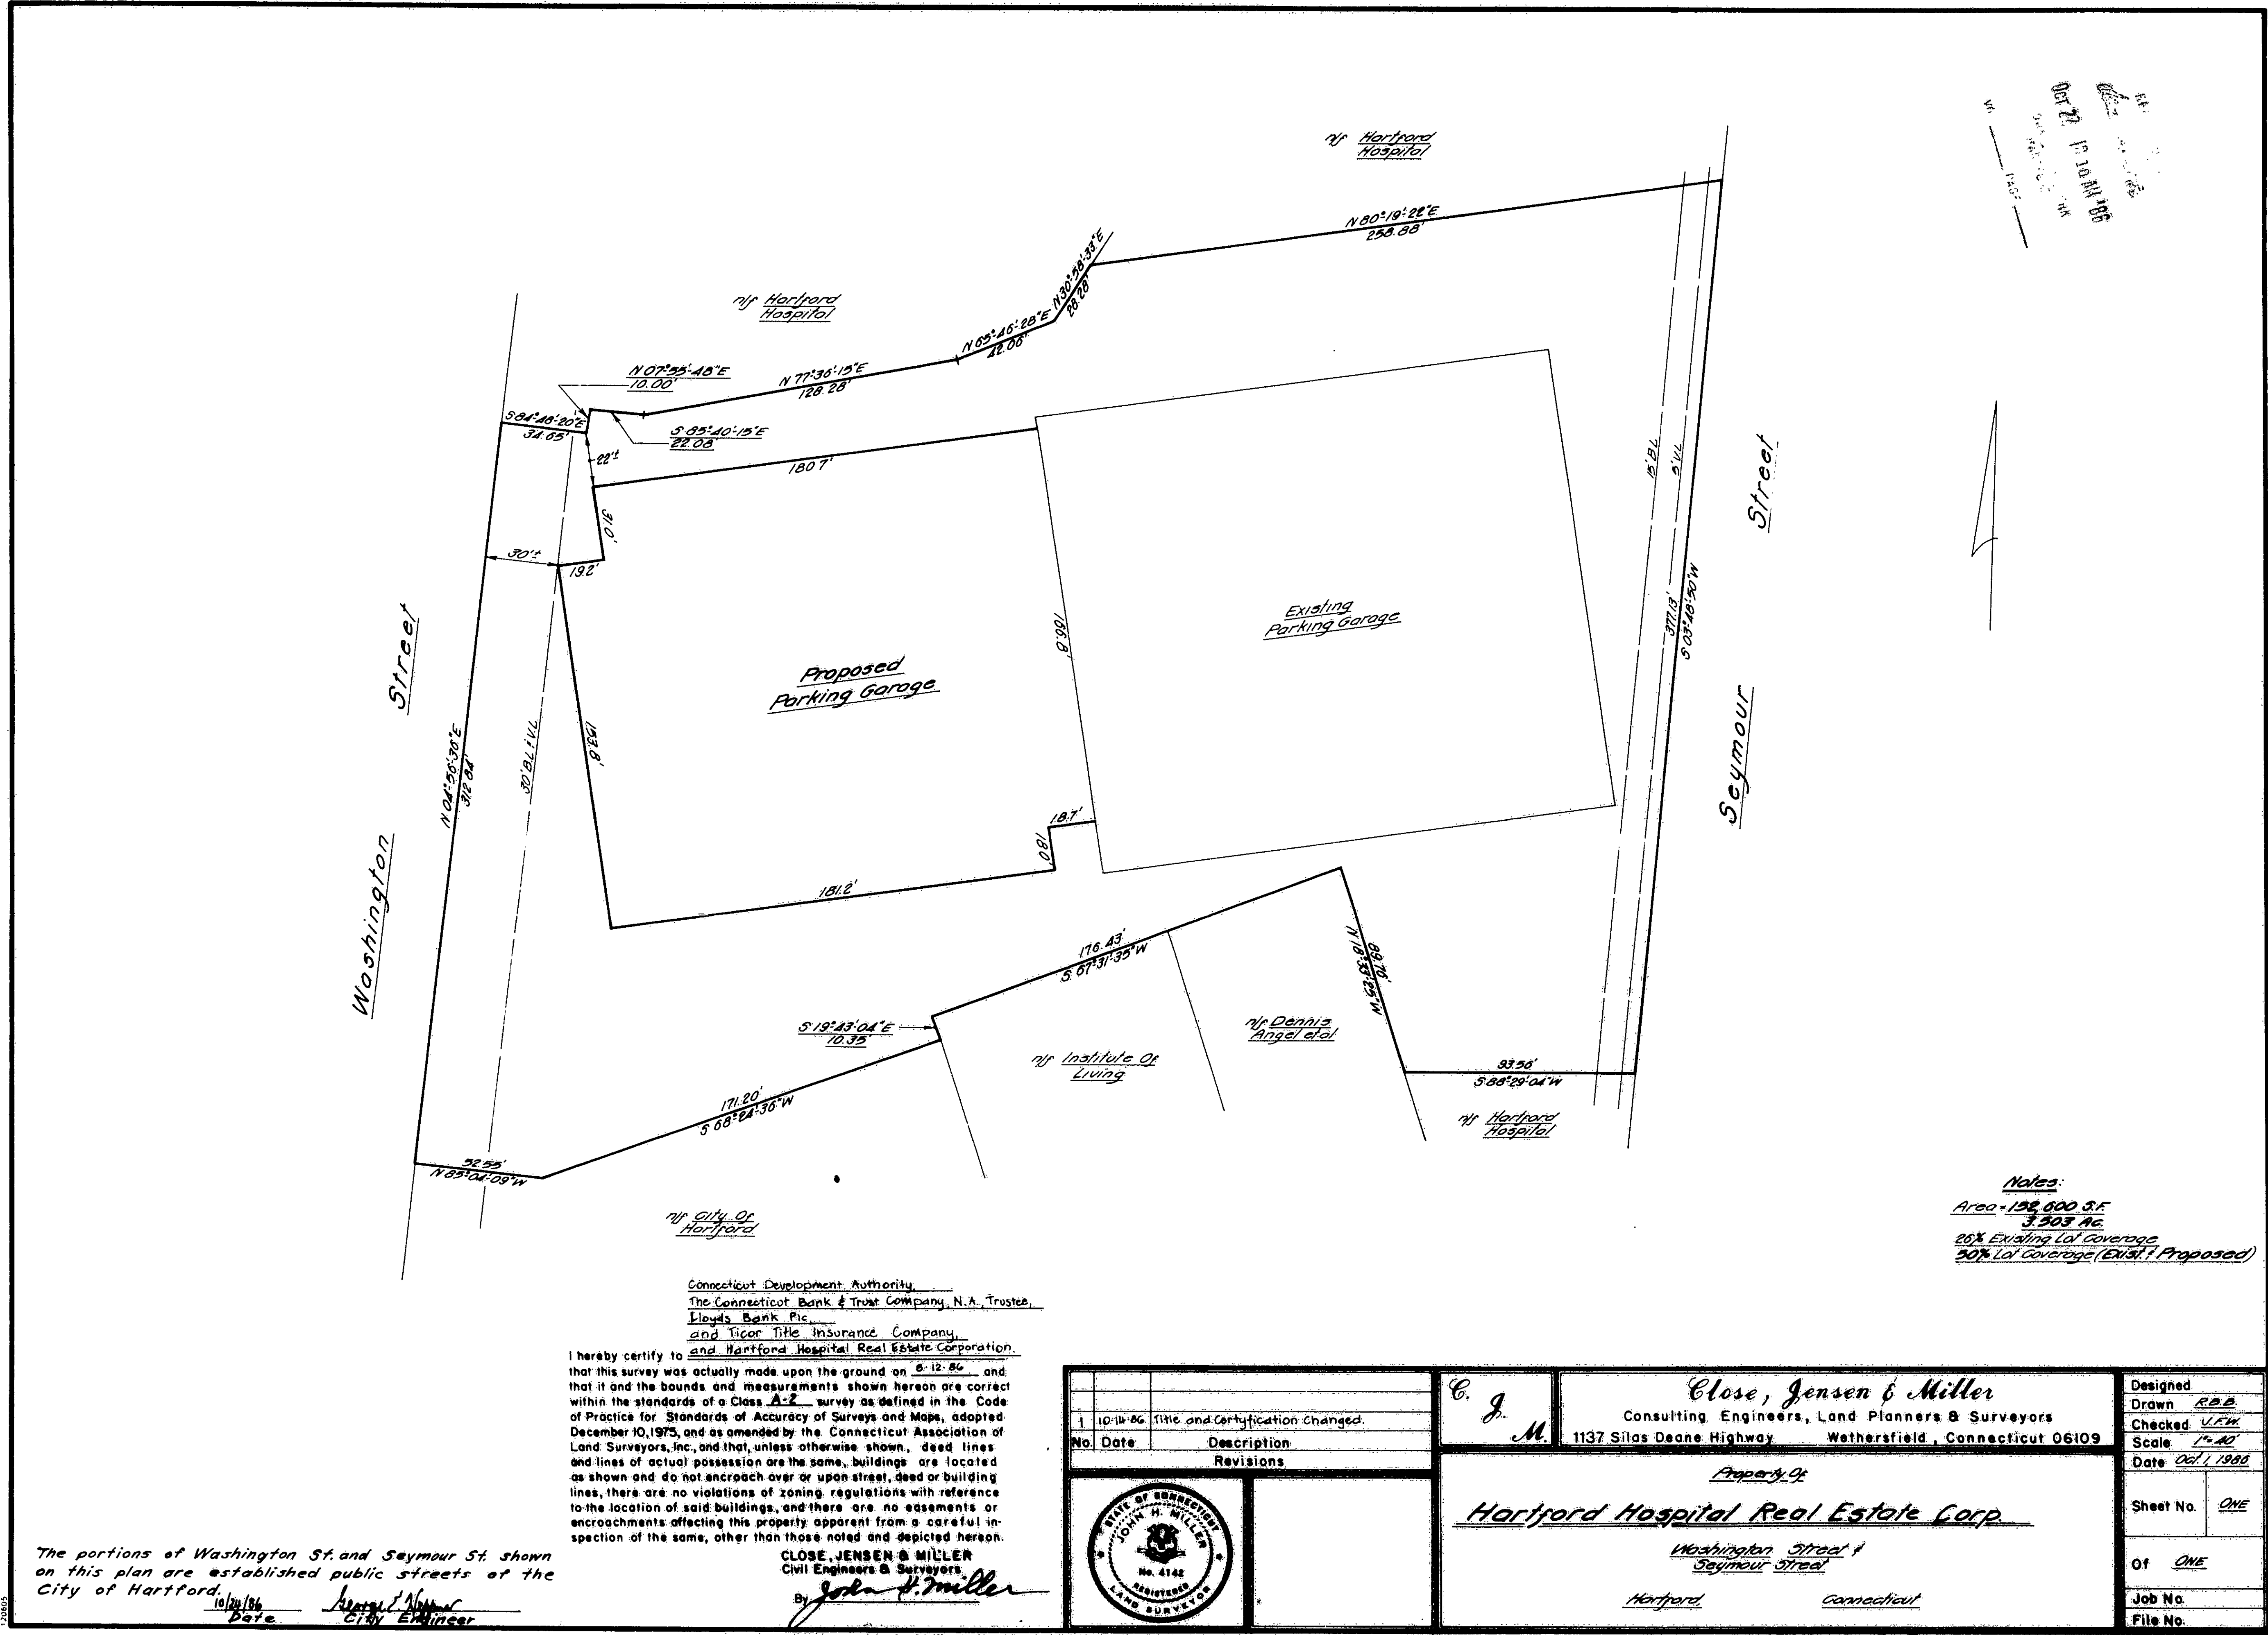

10-14-86 Title and Certification Changed.		C. J. M.		Close, Jensen & Miller Consulting Engineers, Land Planners & Surveyors 1137 Silas Deane Highway Wethersfield, Connecticut 06109		Designed Drawn R.B.B. Checked V.F.M. Scale 1"=40' Date Oct 1, 1986	
No. Date Description Revisions		Property Of		Hartford Hospital Real Estate Corp.		Sheet No. ONE	
STATE OF CONNECTICUT JOHN H. MILLER No. 4142 REGISTERED LAND SURVEYOR		Washington Street & Seymour Street		Hartford, Connecticut		Of ONE	
						Job No. File No.	

