


The portion of Washington St. shown on this plan is an established public street of the City of Hartford.  
10/24/86 Date Surveyor's Signature  
City Engineer

CONNECTICUT DEVELOPMENT AUTHORITY  
THE CONNECTICUT BANK AND TRUST CO. N.A., TRUSTEE  
HARTFORD HOSPITAL REAL ESTATE CORPORATION  
I hereby certify to  
that this survey was actually made upon the ground on 10/14/86, and that it and the bounds and measurements shown hereon are correct within the standards of a Class 2B survey as defined in the Code of Practice for Standards of Accuracy of Surveys and Maps, adopted December 10, 1975, and as amended by the Connecticut Association of Land Surveyors, Inc. and that, unless otherwise shown, dead lines and lines of actual possession are the same, buildings are located as shown and do not encroach over or upon street, dead or building lines, there are no violations of zoning regulations with reference to the location of said buildings, and there are no easements or encroachments affecting this property apparent from a careful inspection of the same, other than those noted and depicted hereon.  
CLOSE, JENSEN & MILLER  
Civil Engineers & Surveyors  
By John A. Miller

No.	Date	Description	Revisions		Close, Jensen & Miller Consulting Engineers, Land Planners & Surveyors 1137 Silas Deane Highway Wethersfield, Connecticut 06109	PROPERTY OF HARTFORD HOSPITAL REAL ESTATE CORP. WASHINGTON STREET & SPRING STREET HARTFORD, CONNECTICUT	Designed Drawn <u>EDB</u> Checked <u>J.P.W.</u> Scale <u>1"=40'</u> Date <u>10/24/86</u>
							Sheet No. <u>ONE</u> Of <u>ONE</u> Job No. File No.

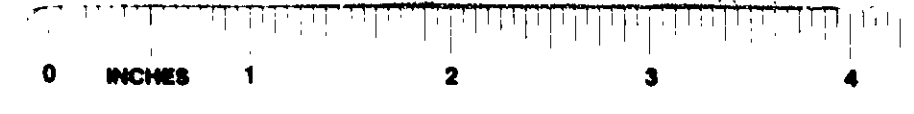

1562