
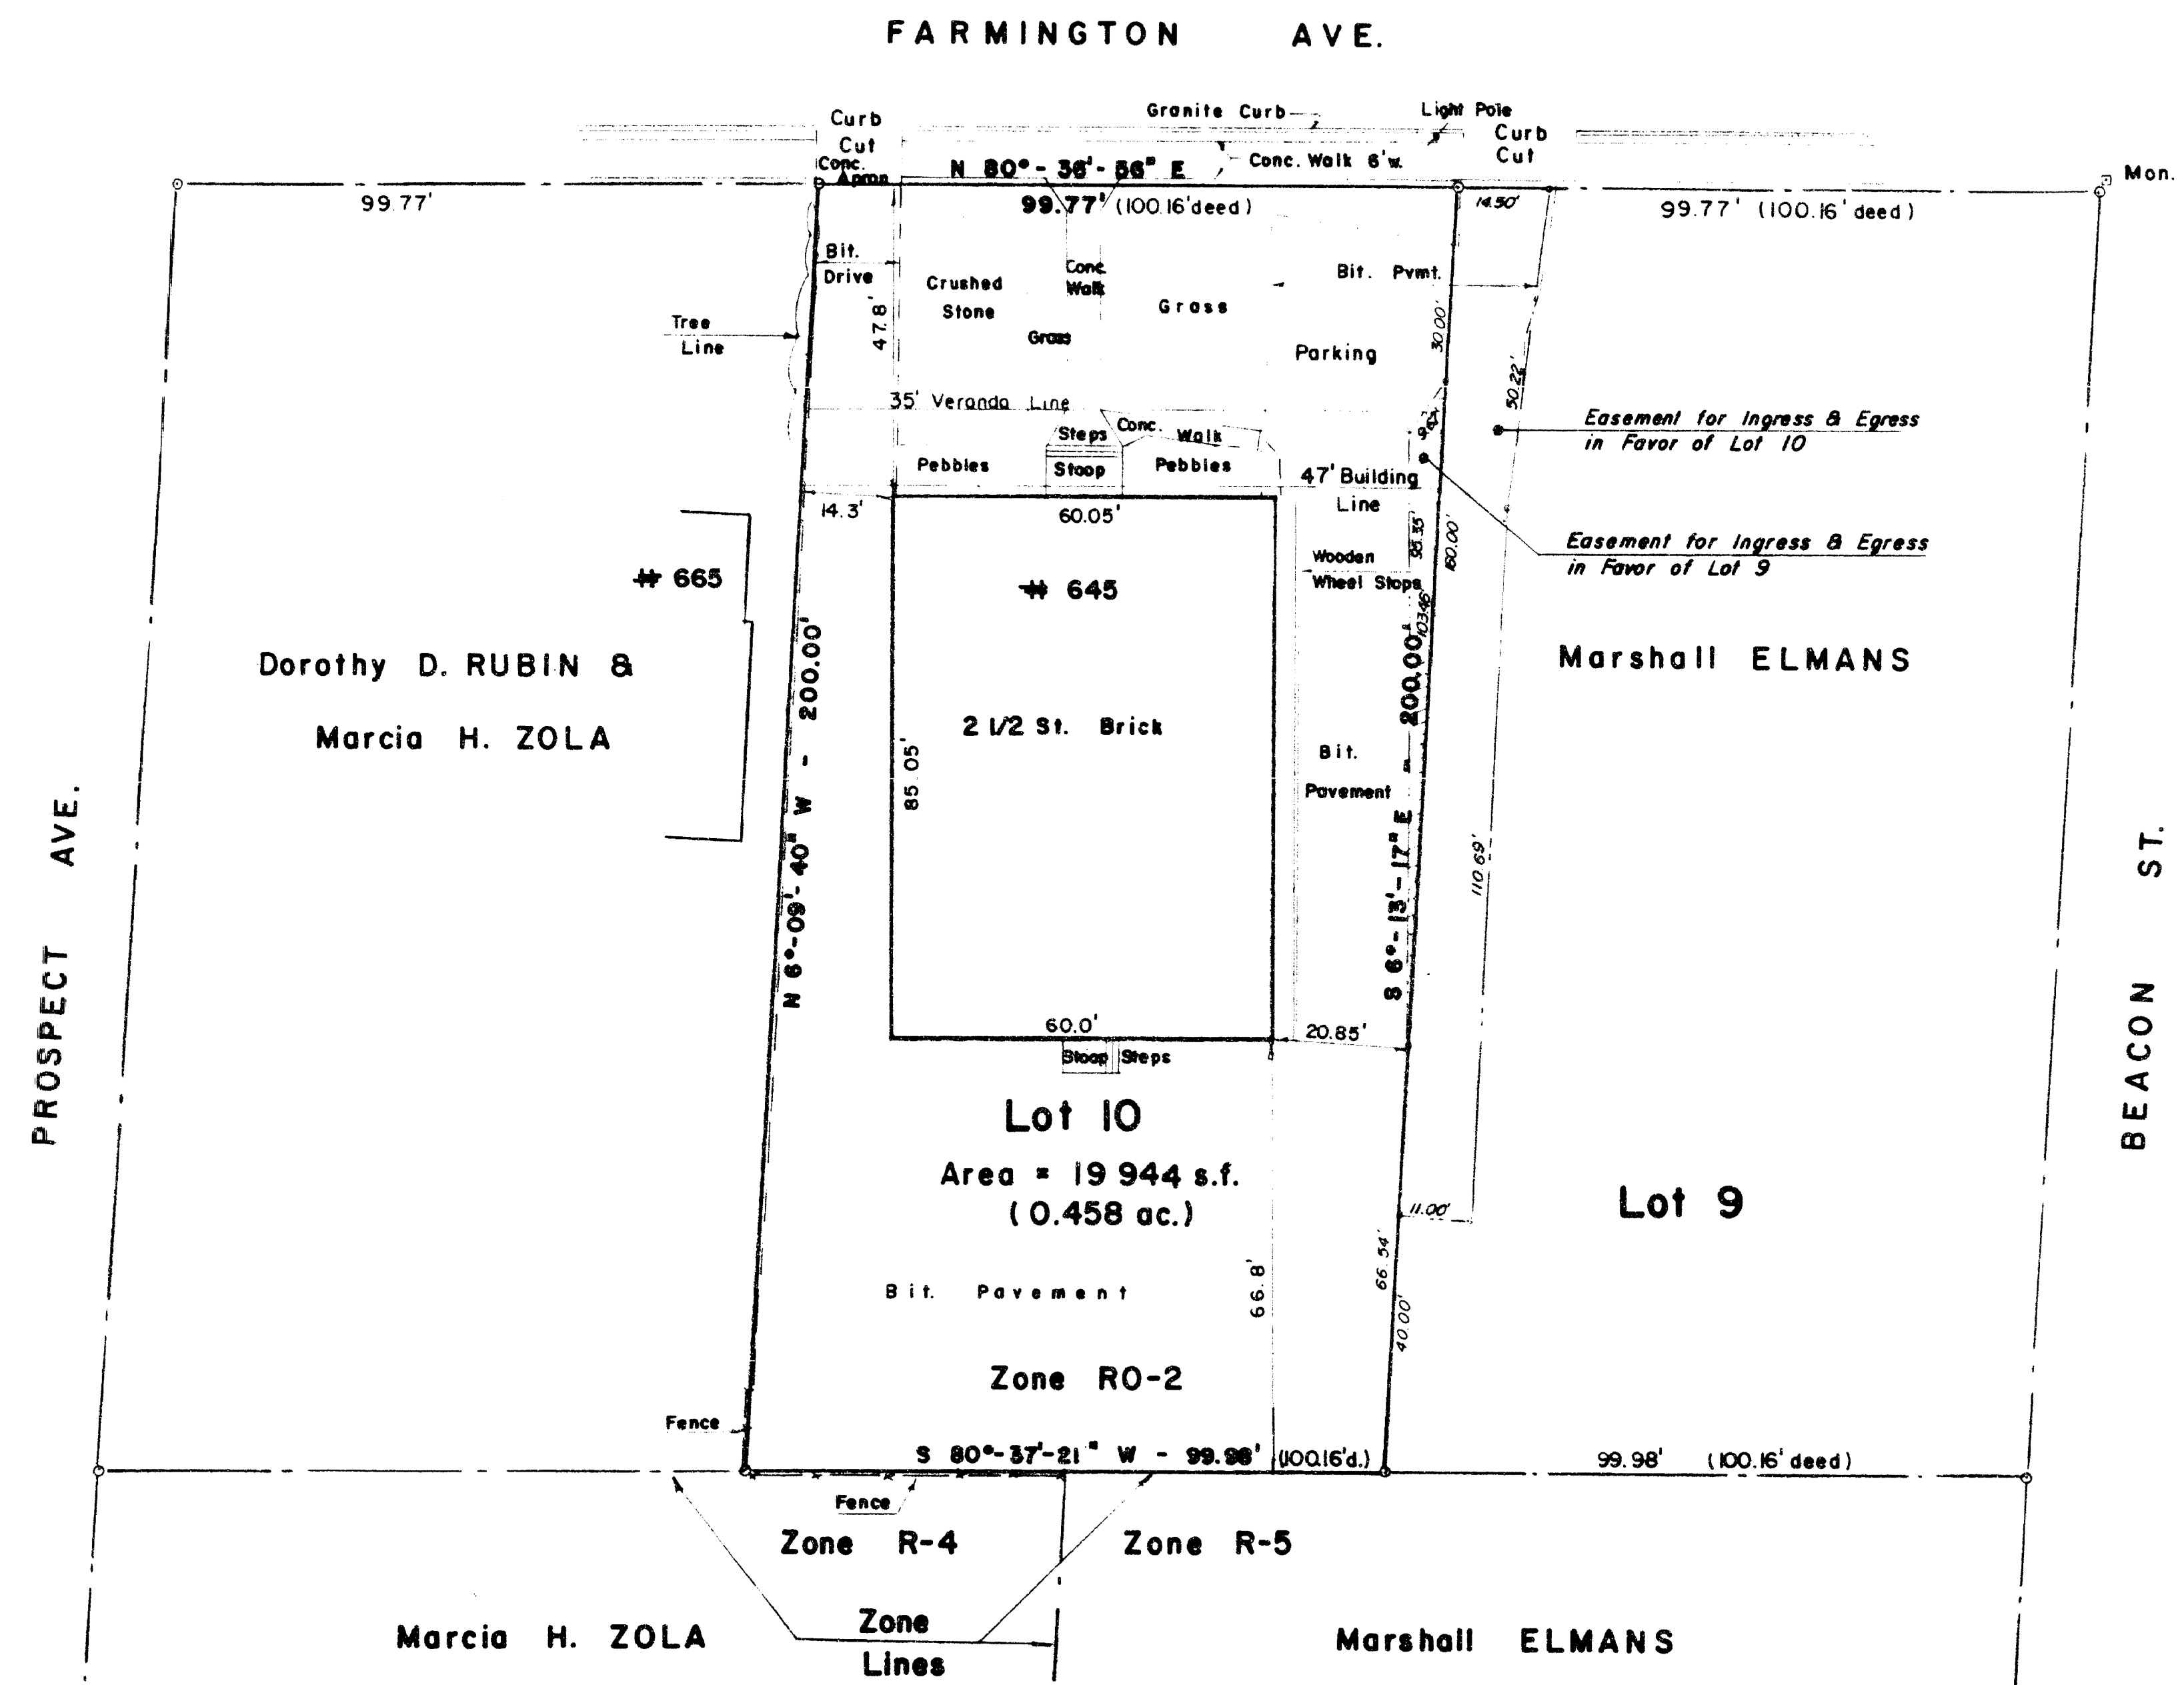


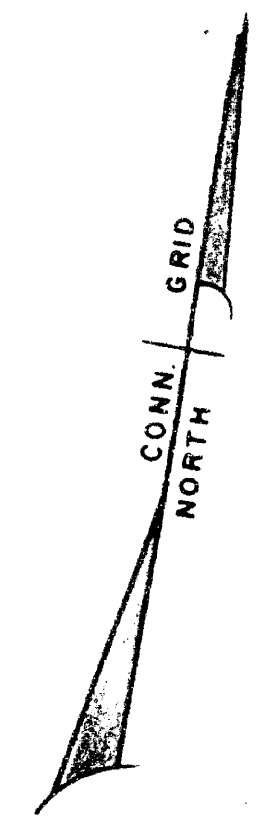

AS SHOWN ON THIS MAP, THE PROPERTY IS LOCATED IN THE CITY OF HARTFORD, CONNECTICUT, AND IS SUBJECT TO THE CITY OF HARTFORD, CONNECTICUT, ZONING REGULATIONS, RELATING TO THE LOCATION OF SAID BUILDING.

The portions of Prospect Ave., Farmington Ave., and Beacon St. shown on this plan are established public streets of the City of Hartford.

11/26/86 Date
Supp. 11/26/86 City Engineer


I HEREBY CERTIFY THAT THIS MAP AND SURVEY WERE PREPARED IN ACCORDANCE WITH THE STANDARDS OF A CLASS A-2 SURVEY AS DEFINED IN THE CODE OF PRACTICE FOR STANDARDS OF SURVEYS AND MAPS, ADOPTED DECEMBER 10, 1975 AS AMENDED BY THE CONNECTICUT ASSOCIATION OF LAND SURVEYORS, INC.

11-11-86 DATE
3756 REGISTRATION NO.

Survey Map
645 FARMINGTON AVE.
Hartford, Conn.

IGOR VECHESLOFF
PROFESSIONAL ENGINEER & LAND SURVEYOR
51 LORRAINE STREET
HARTFORD, CONNECTICUT

SCALE 1" = 20'	DATE 11-11-86
DRAWING NO. 2125	

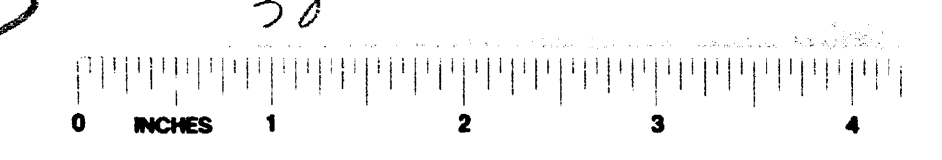

1567

18506