


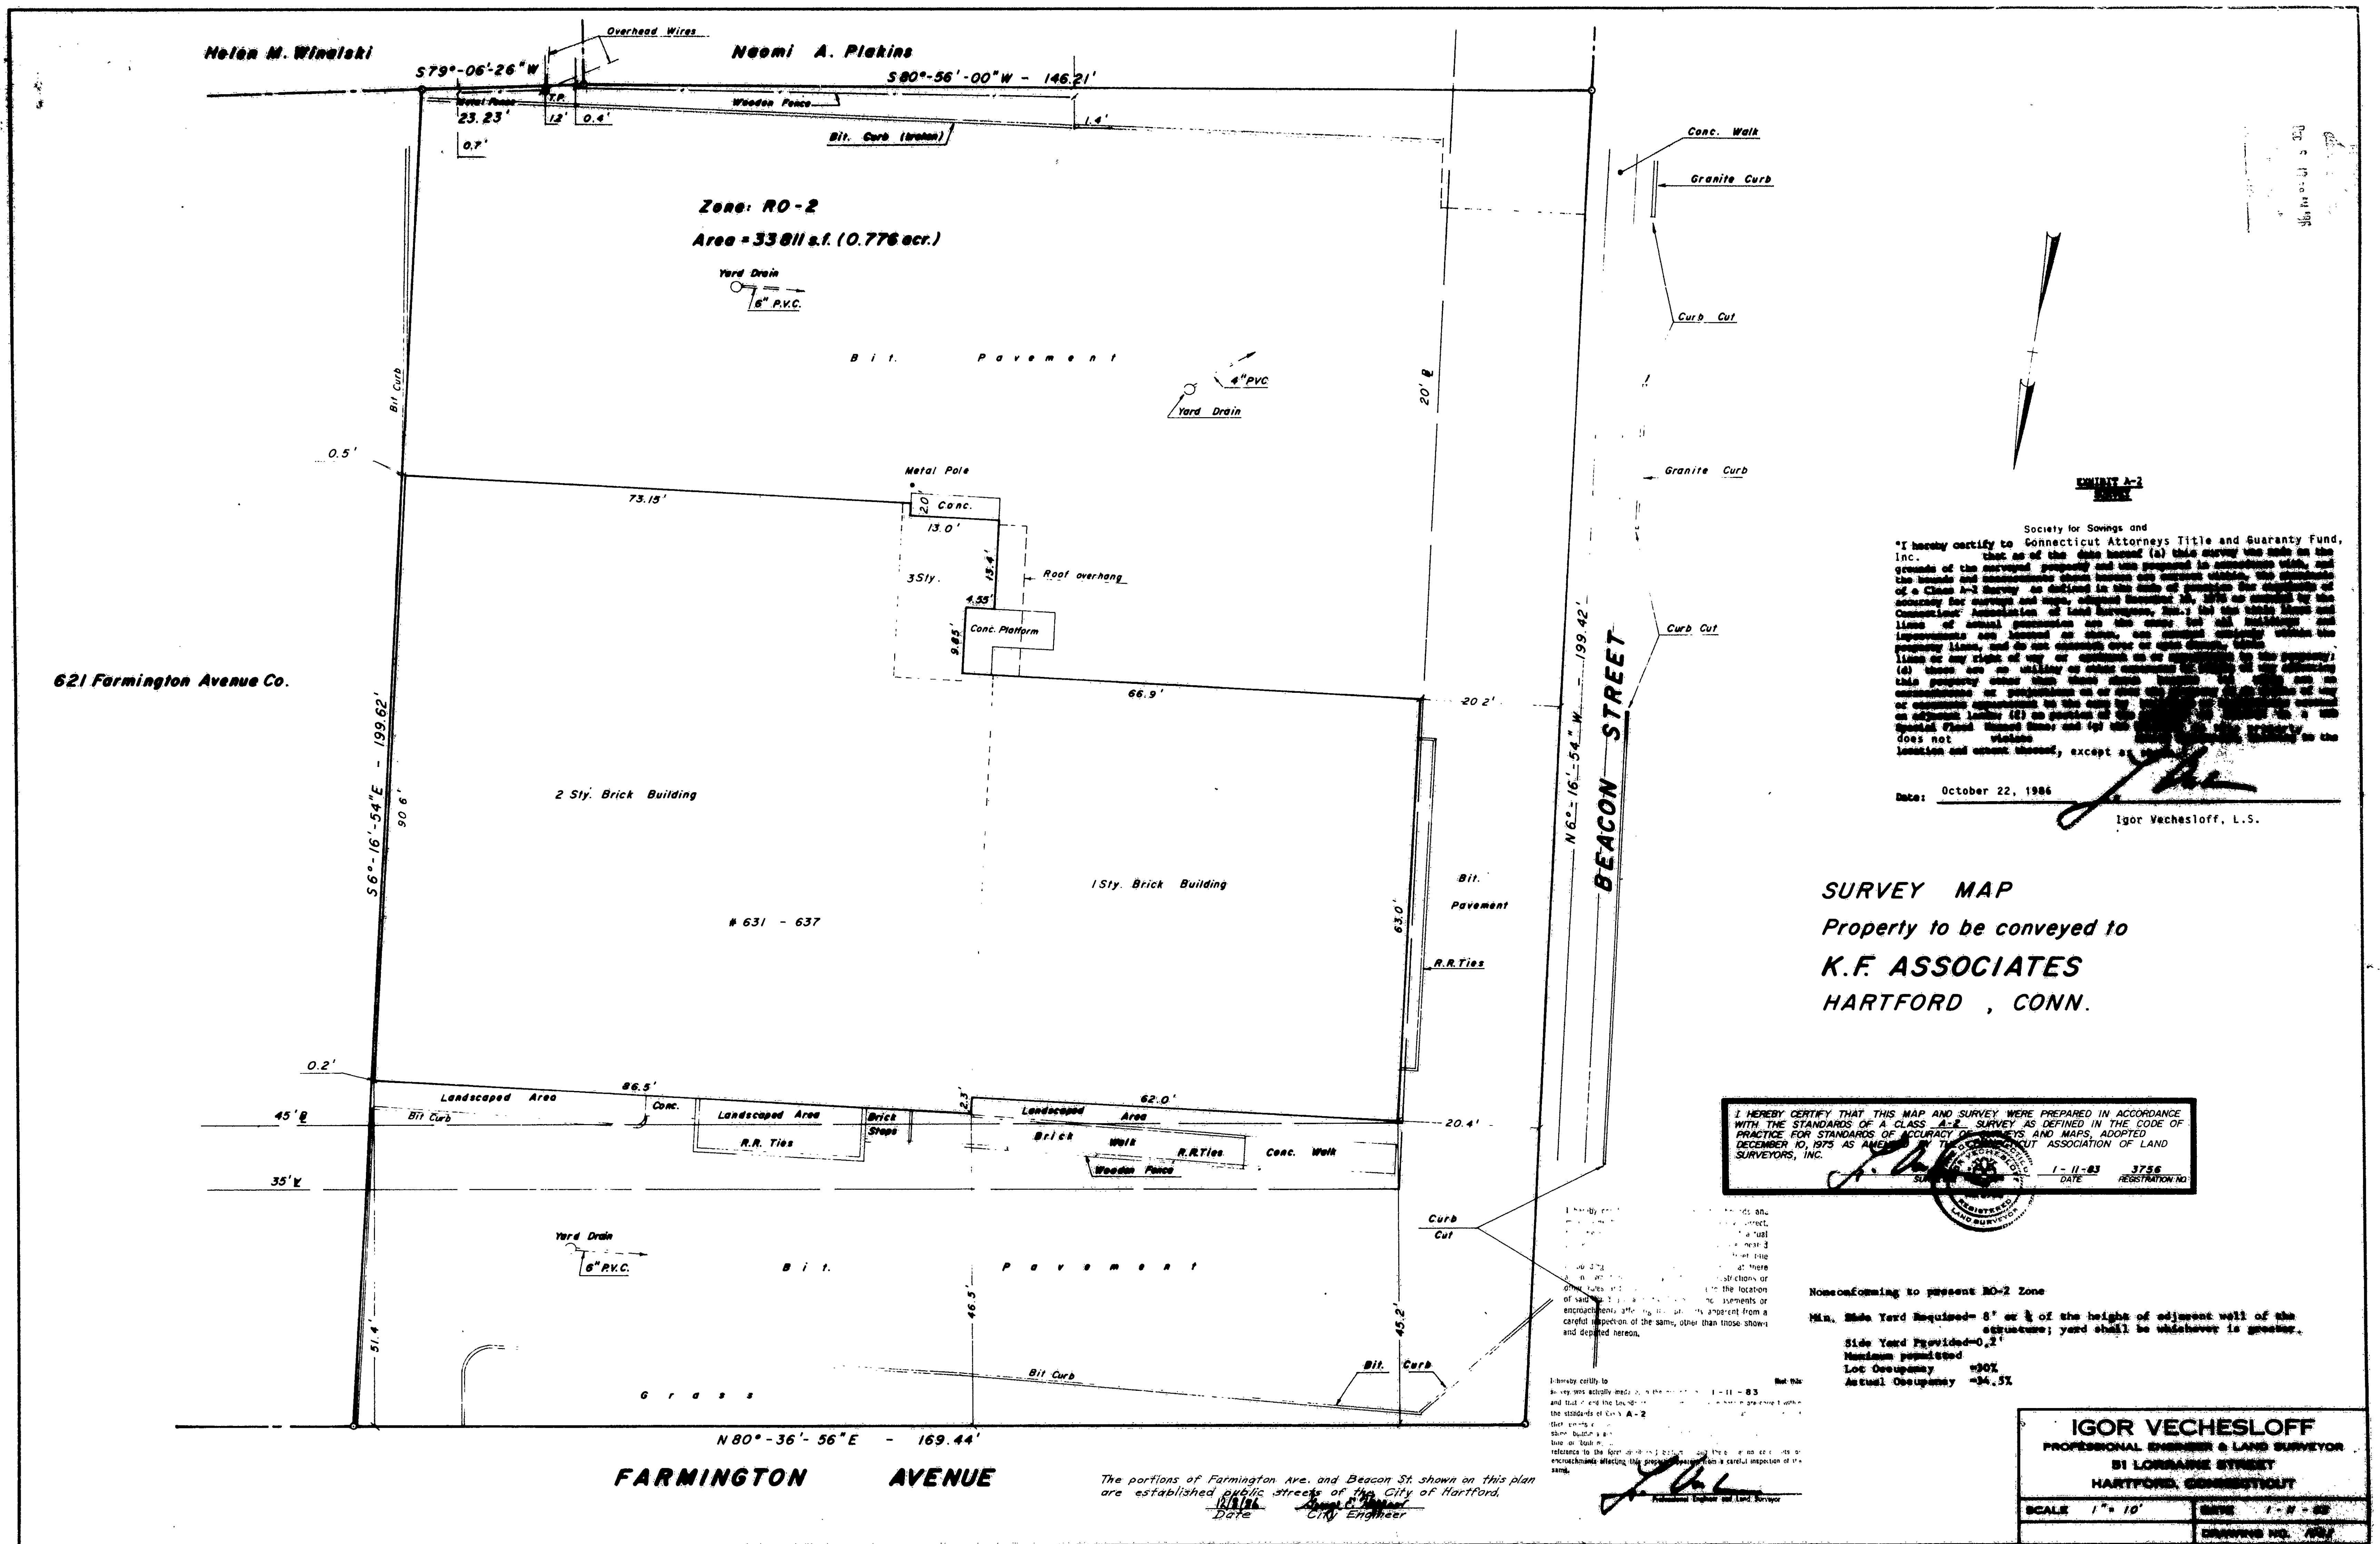

SURVEY MAP
Property to be conveyed to
K.F. ASSOCIATES
HARTFORD , CONN.


 1-11-83 3756
DATE REGISTRATION NO.

Nonconforming to present NO-2 Zone

Min. Side Yard Required- 8' or $\frac{1}{2}$ of the height of adjacent wall of the structure; yard shall be whichever is greater.

Side Yard Provided=0.2'
Maximum permitted
Lot Occupancy =30%
Actual Occupancy =34.5%

IGOR VECHESLOFF
PROFESSIONAL ENGINEER & LAND SURVEYOR
51 LORRAINE STREET
HARTFORD, CONNECTICUT

SCALE 1" = 10'	DATE 1-2-52

