

**Structural, Mechanical &
Electrical Engineers:**
**BURTON & VAN HOUTEN
ENGINEERS, INC.**
10 North Main St.
West Hartford, CT
(203) 236-2365

**100 PEARL STREET
HARTFORD, CONNECTICUT**
Pearl Street Associates, Limited Partnership

**Jeter
Cook &
Jepson**
Architects, P.C.
450 Church Street Hartford Connecticut 06103



P.C. 9
P.M. 12
D.P. 12
J.C. 12

ISSUE 7/15/66
JOB 8346-00
DRAWN ALL
SCALE 1/8"

A21.3A
SRD FLOOR PLAN A

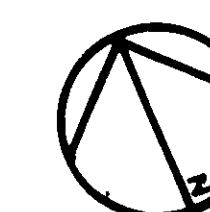
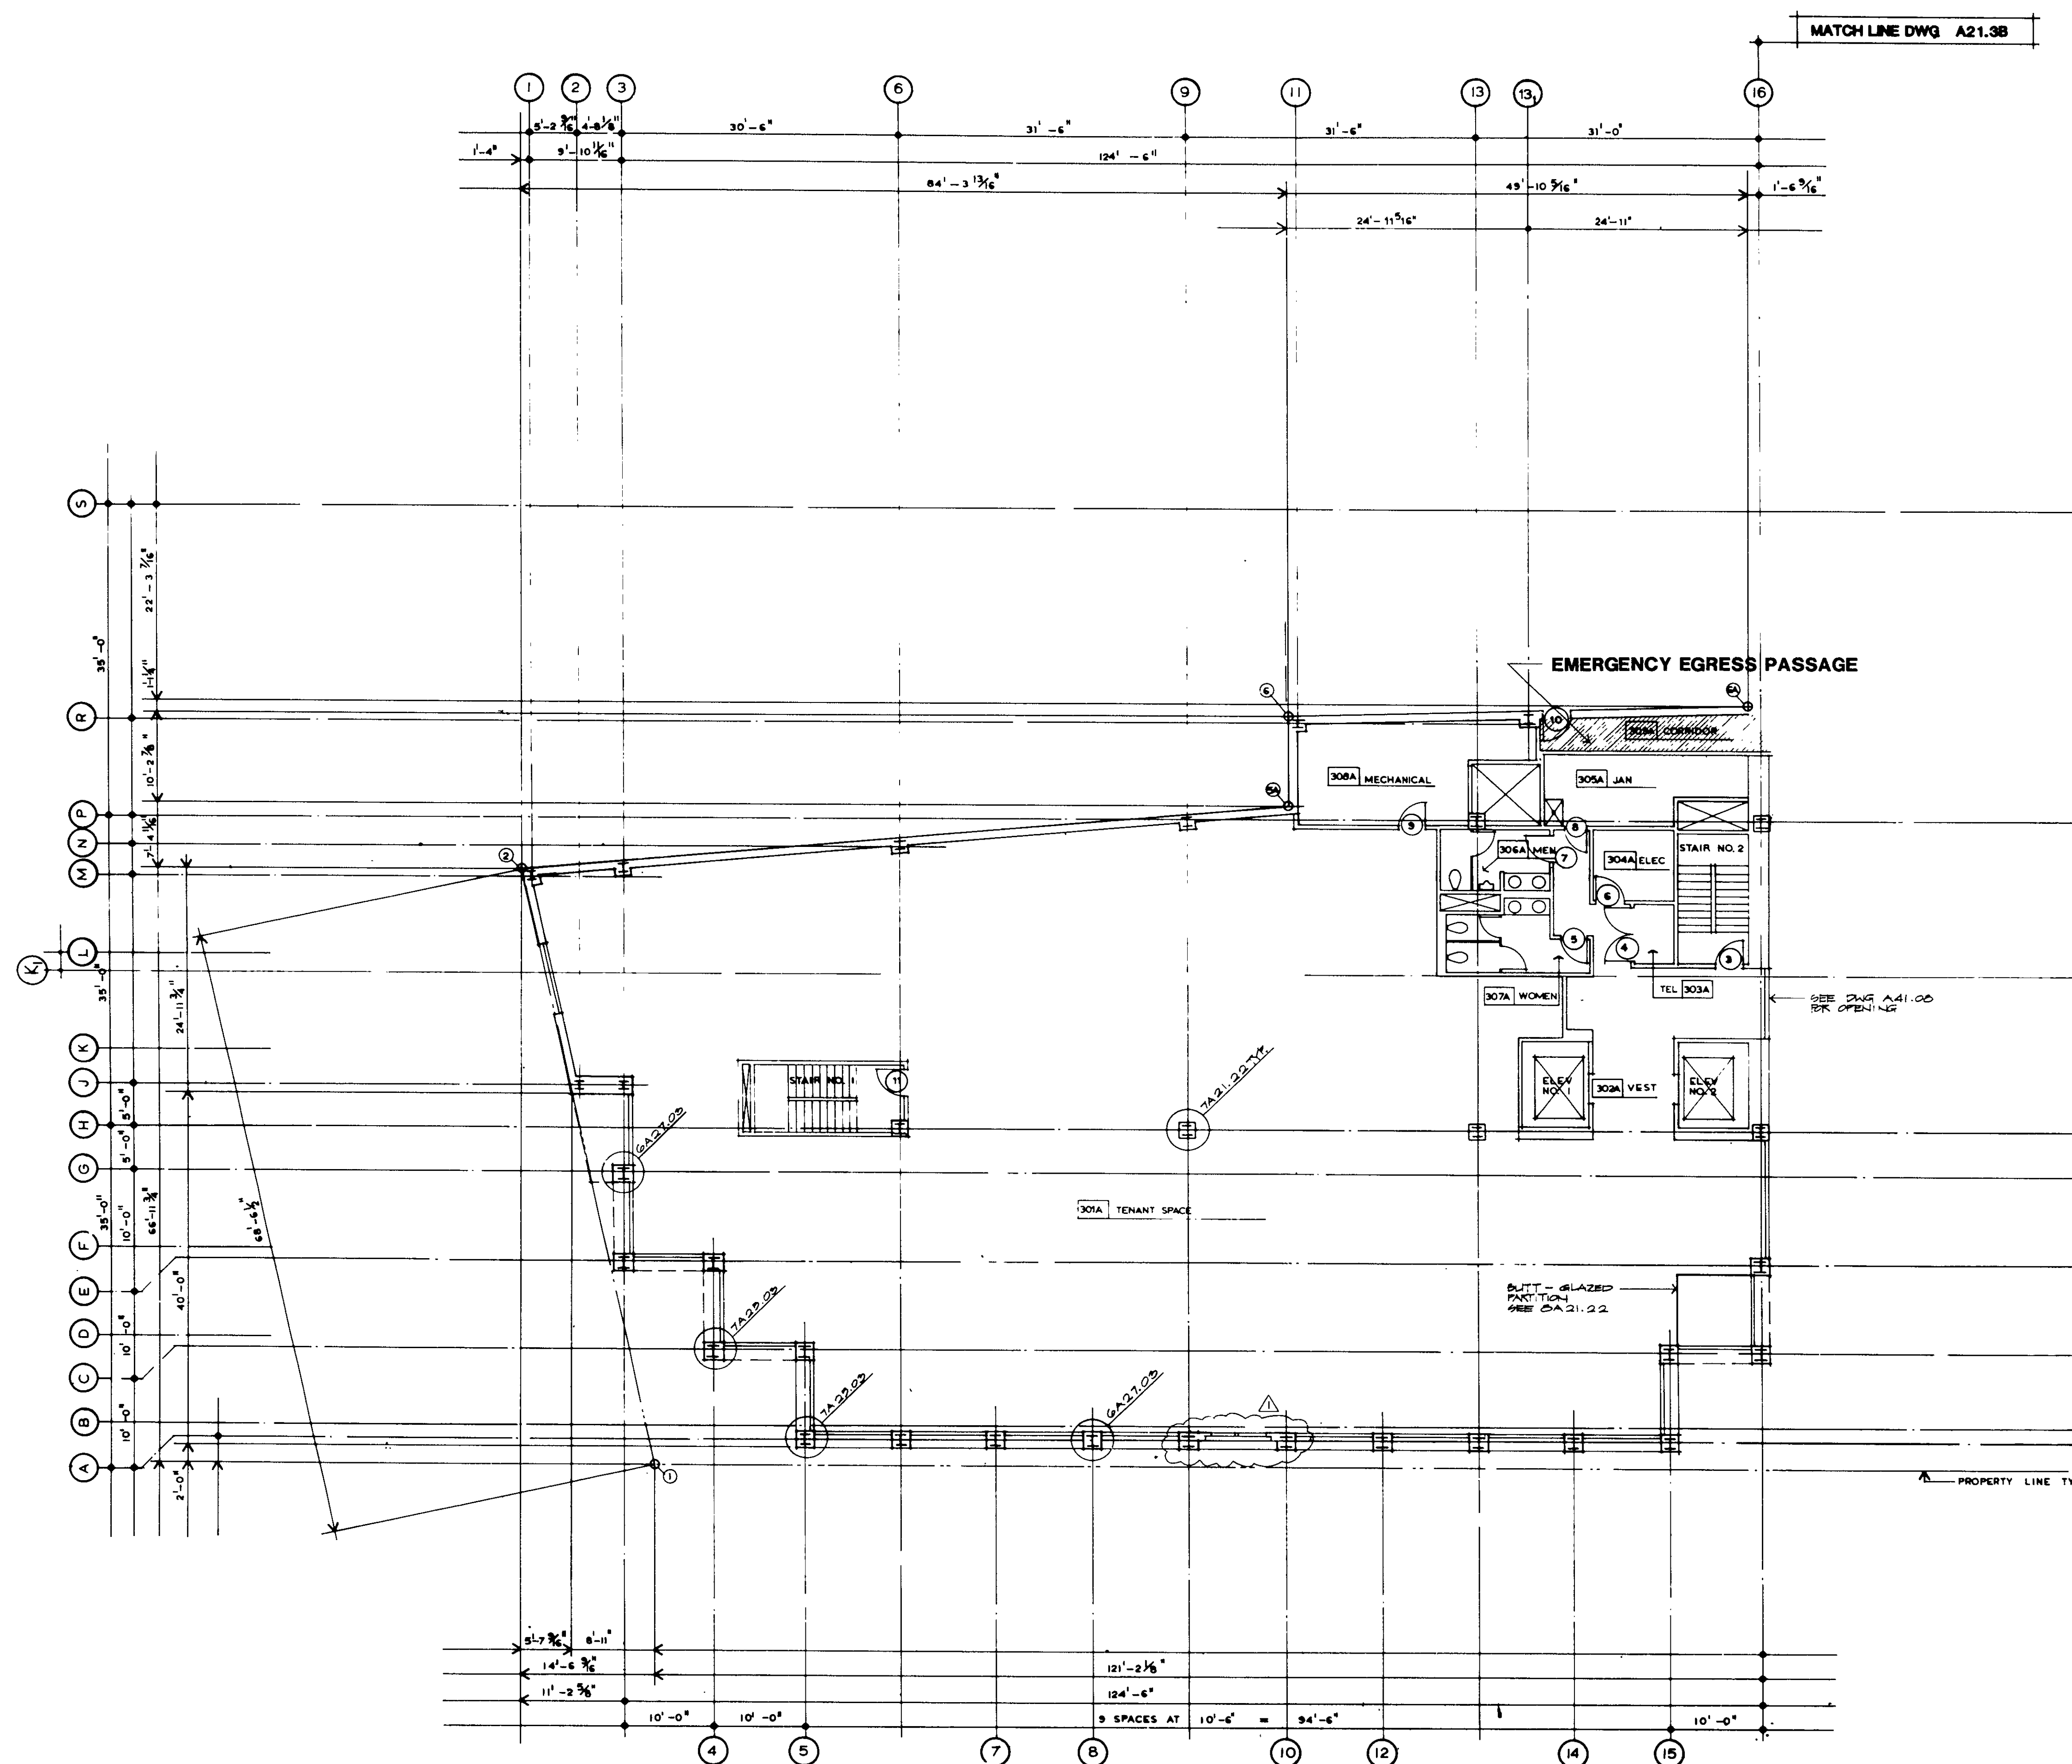



1571	