


1580-1

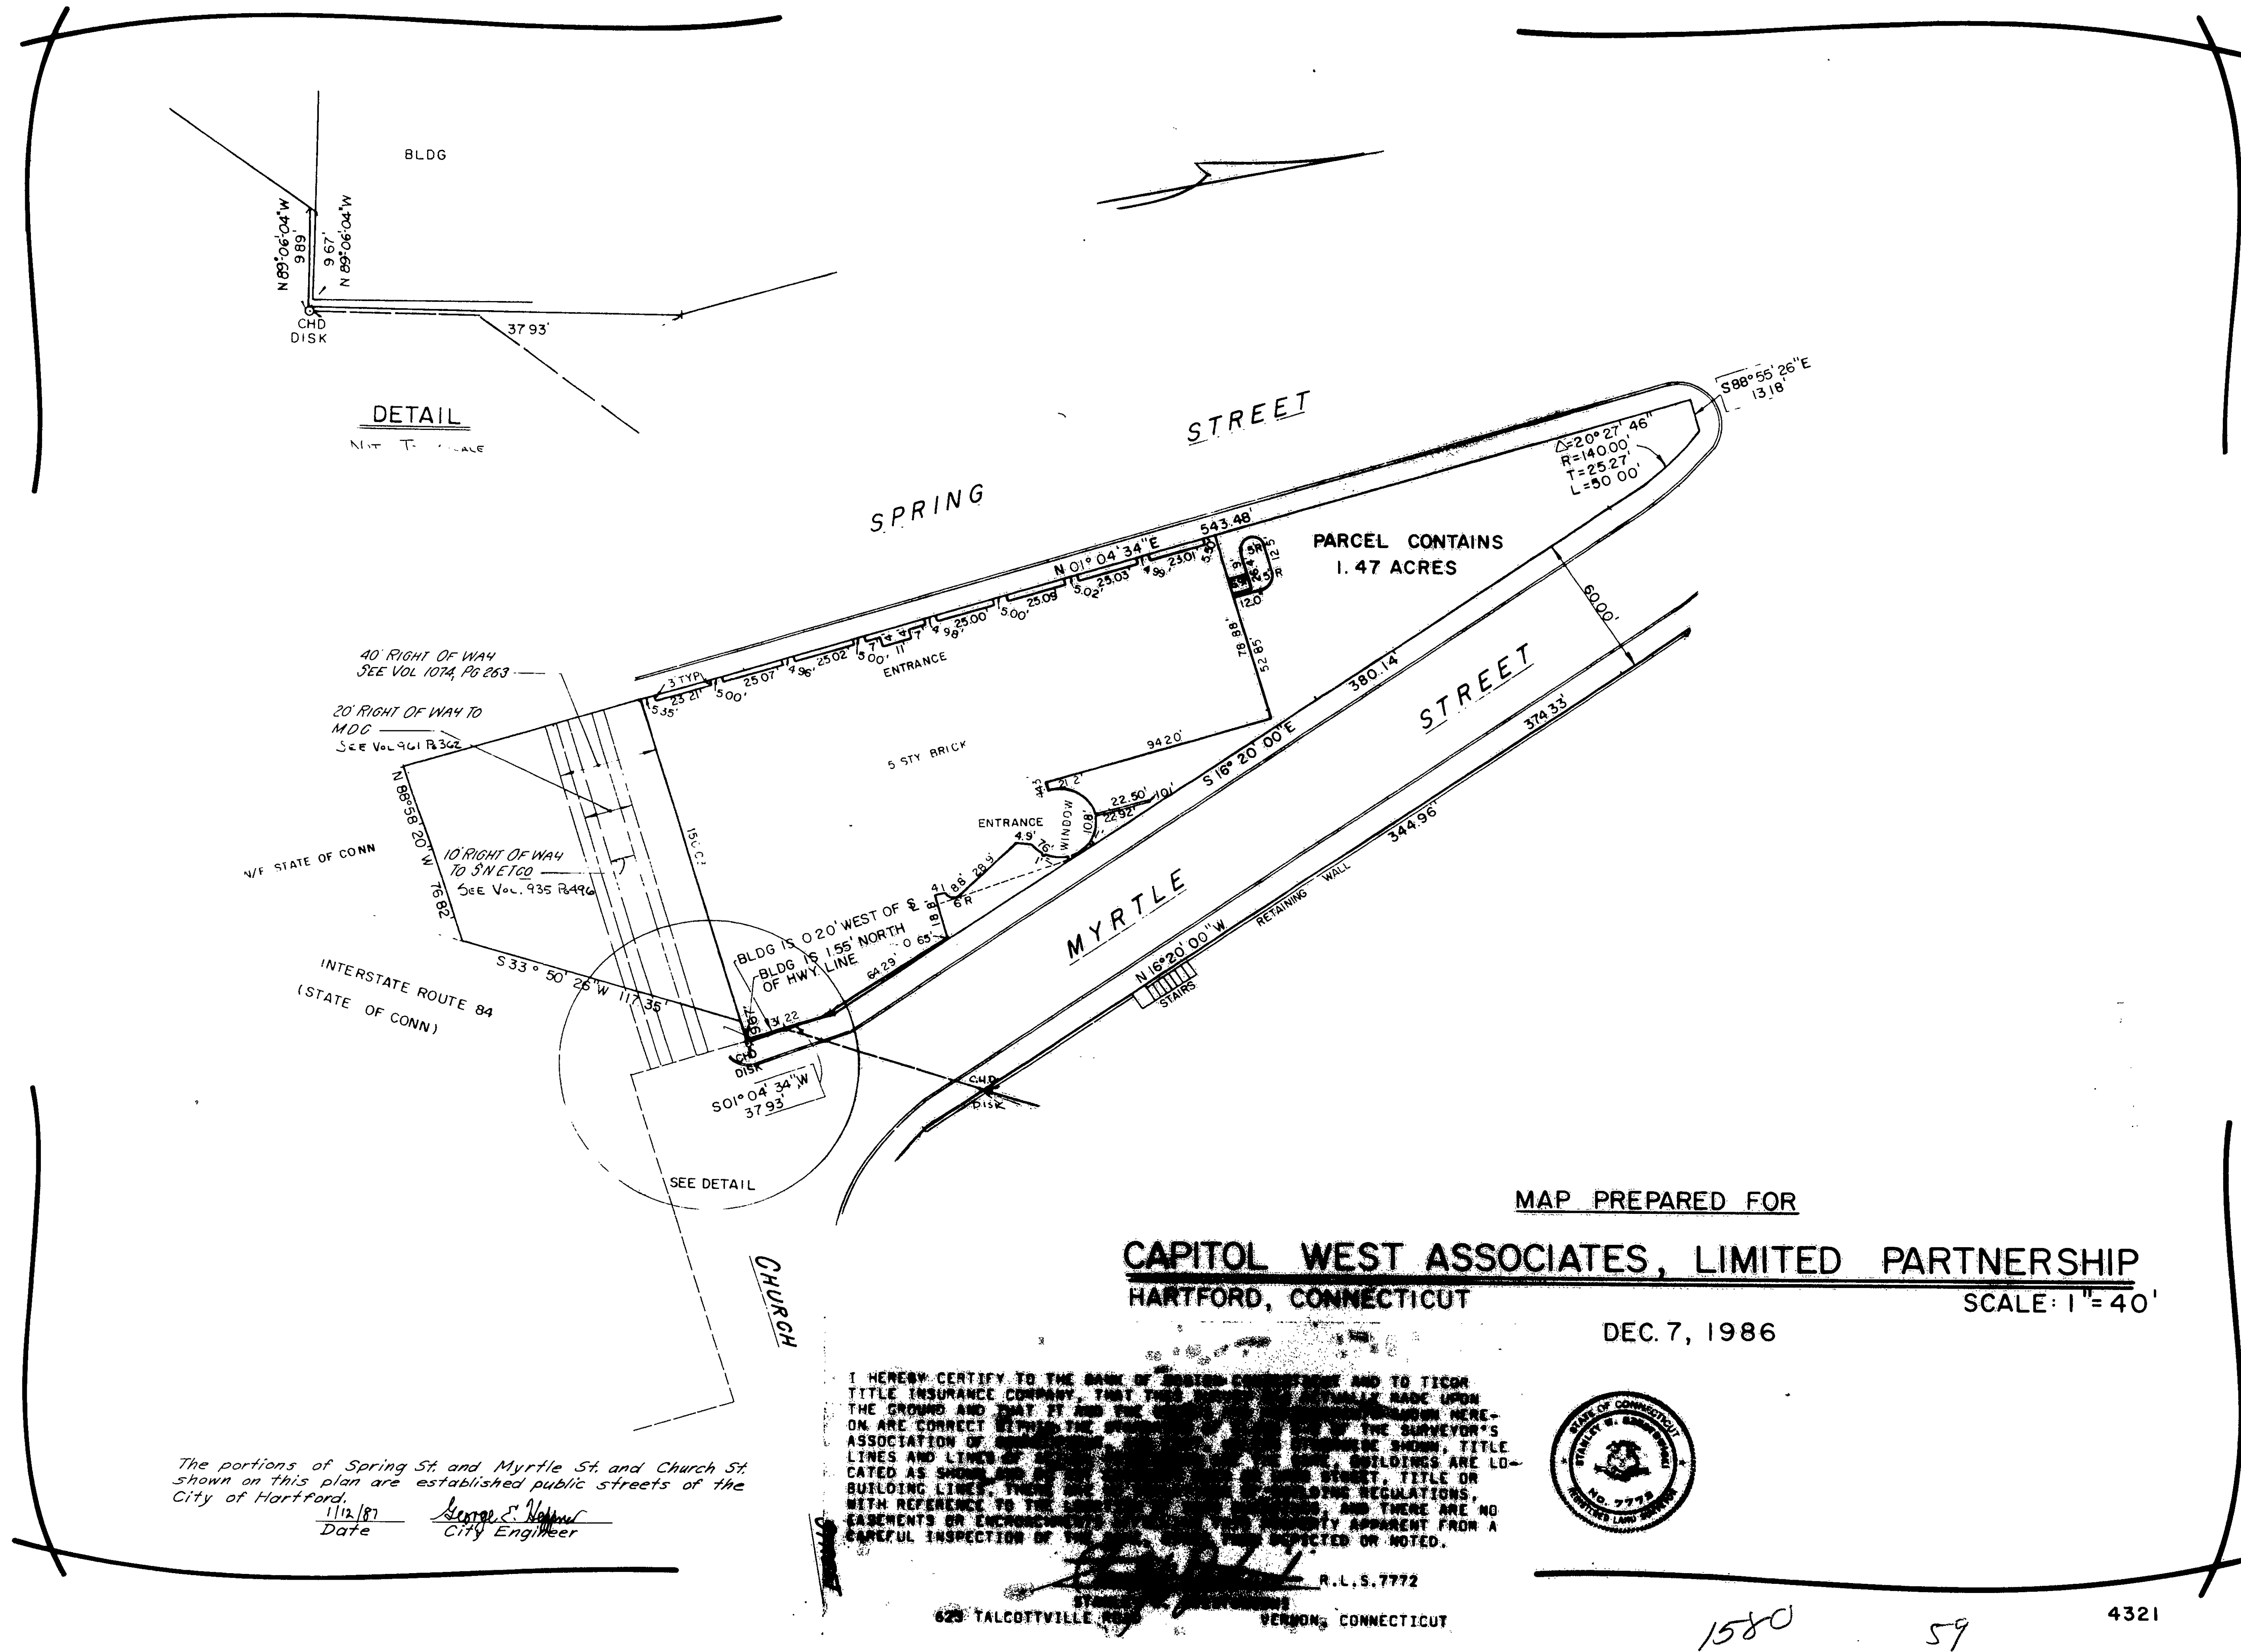

0 INCHES 1 2 3 4