



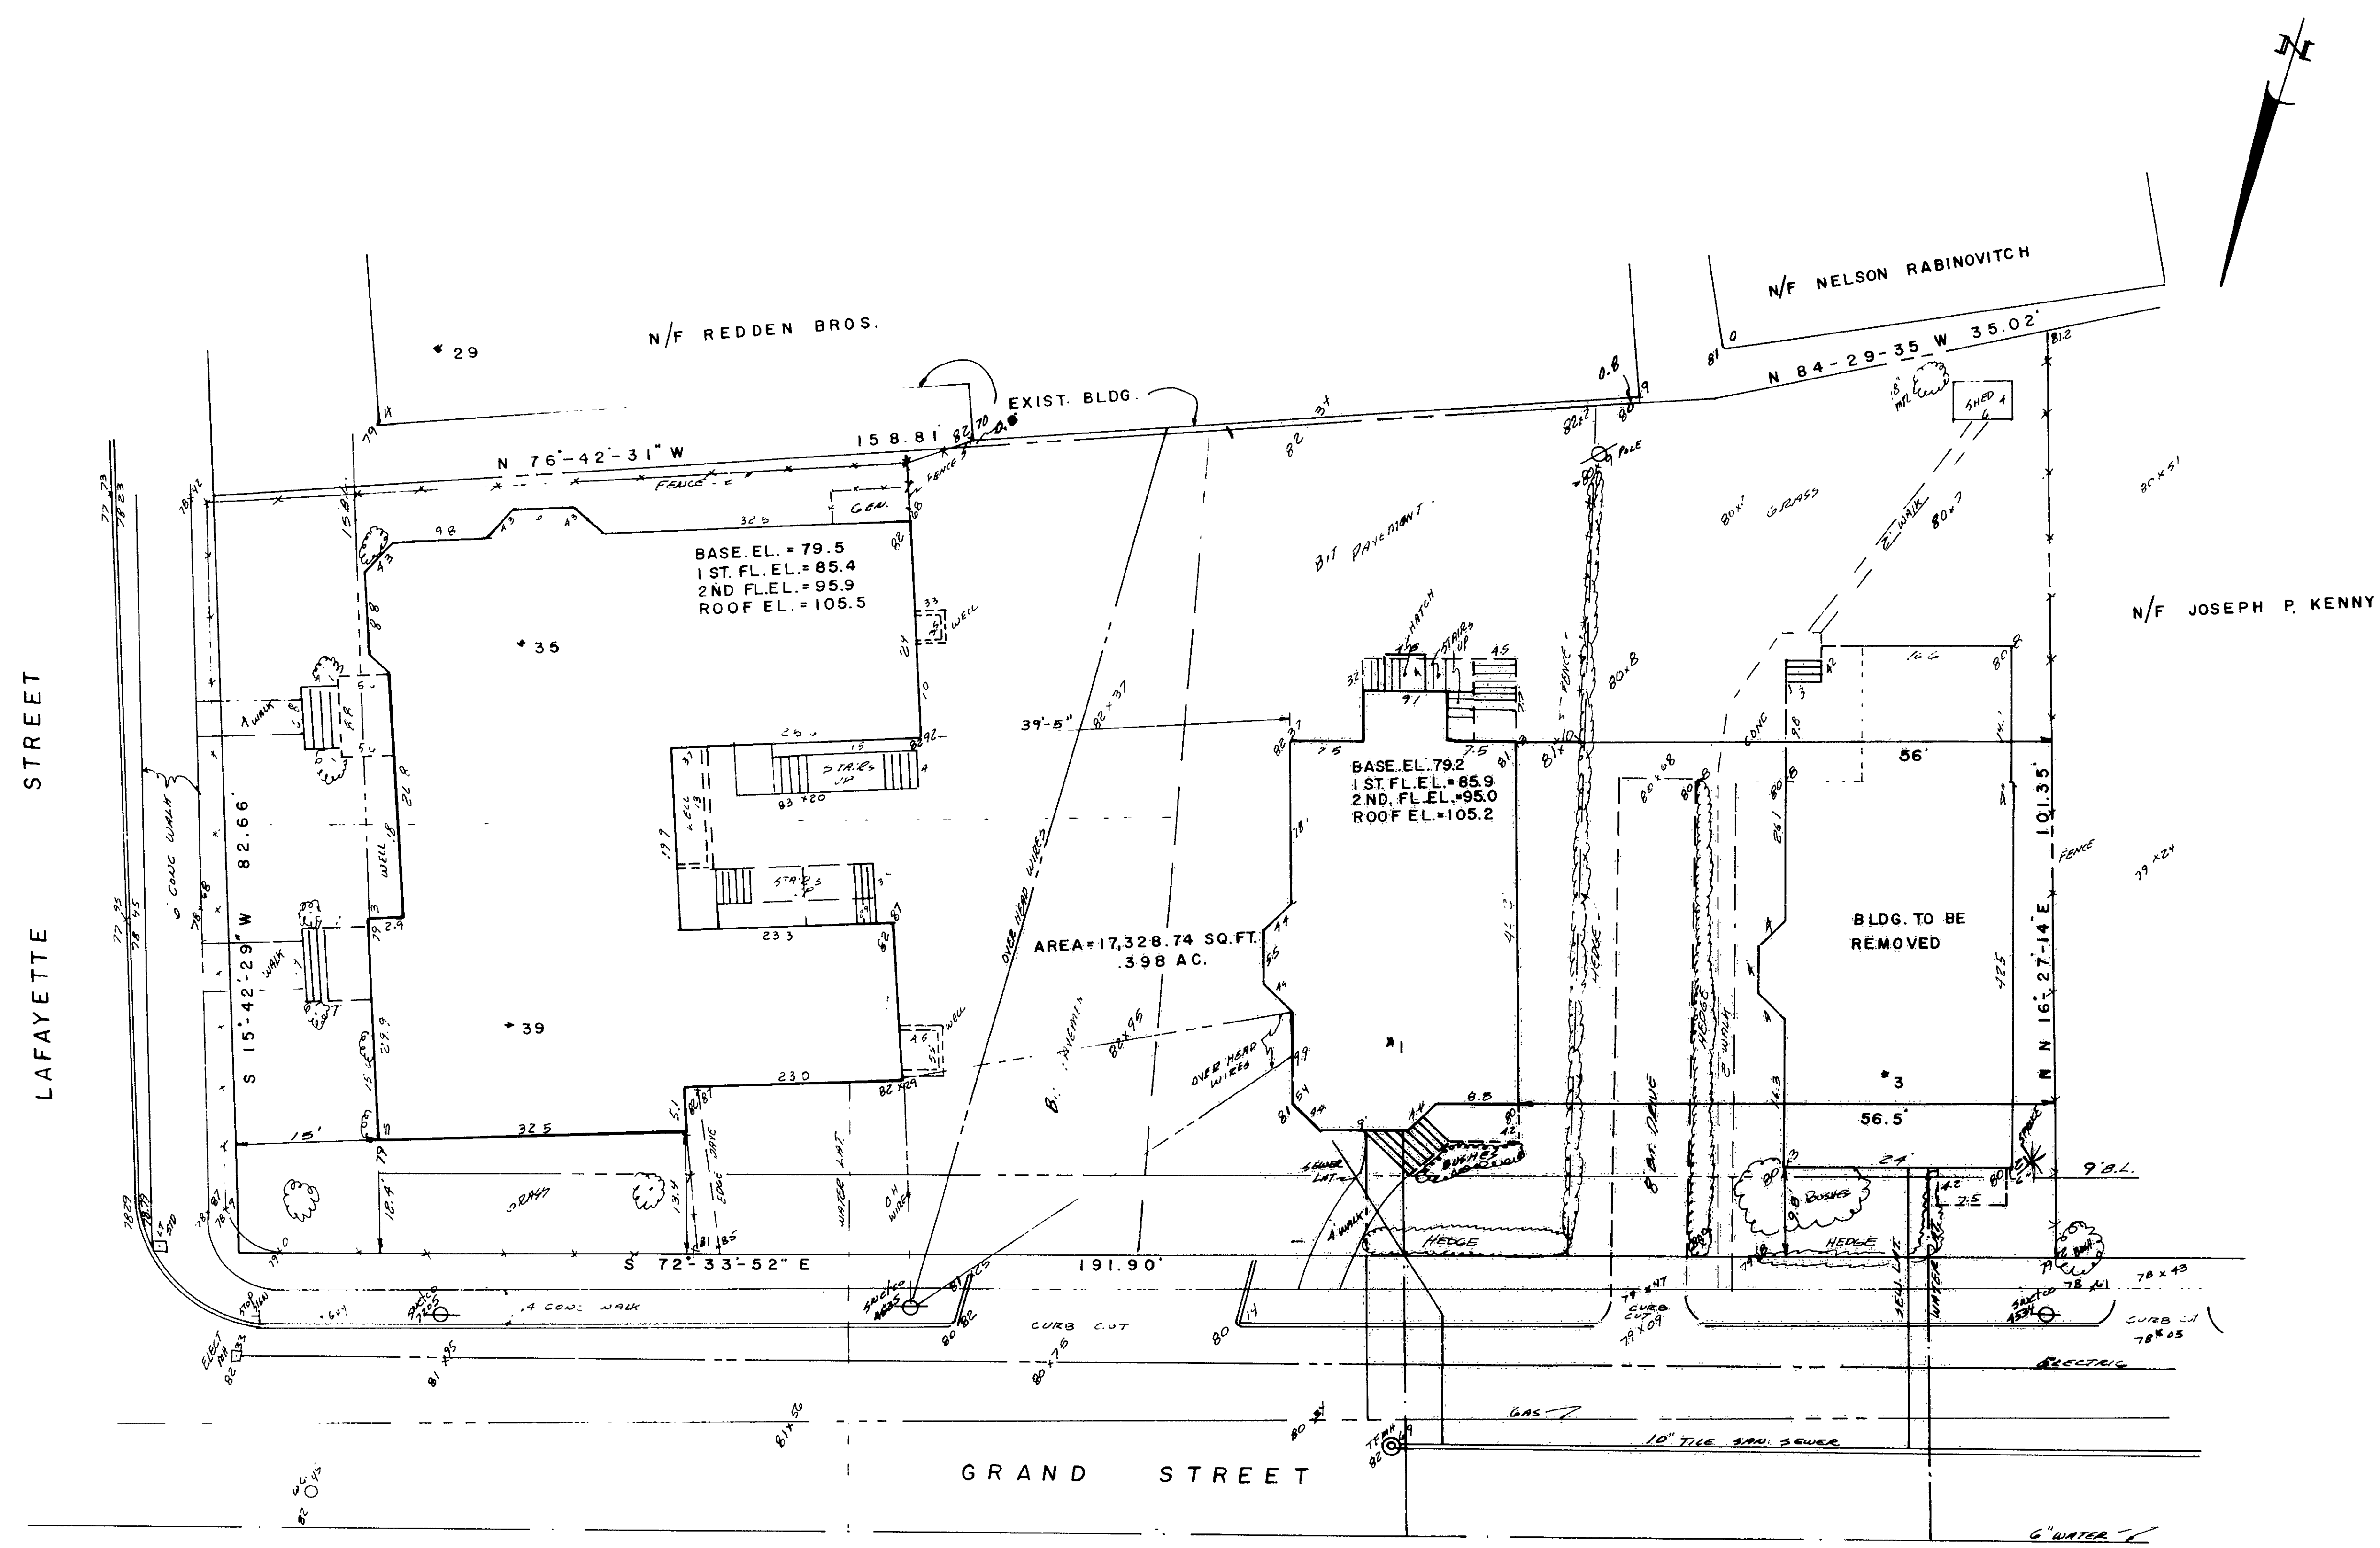

MAP REFERENCE:
 1. "PROPERTY OF LAFAYETTE PARK INC. TO BE CONVEYED TO G & F REALTY ASSOCIATES LAFAYETTE STREET & GRAND STREET HARTFORD CONNECTICUT 1"=10' JULY 17, 1978"
 2. "PROPERTY OF JAMES REDDEN, JOHN J. REDDEN & THOMAS REDDEN, 29 LAFAYETTE STREET HARTFORD, CONNECTICUT 1"=30' OCTOBER, 1964 REVISED JUNE 29, 1965 HANS S. JENSEN L.S."

I HEREBY CERTIFY THAT THIS MAP AND SURVEY WERE PREPARED IN ACCORDANCE WITH THE STANDARDS OF A CLASS A-2 SURVEY AS DEFINED IN THE CODE OF PRACTICE FOR STANDARDS OF ACCURACY OF SURVEYS AND MAPS, ADOPTED DECEMBER 10, 1975 AS AMENDED BY THE CONNECTICUT ASSOCIATION OF LAND SURVEYORS, INC.

ELEVATIONS BASED ON MDC DATUM

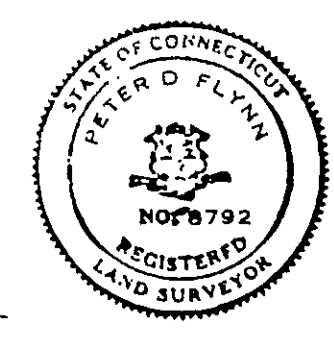

The portions of Lafayette St and Grand St shown on this plan are established public streets of the City of Hartford.
 1/21/87 Date
 City Engineer

PROPERTY OF
 G & F REALTY ASSOCIATES
 35-39 LAFAYETTE STREET
 1 & 3 GRAND STREET
 HARTFORD, CONNECTICUT
 1"=10' NOVEMBER 24, 1986
 FLYNN LAND SURVEYING ASSOC.
 NEWINGTON, CONNECTICUT

John R. 2-28-87
 1587

1587

1587