


RECEIVED BY

Deborah A. Lynch

FEB 11 3 31 PM '87

TOWN CLERK
HARTFORD

VOL. _____ PAGE _____

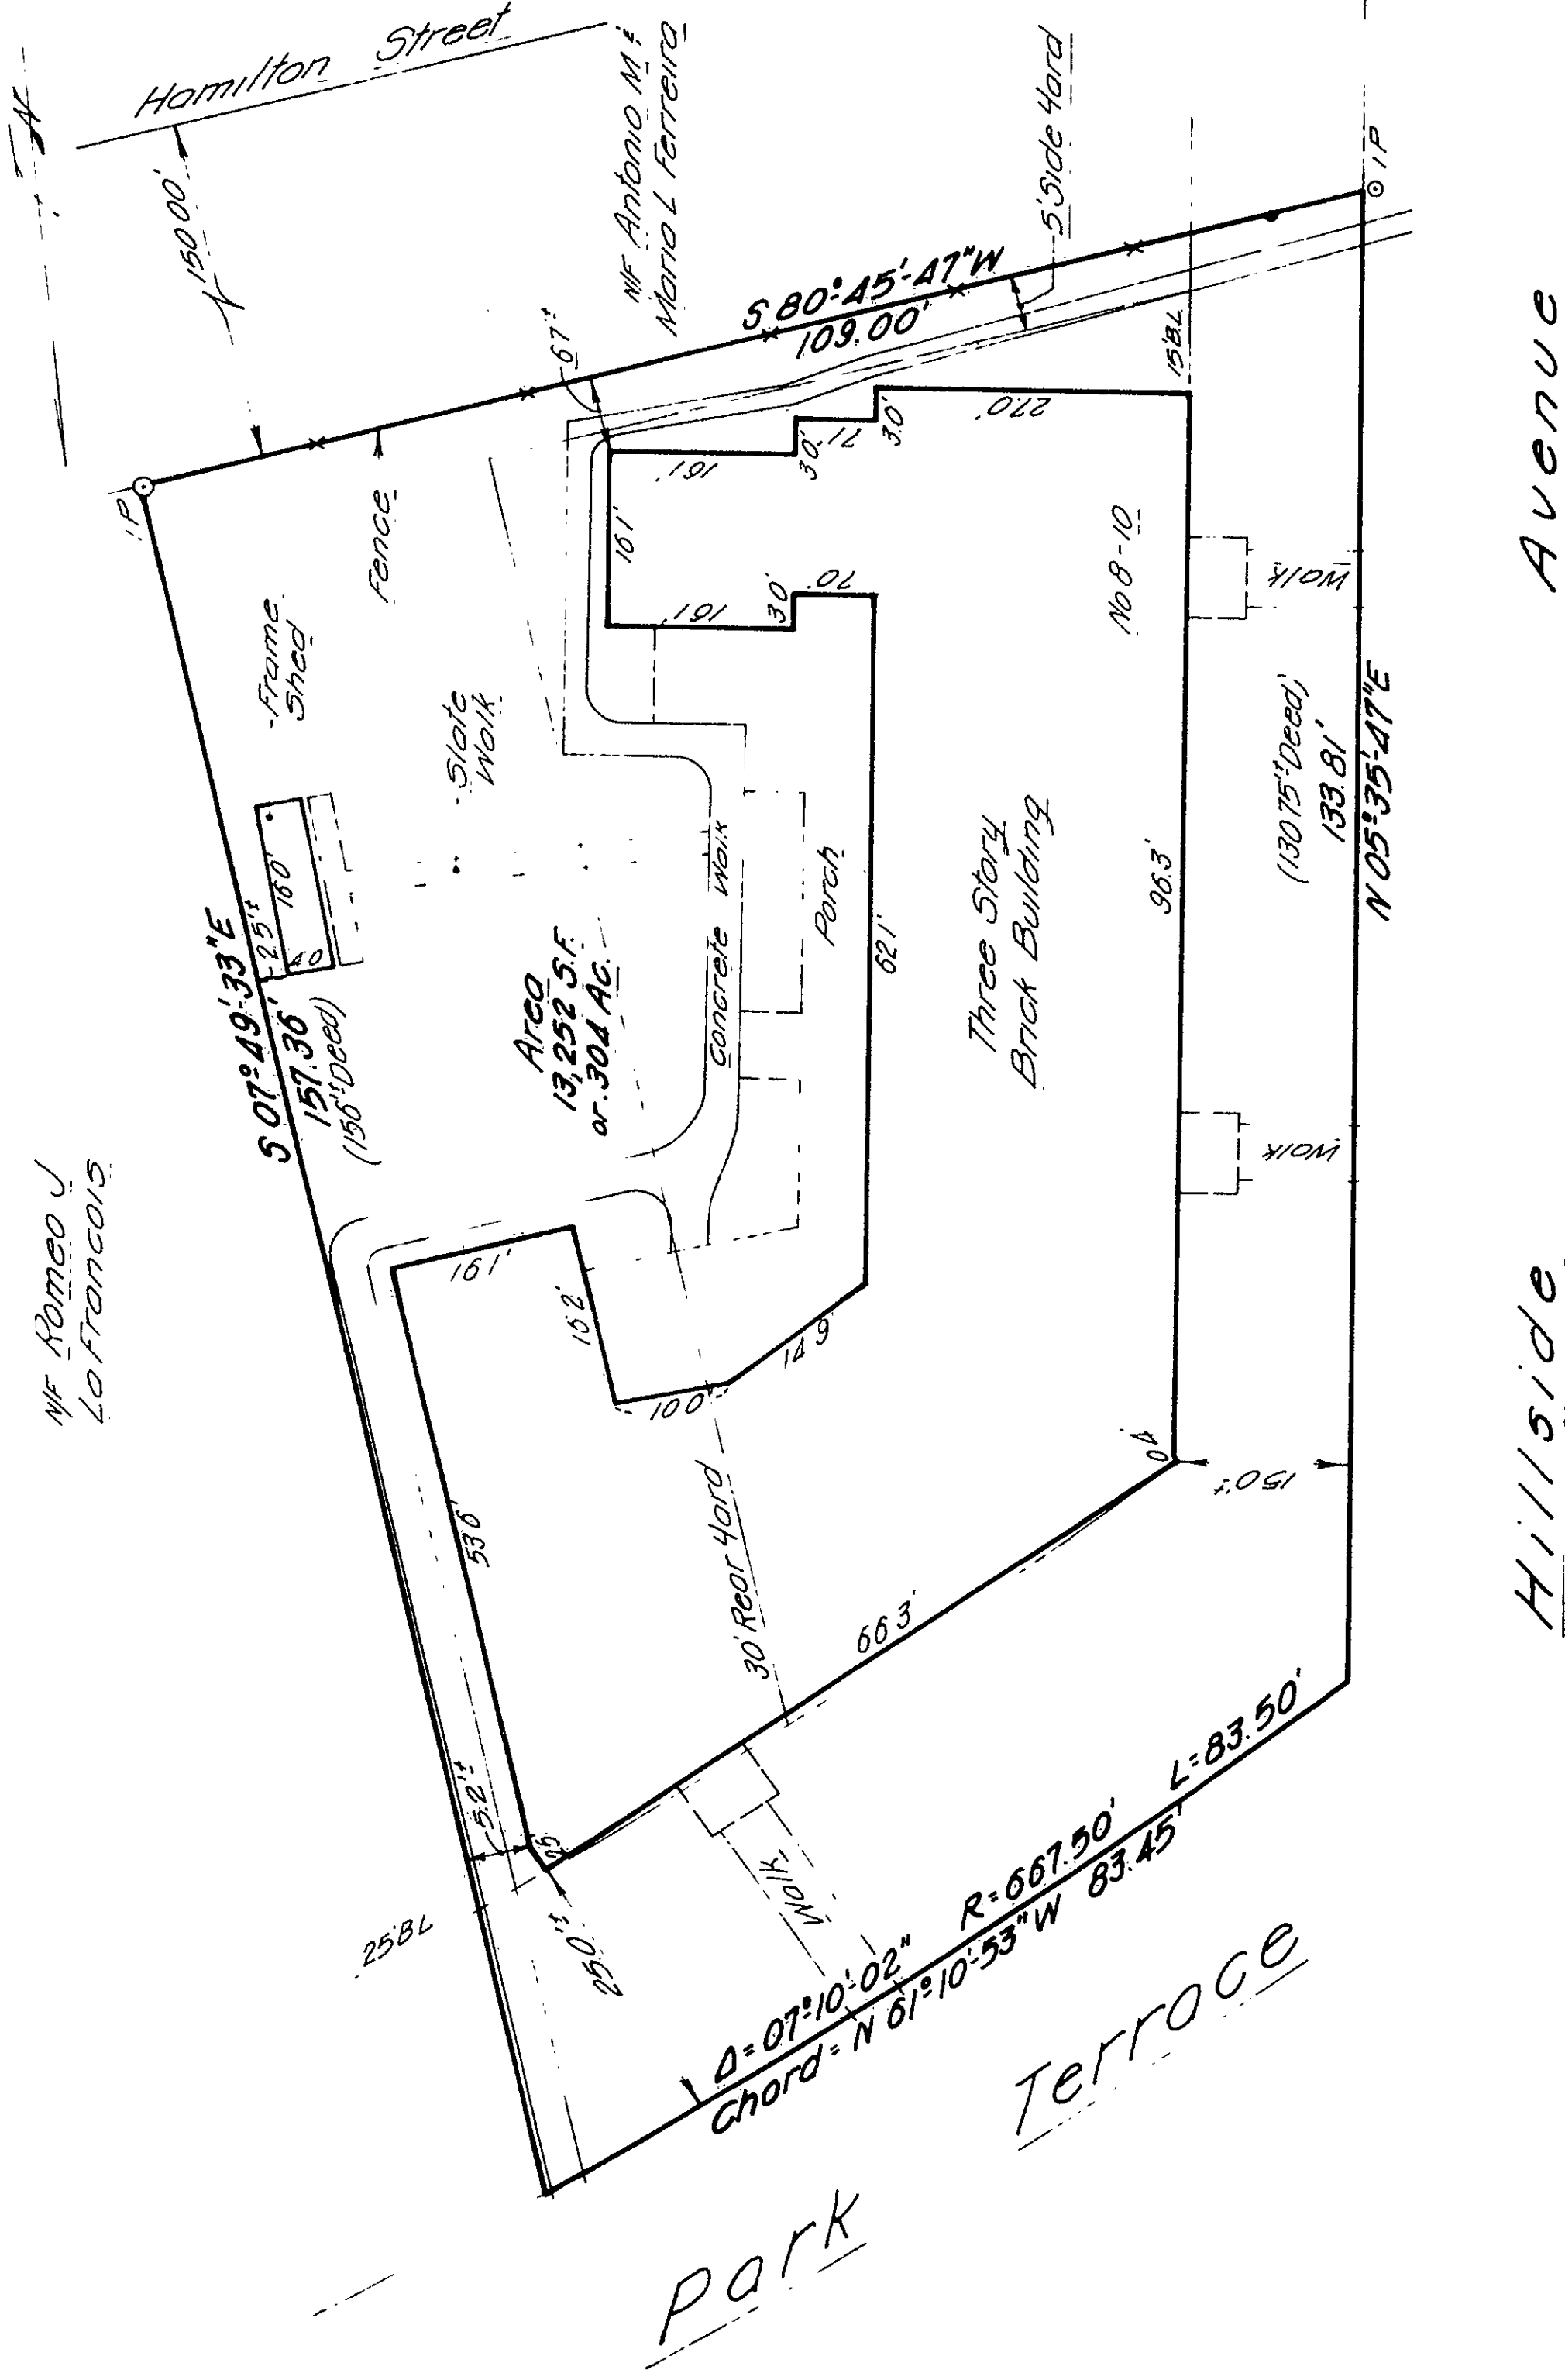

The Bank of Hartford Inc. as a
Chicago Title Insurance Company

that this map, which shows physical conditions existing
at this date, is substantially correct in accordance
with the standards of a CLASS A0 survey and that
zoning regulations are not violated other than those
depicted hereon

CLOSE, JENSEN & MILLER
Civil Engineers & Surveyors

By *John H. Miller*


Notes:

Property is in an RI Zone
Rear Yard Non-Covering
Under Present Zoning
Buildings Cover 35.6% of Area

The portions of Park Terr and Hillside Ave. shown on this plan
are established public streets of the City of Hartford.
City Engineer

C. J. Miller

Close, Jensen & Miller
Consulting Engineers, Land Planners & Surveyors
1137 Silas Deane Highway, Wethersfield, Connecticut 06104

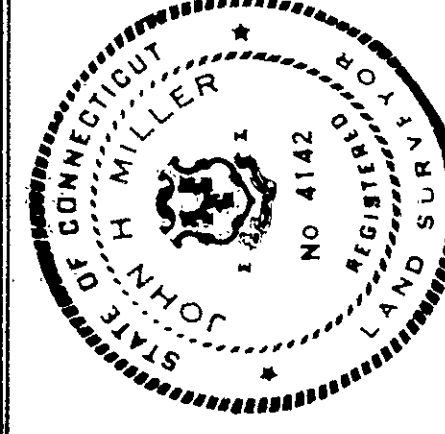

Property of
Deborah A. Lynch Jr.
340-342 Park Terrace
2-10 Hillside Avenue
Hartford, Connecticut

Designed
Drawn
Checked
Scale
Date

Sheet No. ONE

Of ONE

Job No. 9208

File No. 1



1581

69