


Hartford Hospital
First National Bank of Boston
Connecticut General Life Insurance Company,
First American Life Insurance Company,
hereby certify to the accuracy of the
survey shown upon the ground on 2-12-66, and
that this survey was actually made upon the ground on 2-12-66, and
at it and the bounds and measurements shown hereon are correct
within the standards of a Class A survey as defined in the Code
of Practice for Standards of Accuracy of Surveys and Maps, adopted
December 10, 1975, and as amended by the Connecticut Association of
Land Surveyors, Inc. and that, unless otherwise shown, deed lines
and lines of actual possession of the same buildings are located
as shown and do not encroach upon or upon street, dead or building
lines, there are no violations of zoning regulations with reference
to the location of said buildings and there are no easements or
encroachments affecting this property apparent from a careful in-
spection of the same, other than those noted and depicted hereon.
LOSE, JENSEN & MILLER
Civil Engineers & Surveyors
By *John A. Miller*

The location of the underground utilities shown
on this plan have been obtained from the best
available sources. The actual location of these
utilities should be verified in the field by the
owner.

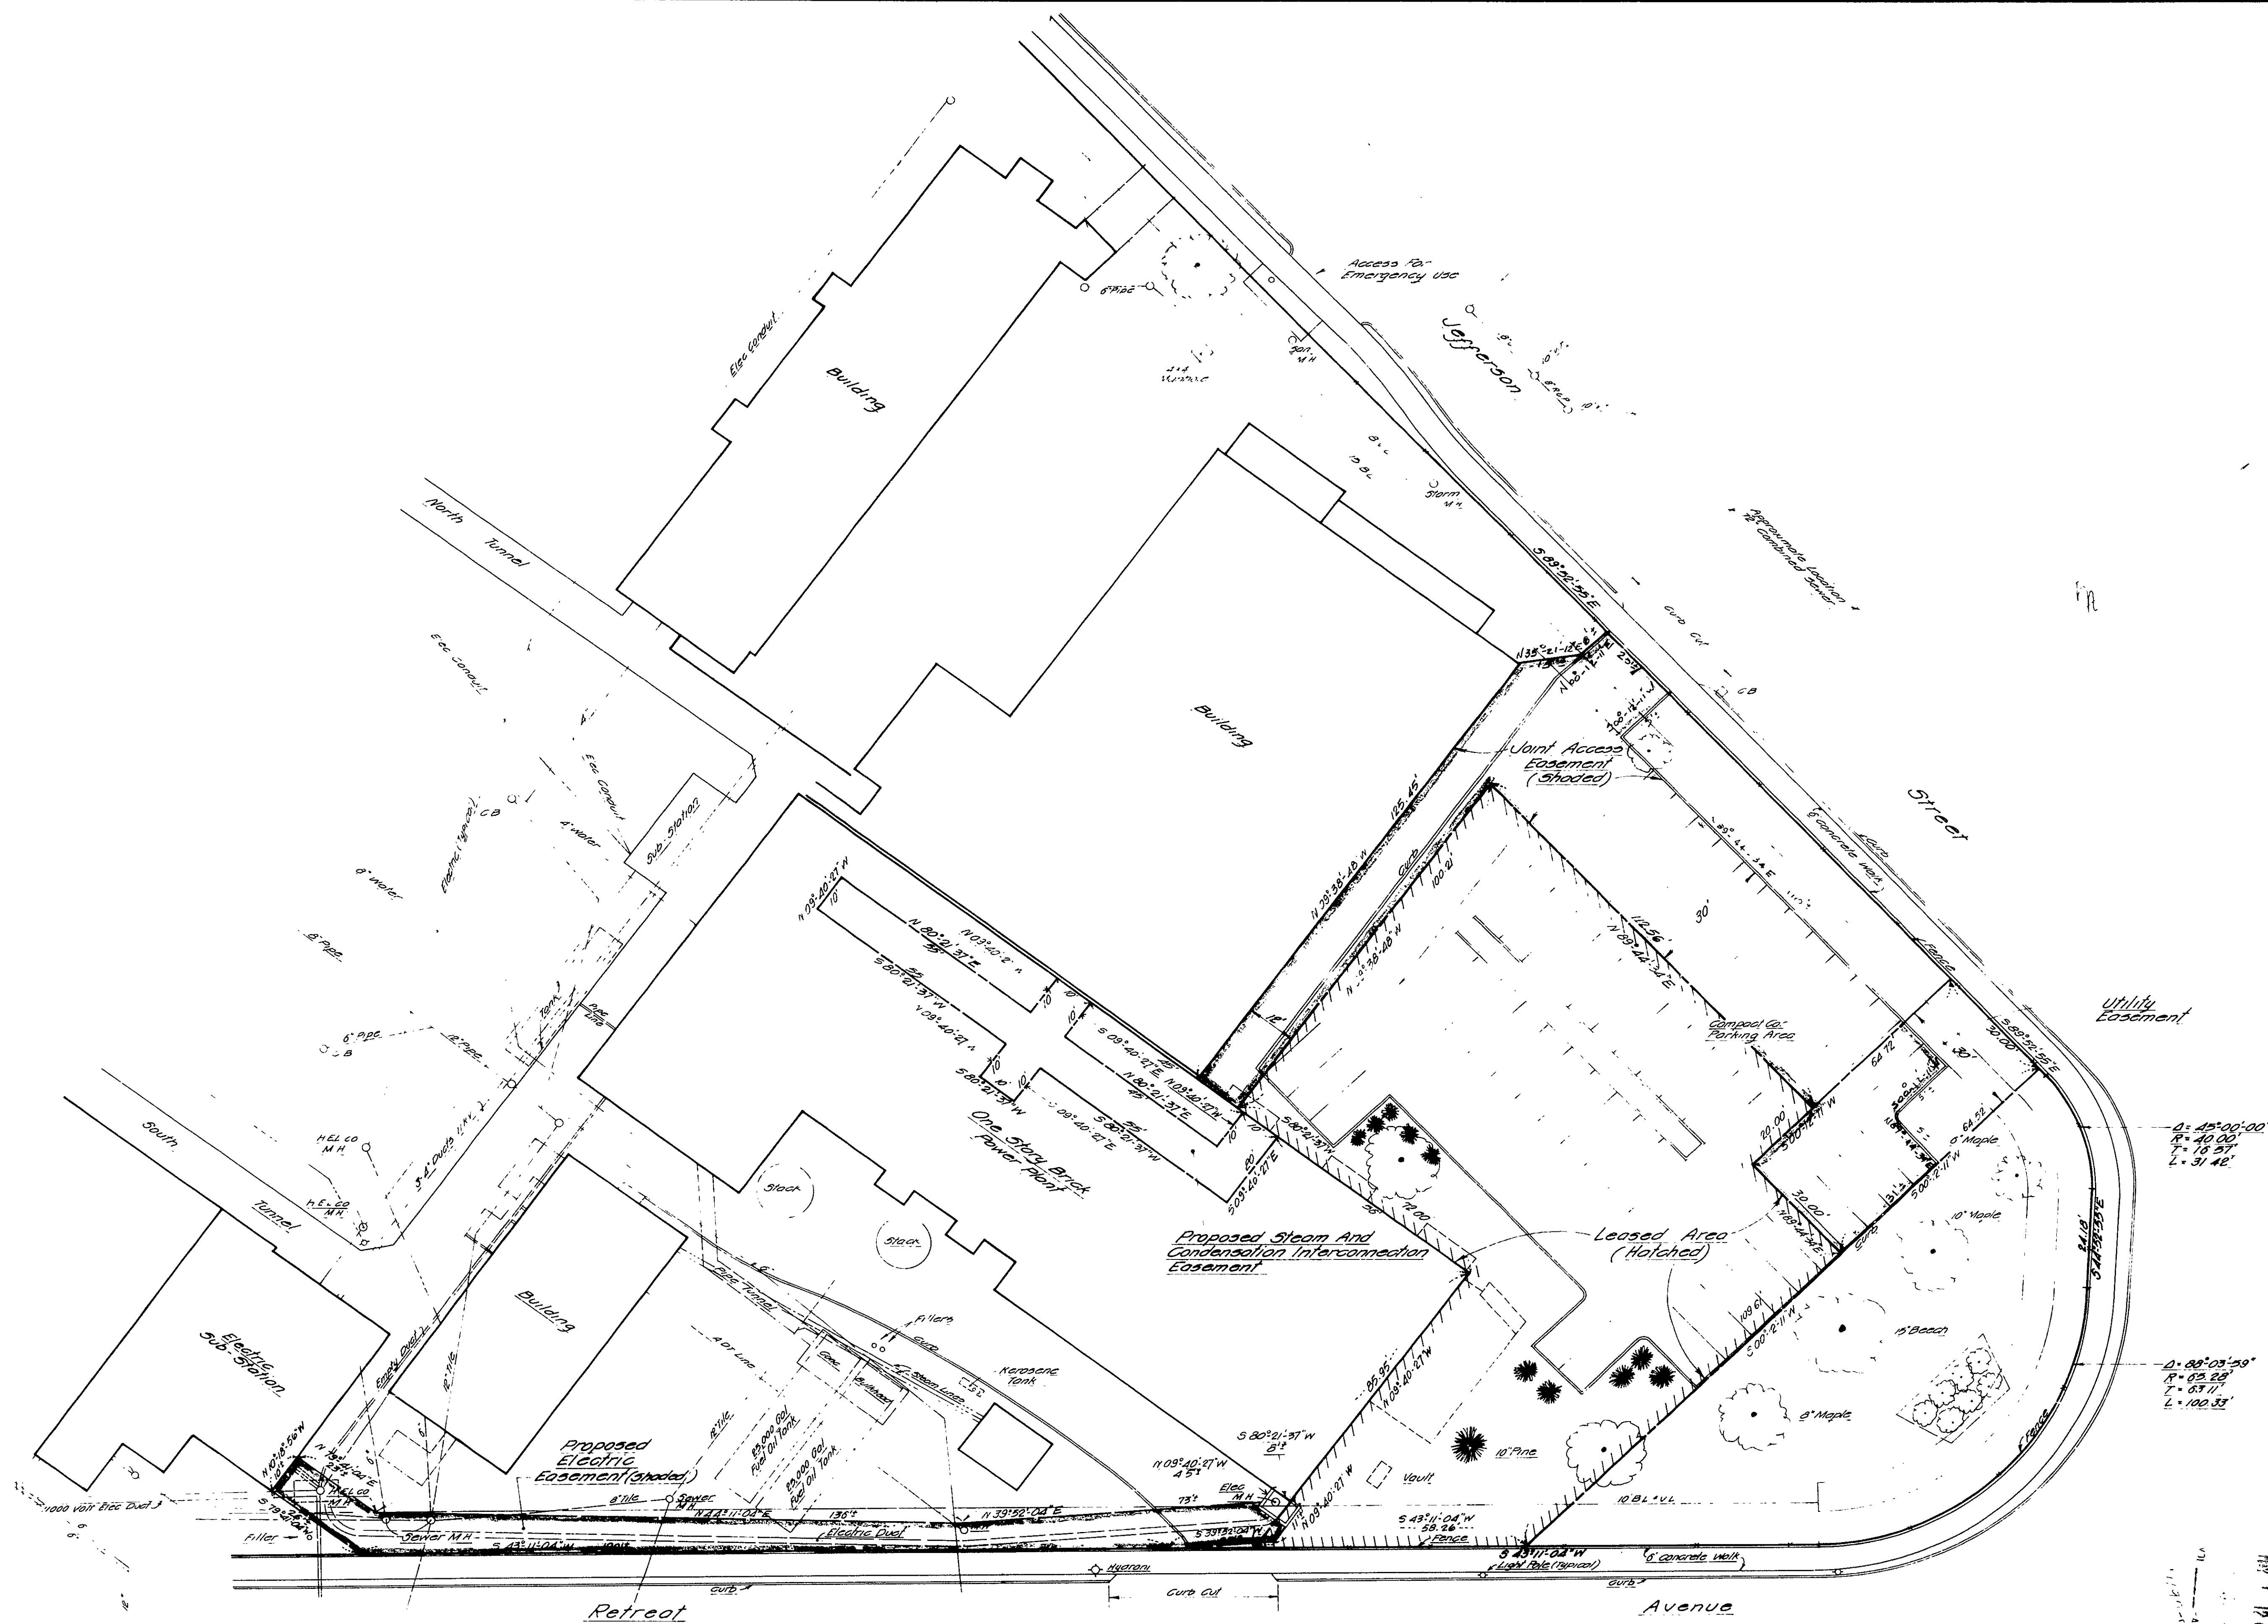

The portions of Jefferson St. and Retreat Ave. shown on this
plan are established public streets of the City of Hartford.
Date 2/5/67
City Engineer

L. 3-21-67 Elec. Easement Distances Added No. Date Description Revisions		E. J. M. Consulting Engineers, Land Planners & Surveyors 1137 Silas Deane Highway Wethersfield, Connecticut 06109		Designed Drawn Checked Scale Date
No. Date Description Revisions		Hartford Hospital Jefferson Street & Retreat Avenue Hartford, Connecticut		Sheet No. 002 Of One Job No. File No.

#113/600