


EASI FILE CORP IRVINE CA	EFM 34
1623	

1623-1

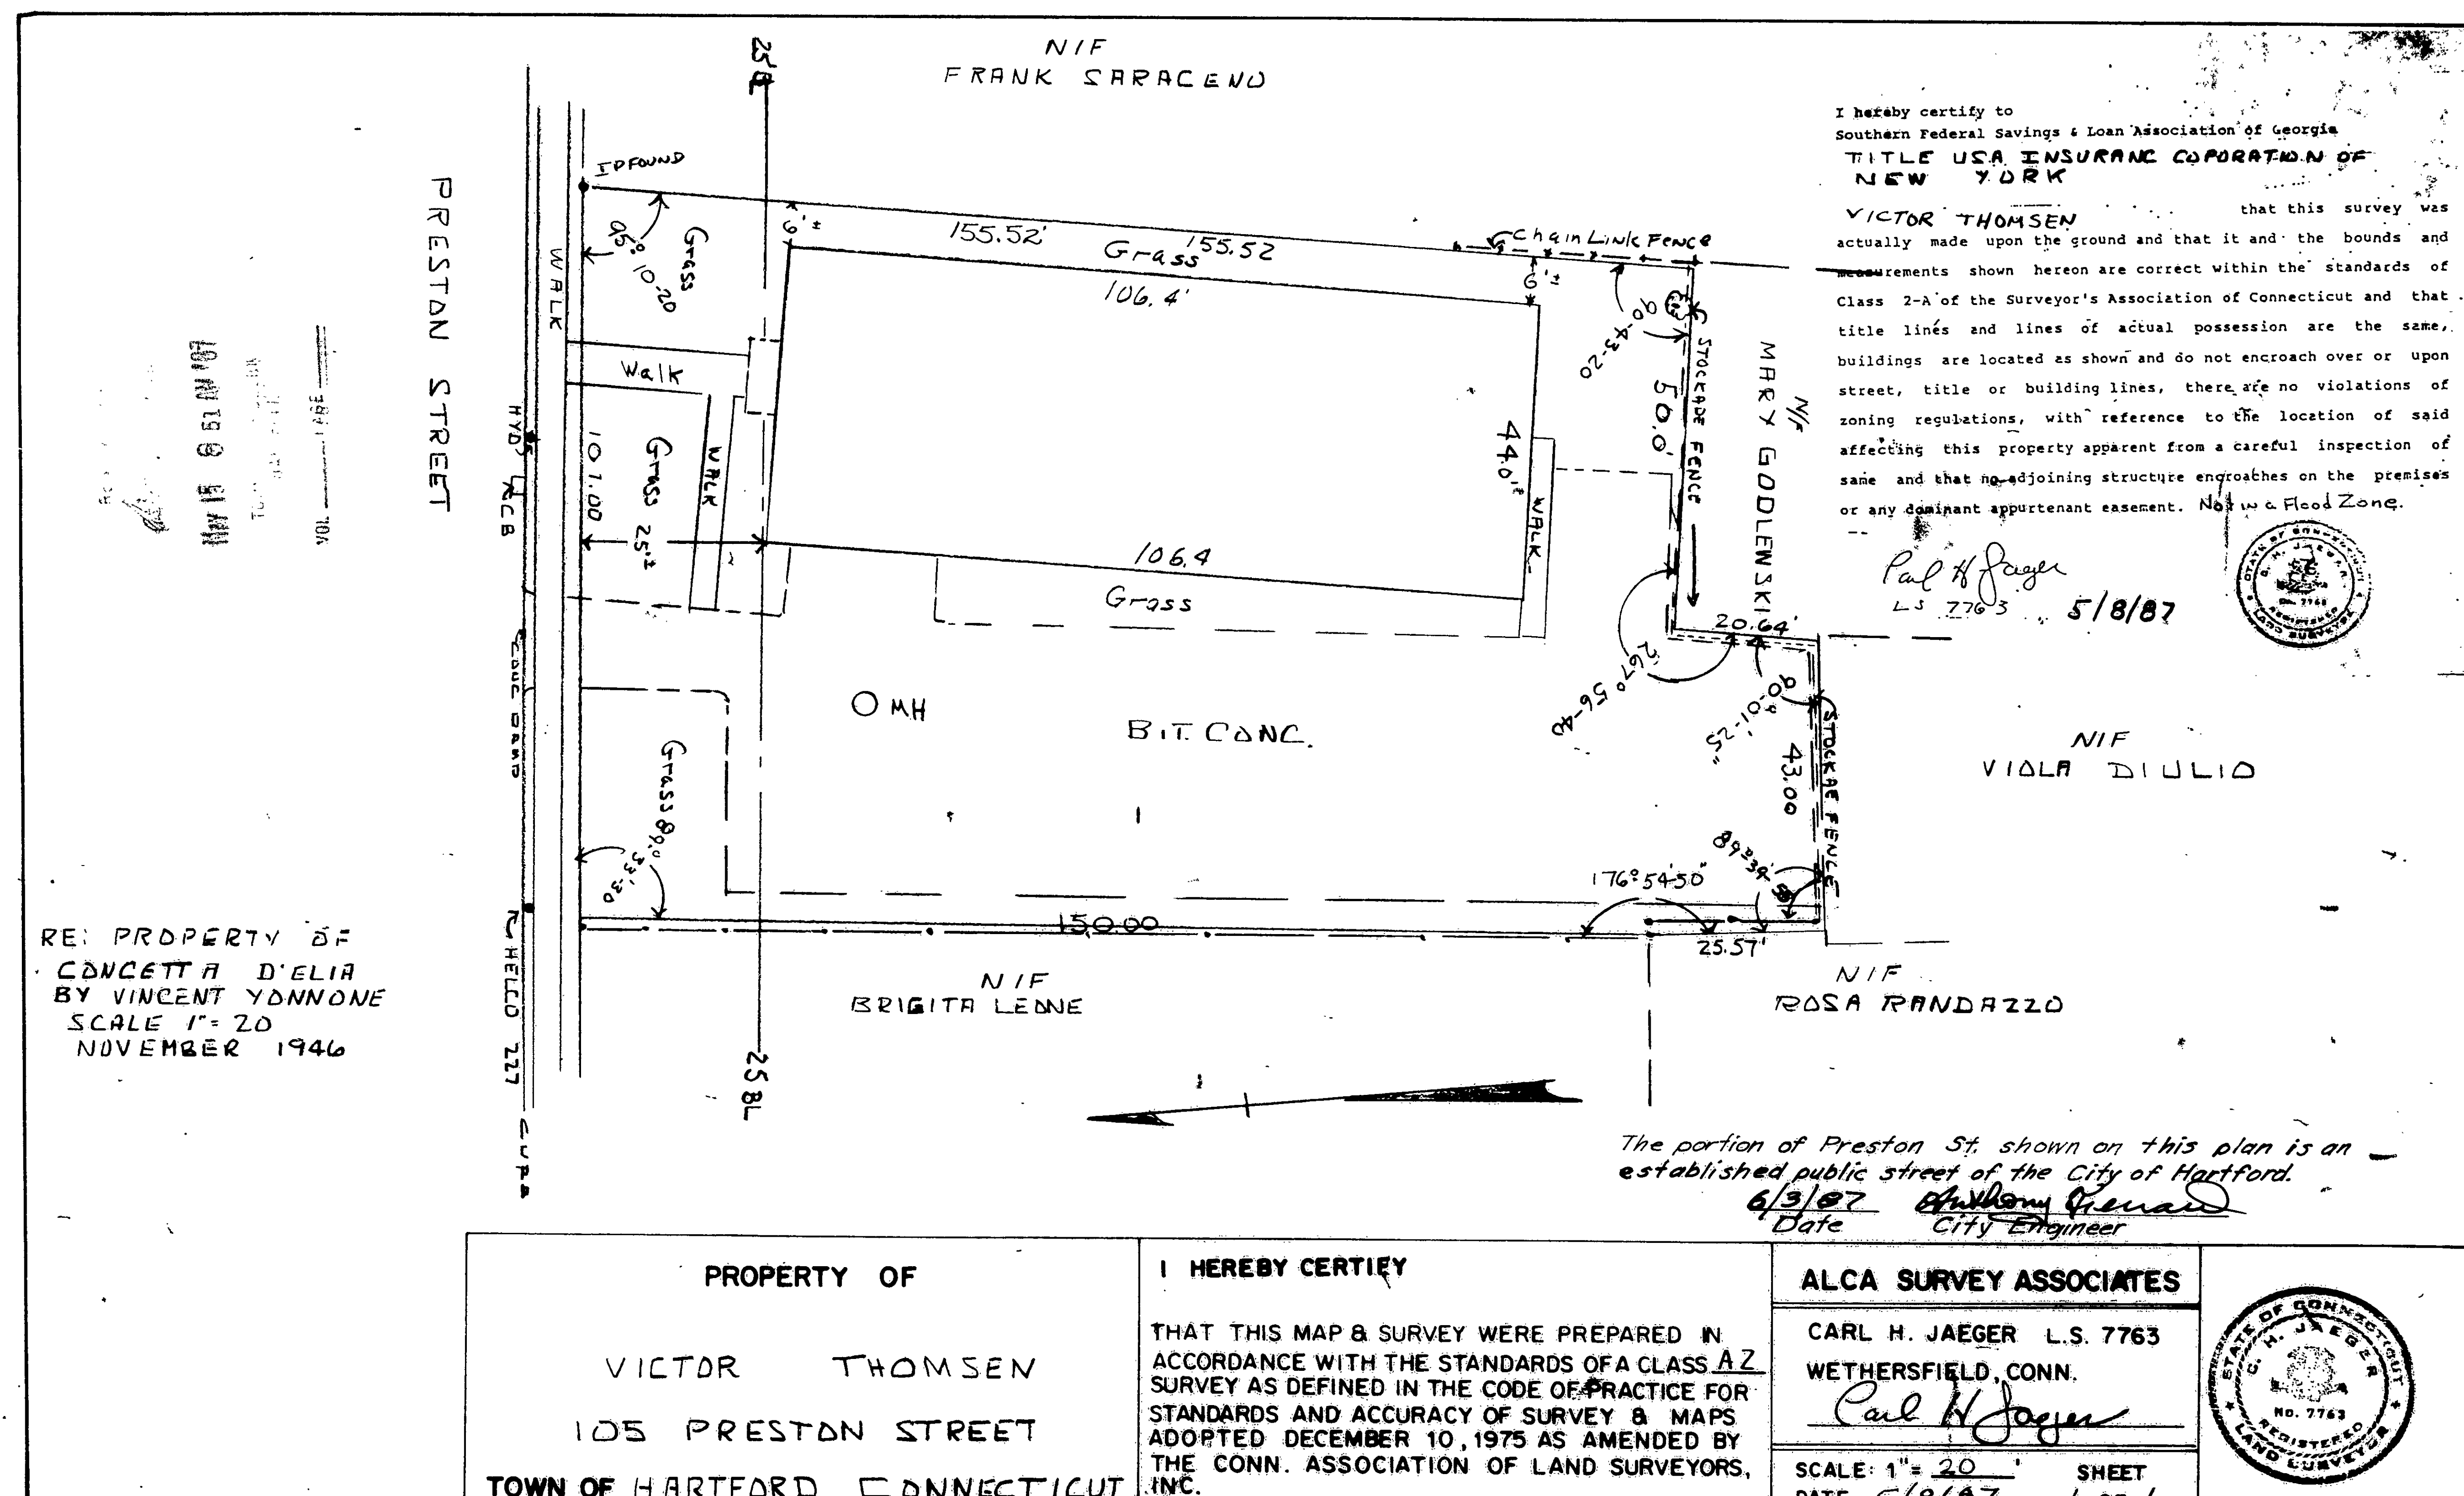

The portion of Preston St. shown on this plan is an established public street of the City of Hartford.
6/3/87 Anthony Gennaro
Date City Engineer

