


1666

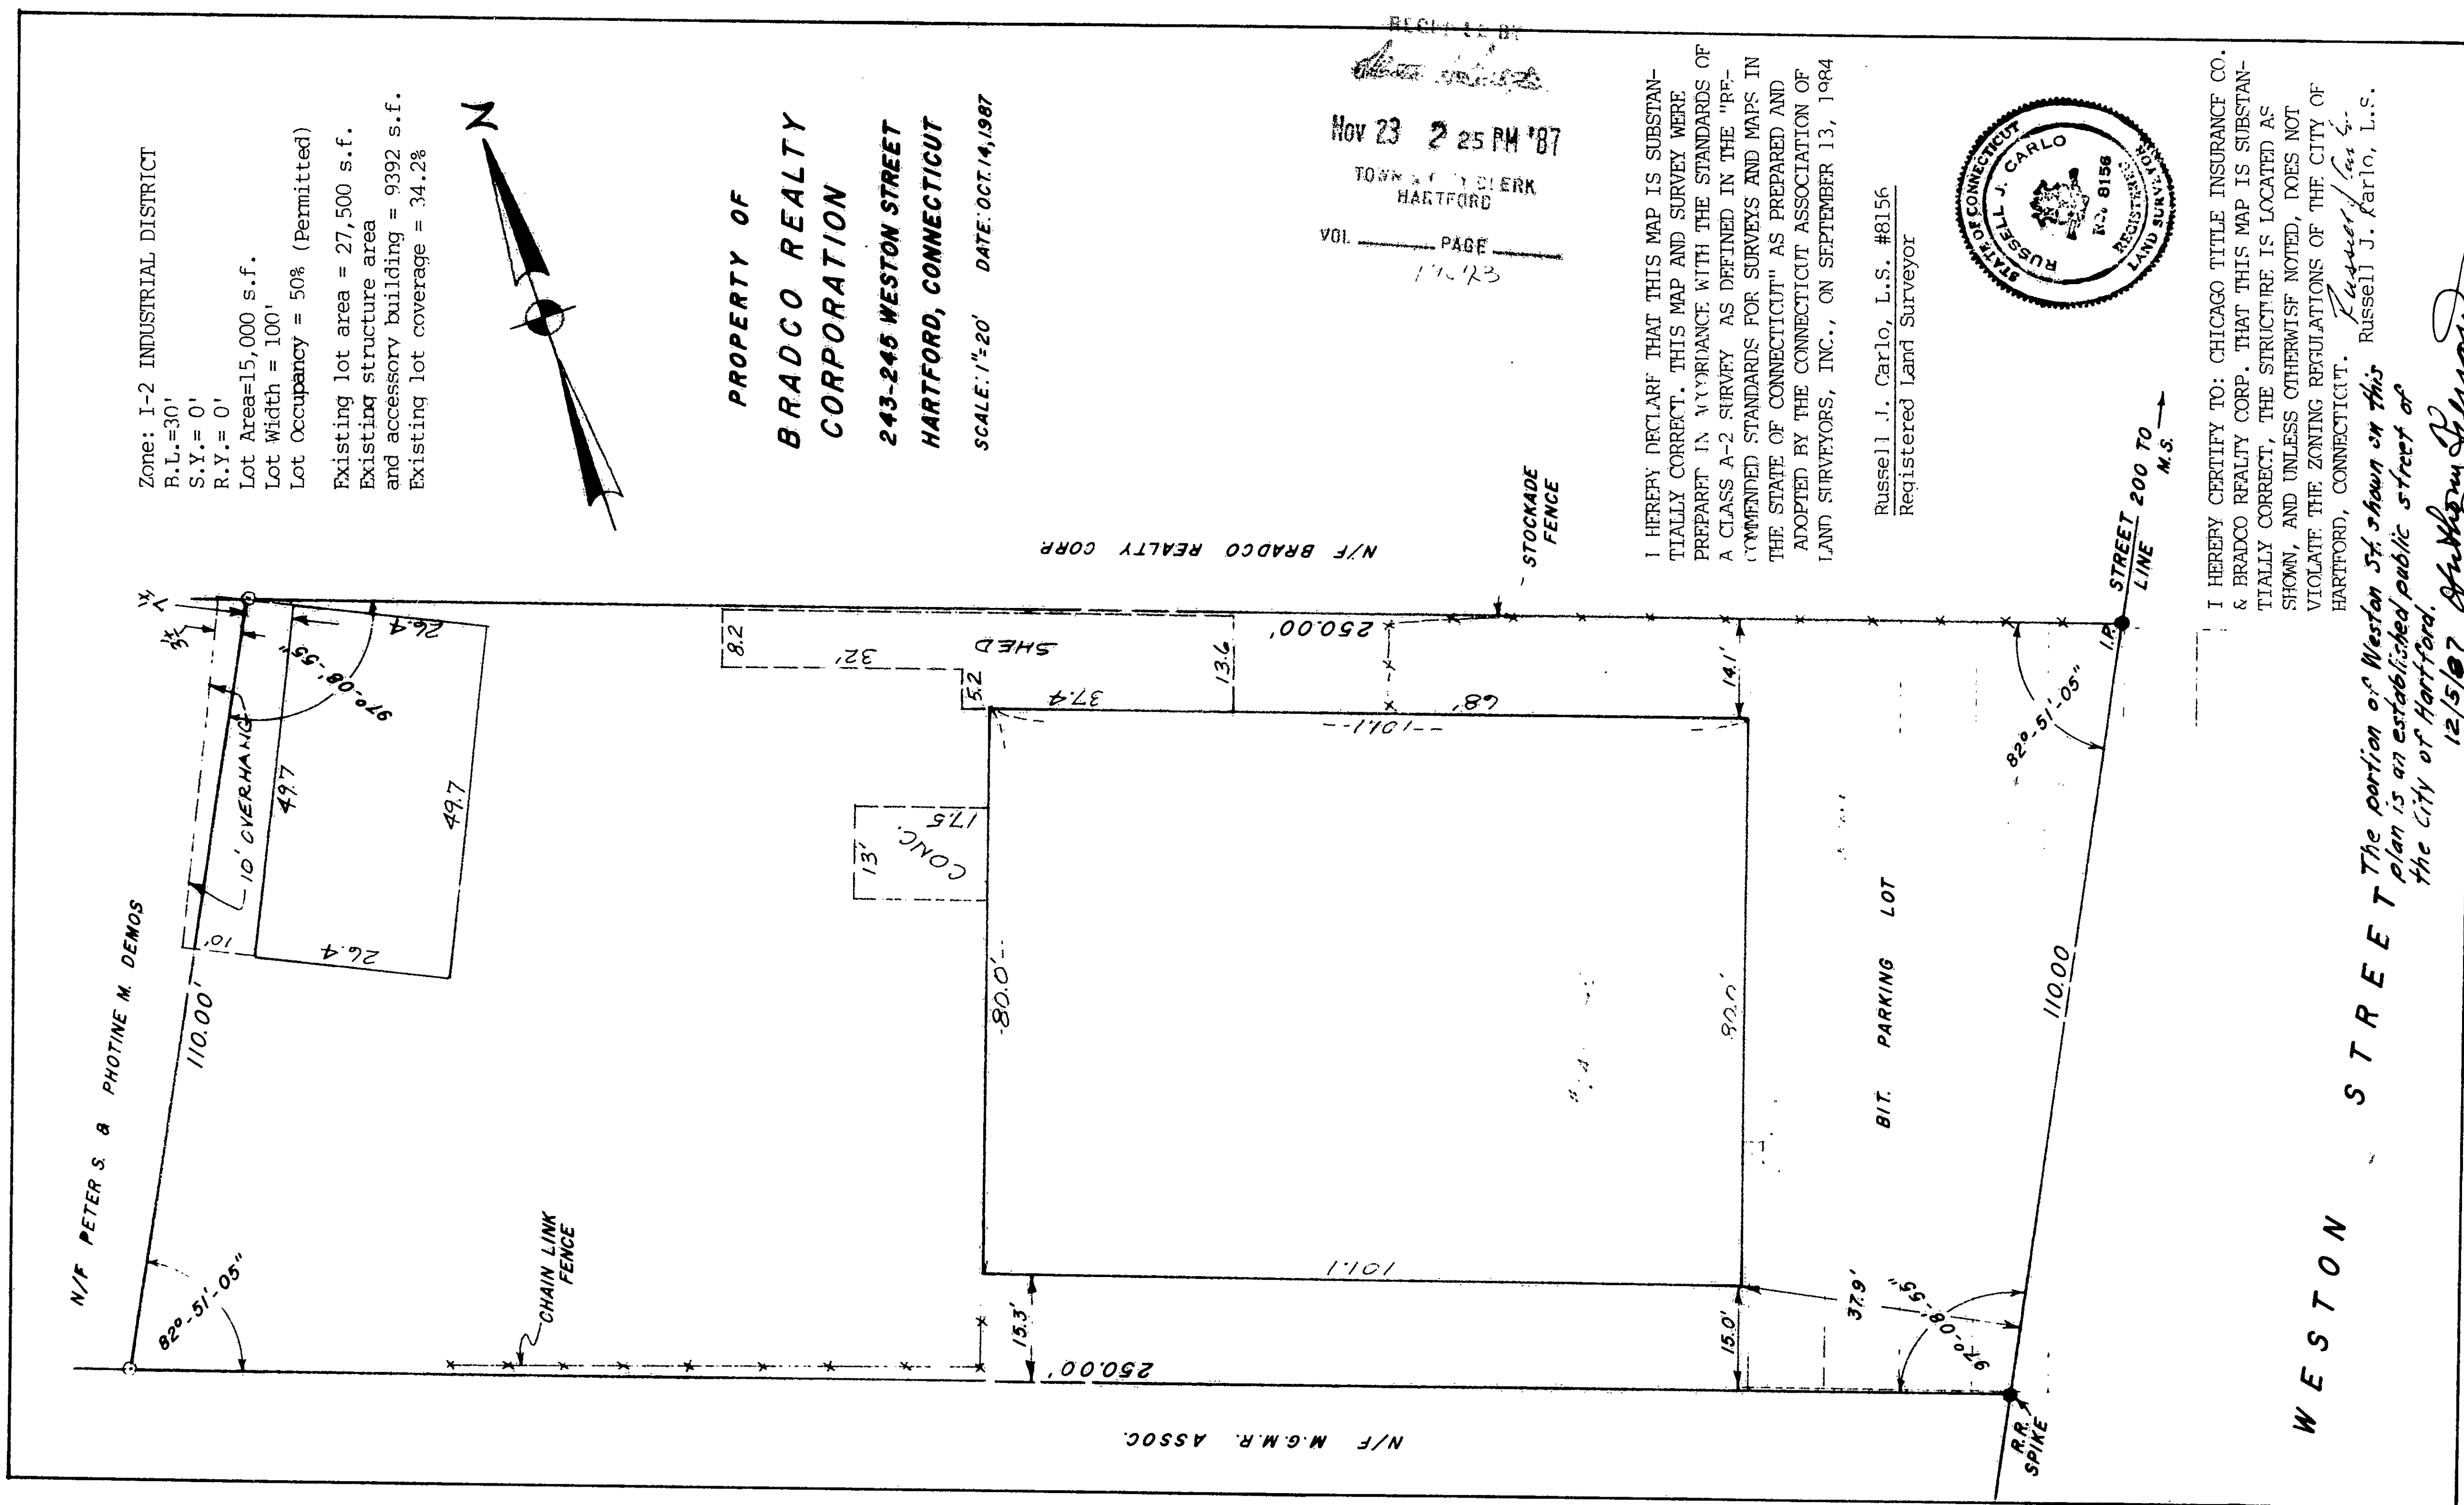

I HEREBY CERTIFY TO: CHICAGO TITLE INSURANCE CO.
 & BRADCO REALTY CORP. THAT THIS MAP IS SUBSTANTIALLY CORRECT, THE STRUCTURE IS LOCATED AS SHOWN, AND UNLESS OTHERWISE NOTED, DOES NOT VIOLATE THE ZONING REGULATIONS OF THE CITY OF HARTFORD, CONNECTICUT.


See 5th shown on this

WESTON STREET The portion of Weston St. shown on this plan is an established public street of the City of Hartford. 12

Date City Engineer

Date City Engineer