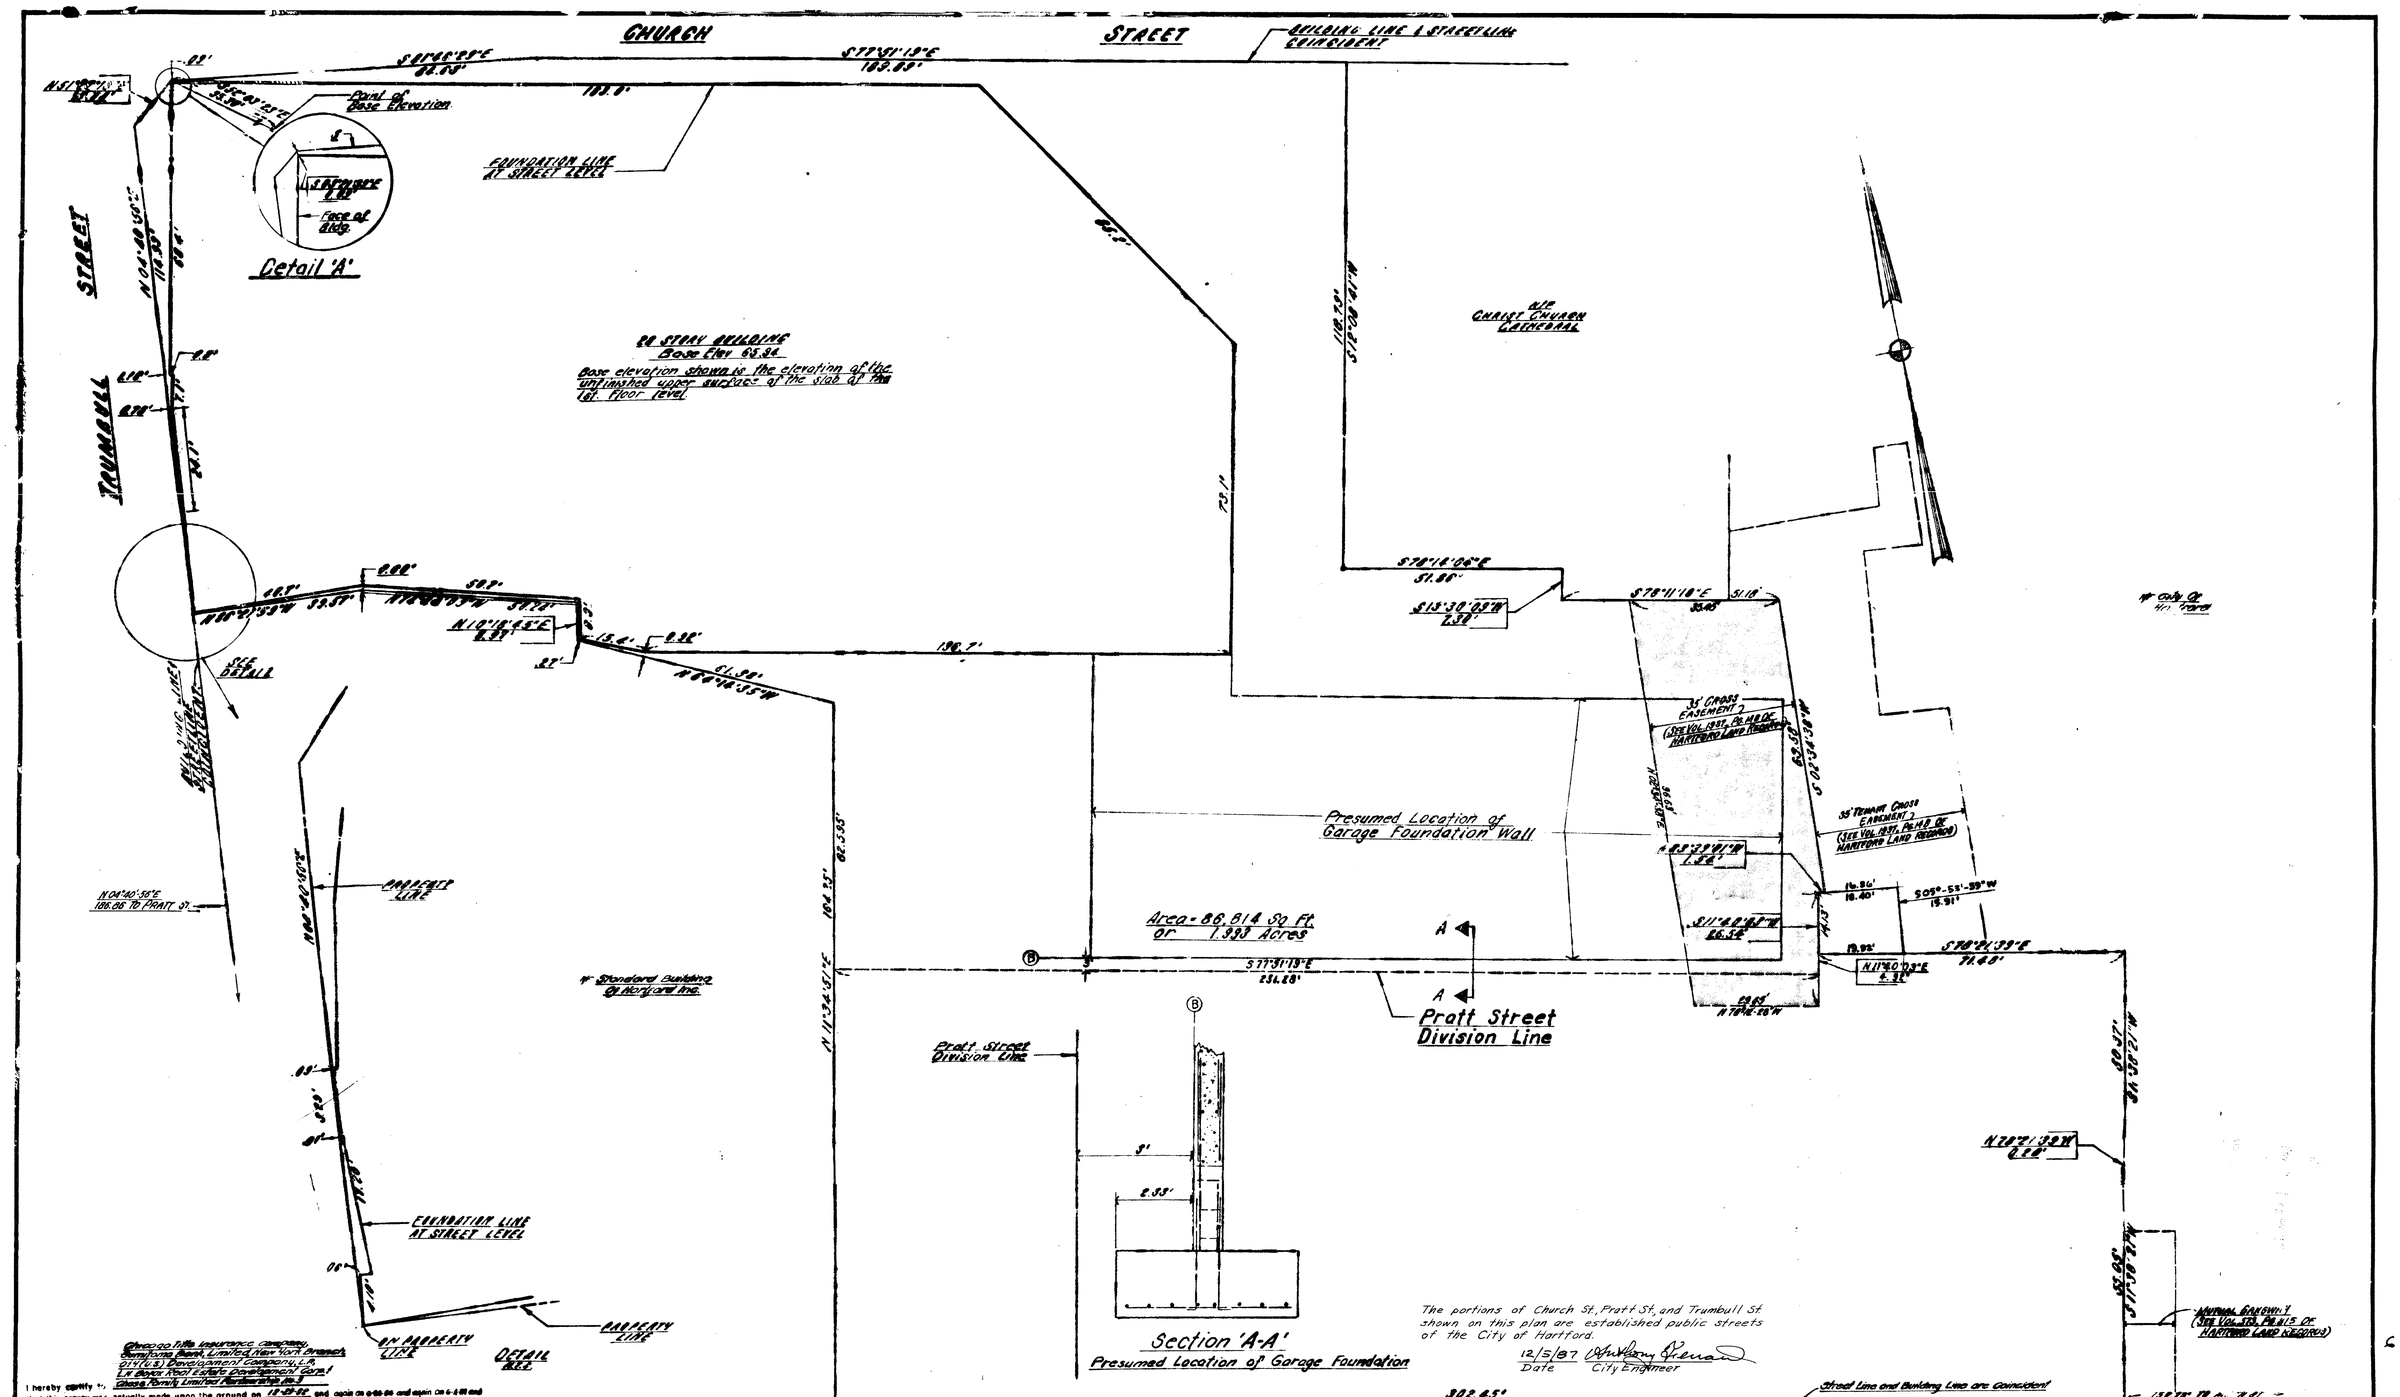

1670

EAN FILE CORP. IRVINE CA. EFP-14