


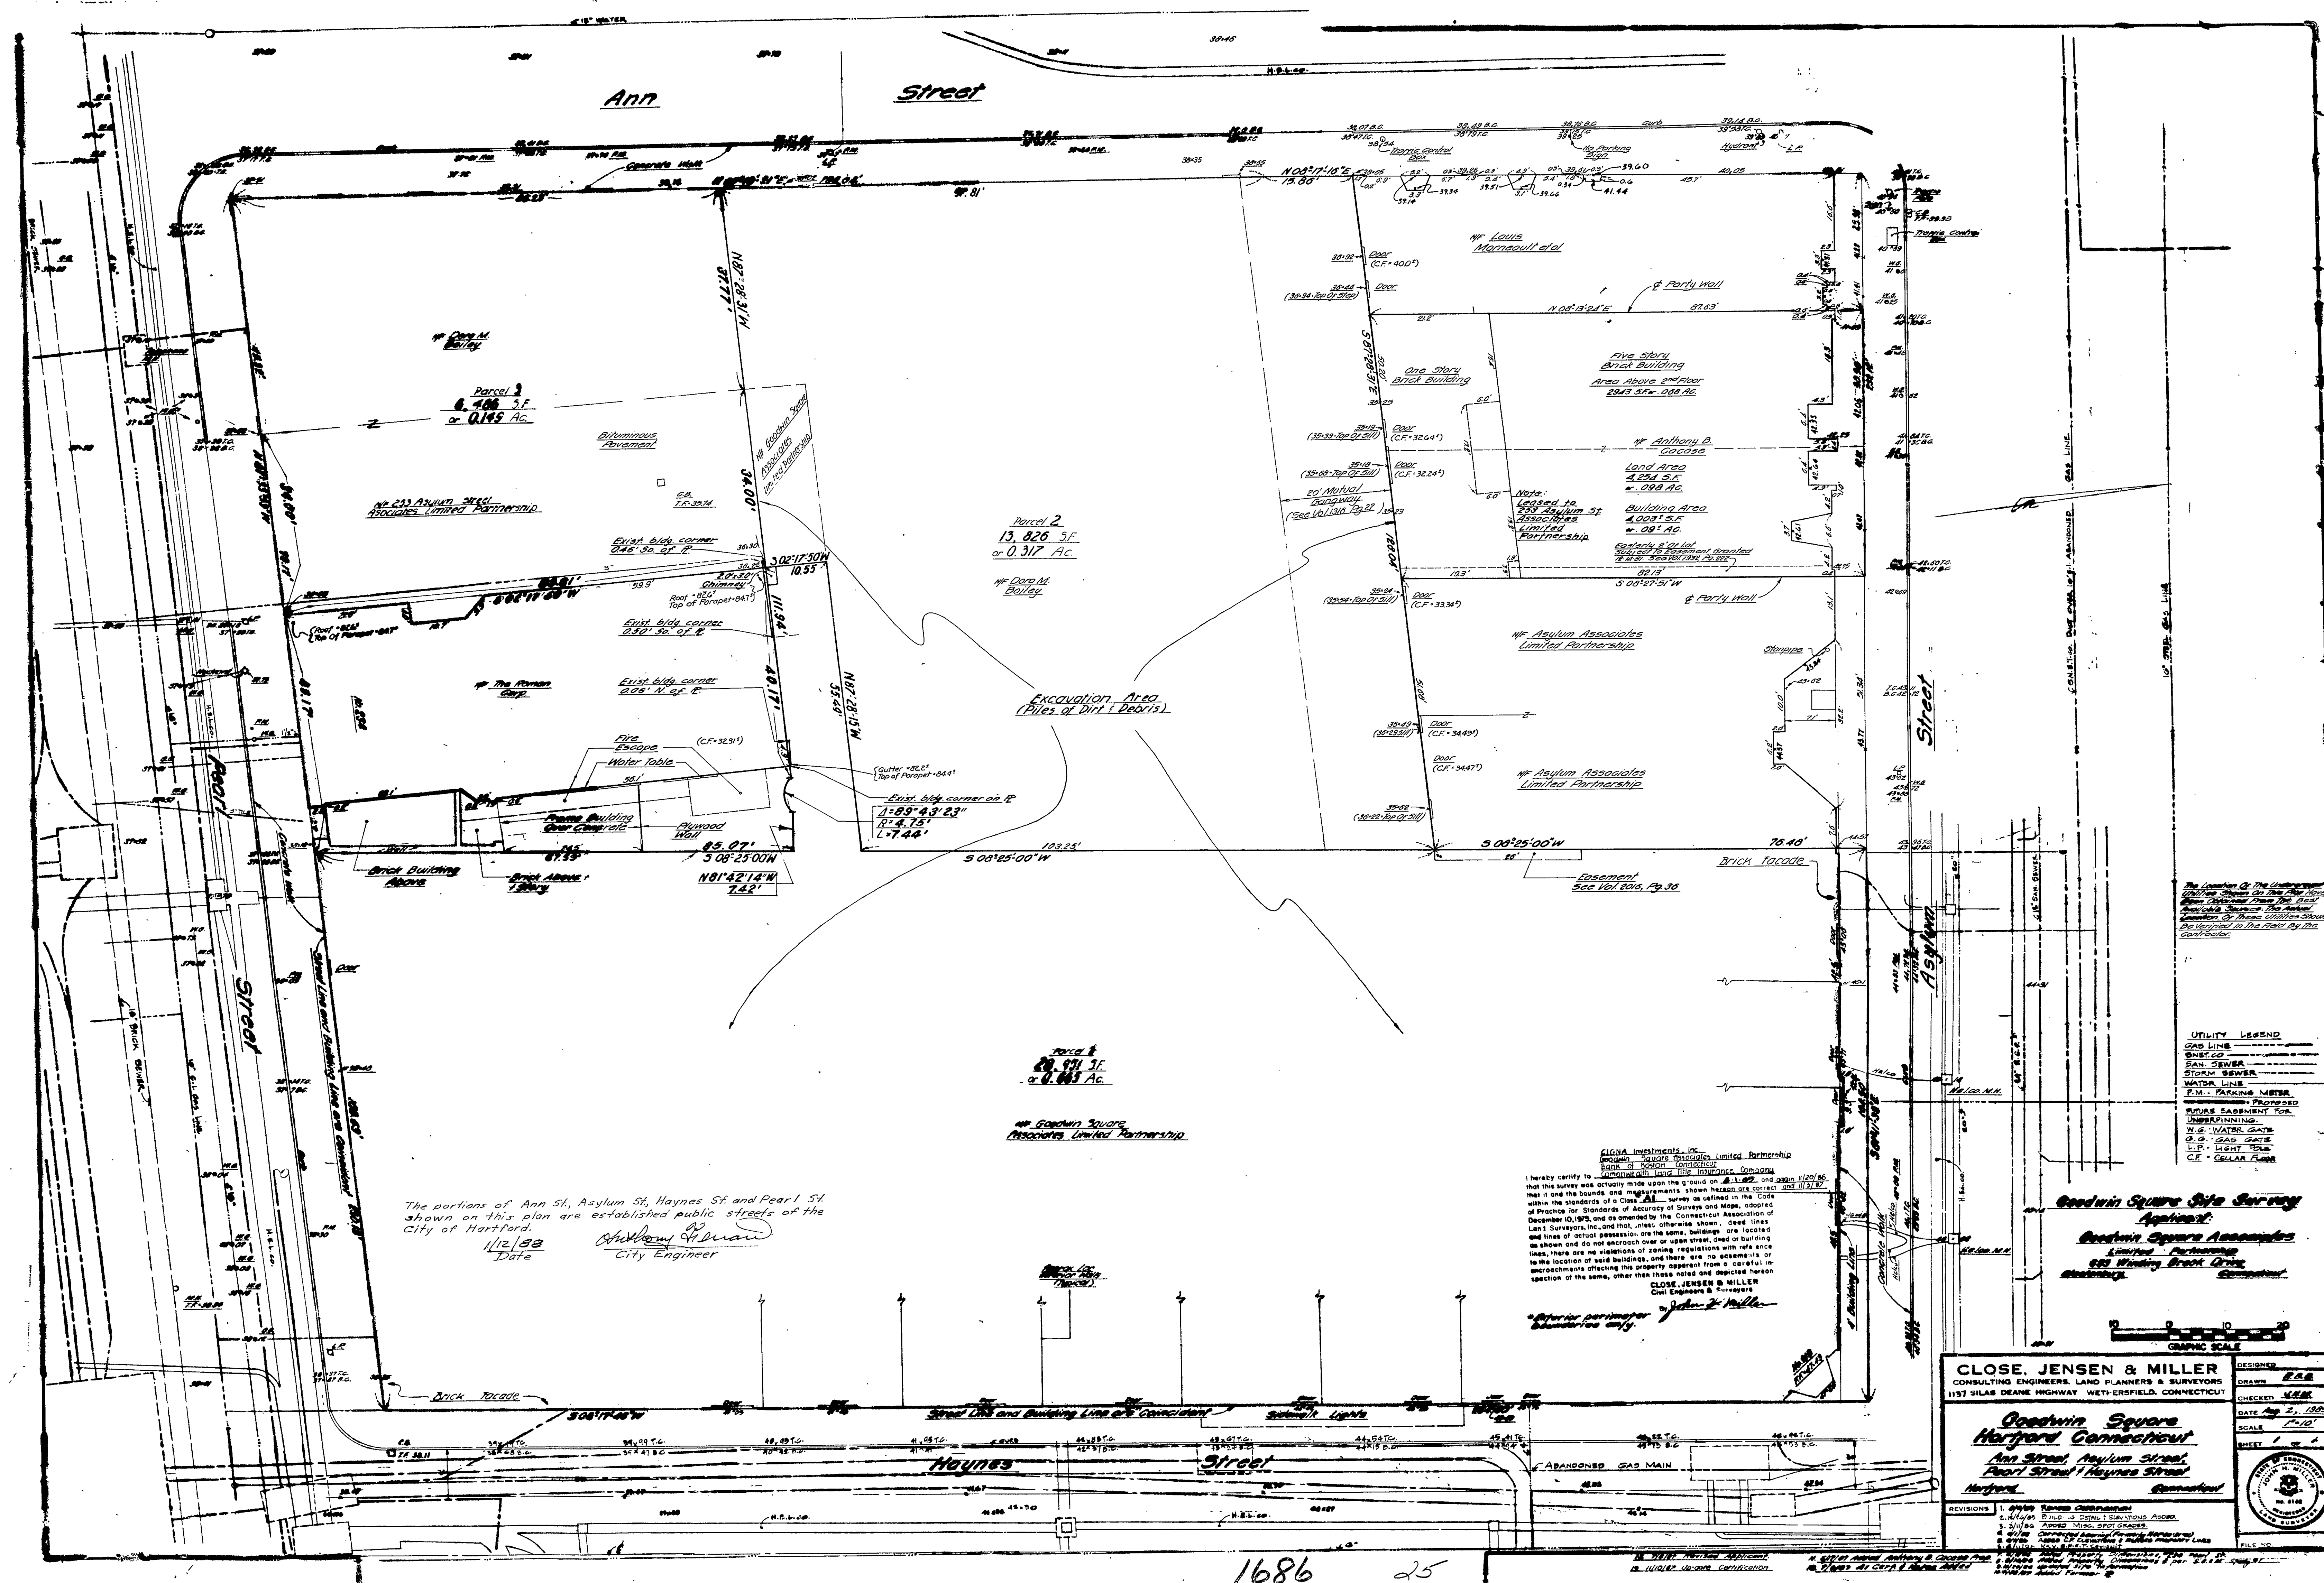


UTILITY LEGEND	
—	GAS LINE
—	WATER LINE
—	SEWER LINE
—	STORM SEWER
—	WATER MAIN
—	F.M. - PARKING METER

Goodwin Square Site Survey
Asylum Street
Goodwin Square Associates

CLOSE, JENSEN & MILLER
CONSULTING ENGINEERS, LAND PLANNERS & SURVEYORS
1157 SILAS DEANE HIGHWAY WETTERFIELD, CONNECTICUT

Goodwin Square
Hartford, Connecticut
Ann Street / Asylum Street
Pearl Street / Haynes Street
Hartford, Connecticut

DESIGNED	DATE
DRAWN	DATE
CHECKED	DATE
SCALE	DATE
SHEET	DATE

REVISIONS




