


1707

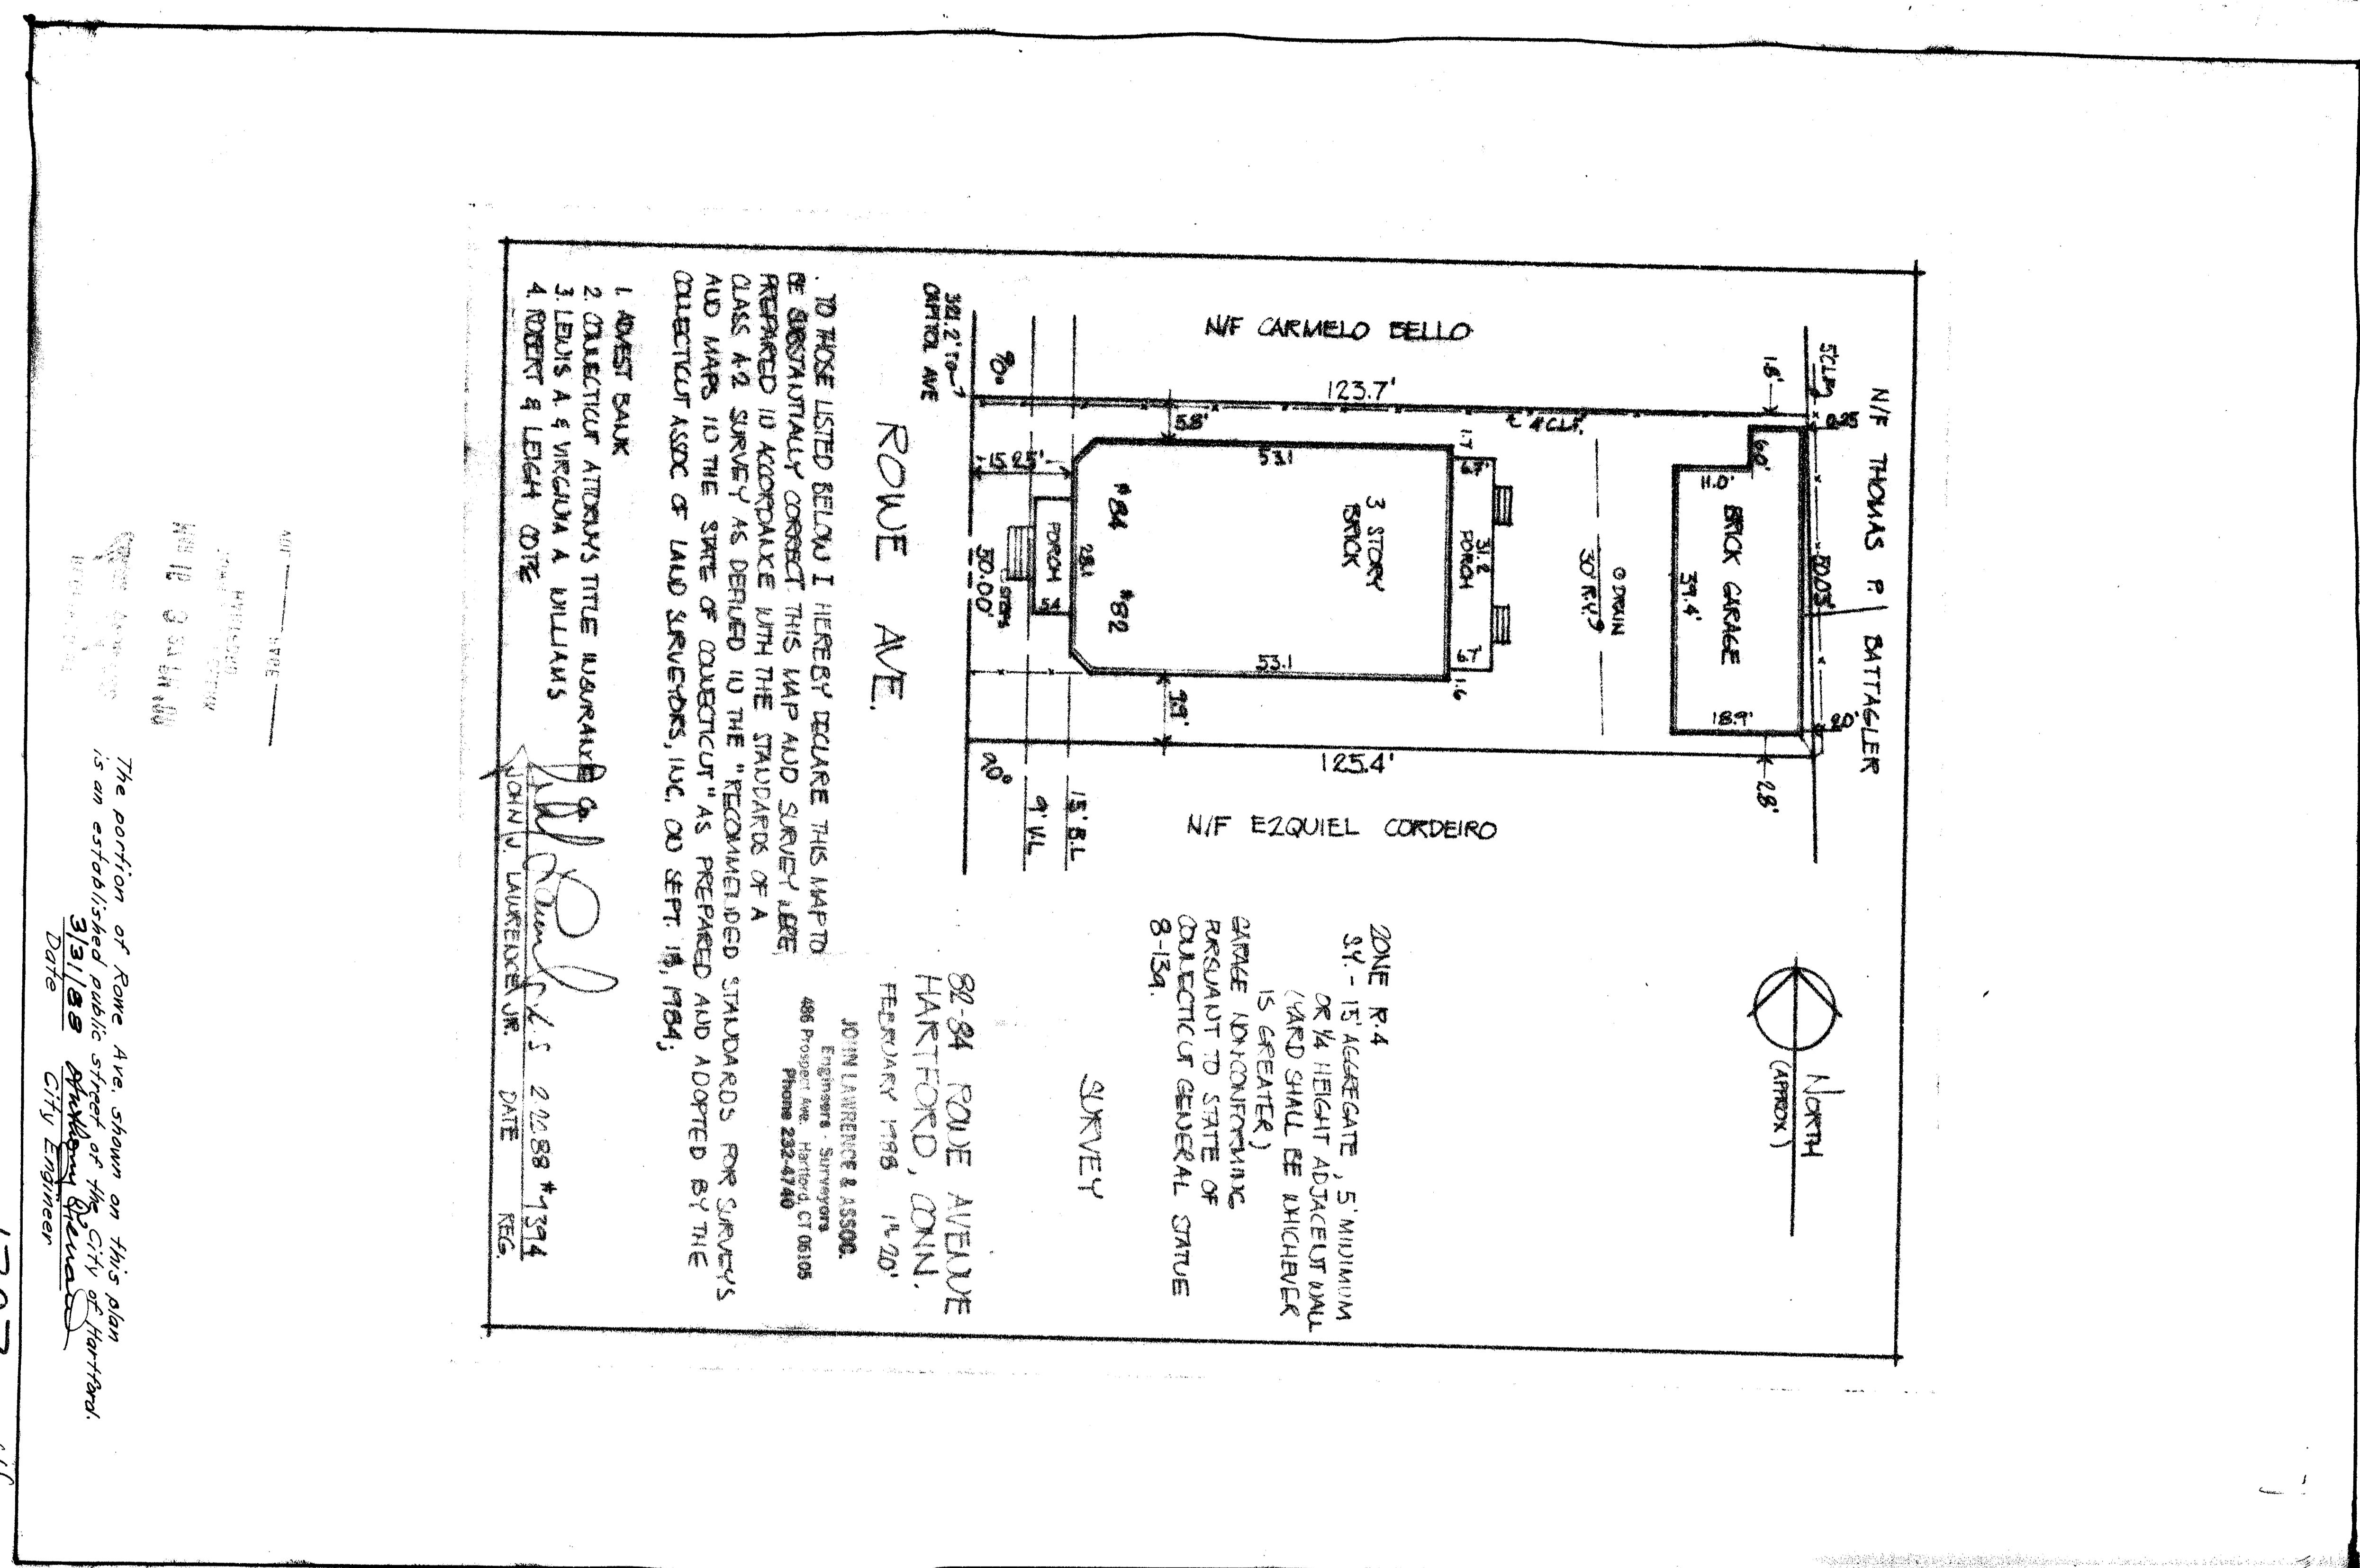

0 INCHES 1 2 3 4

1707 46