



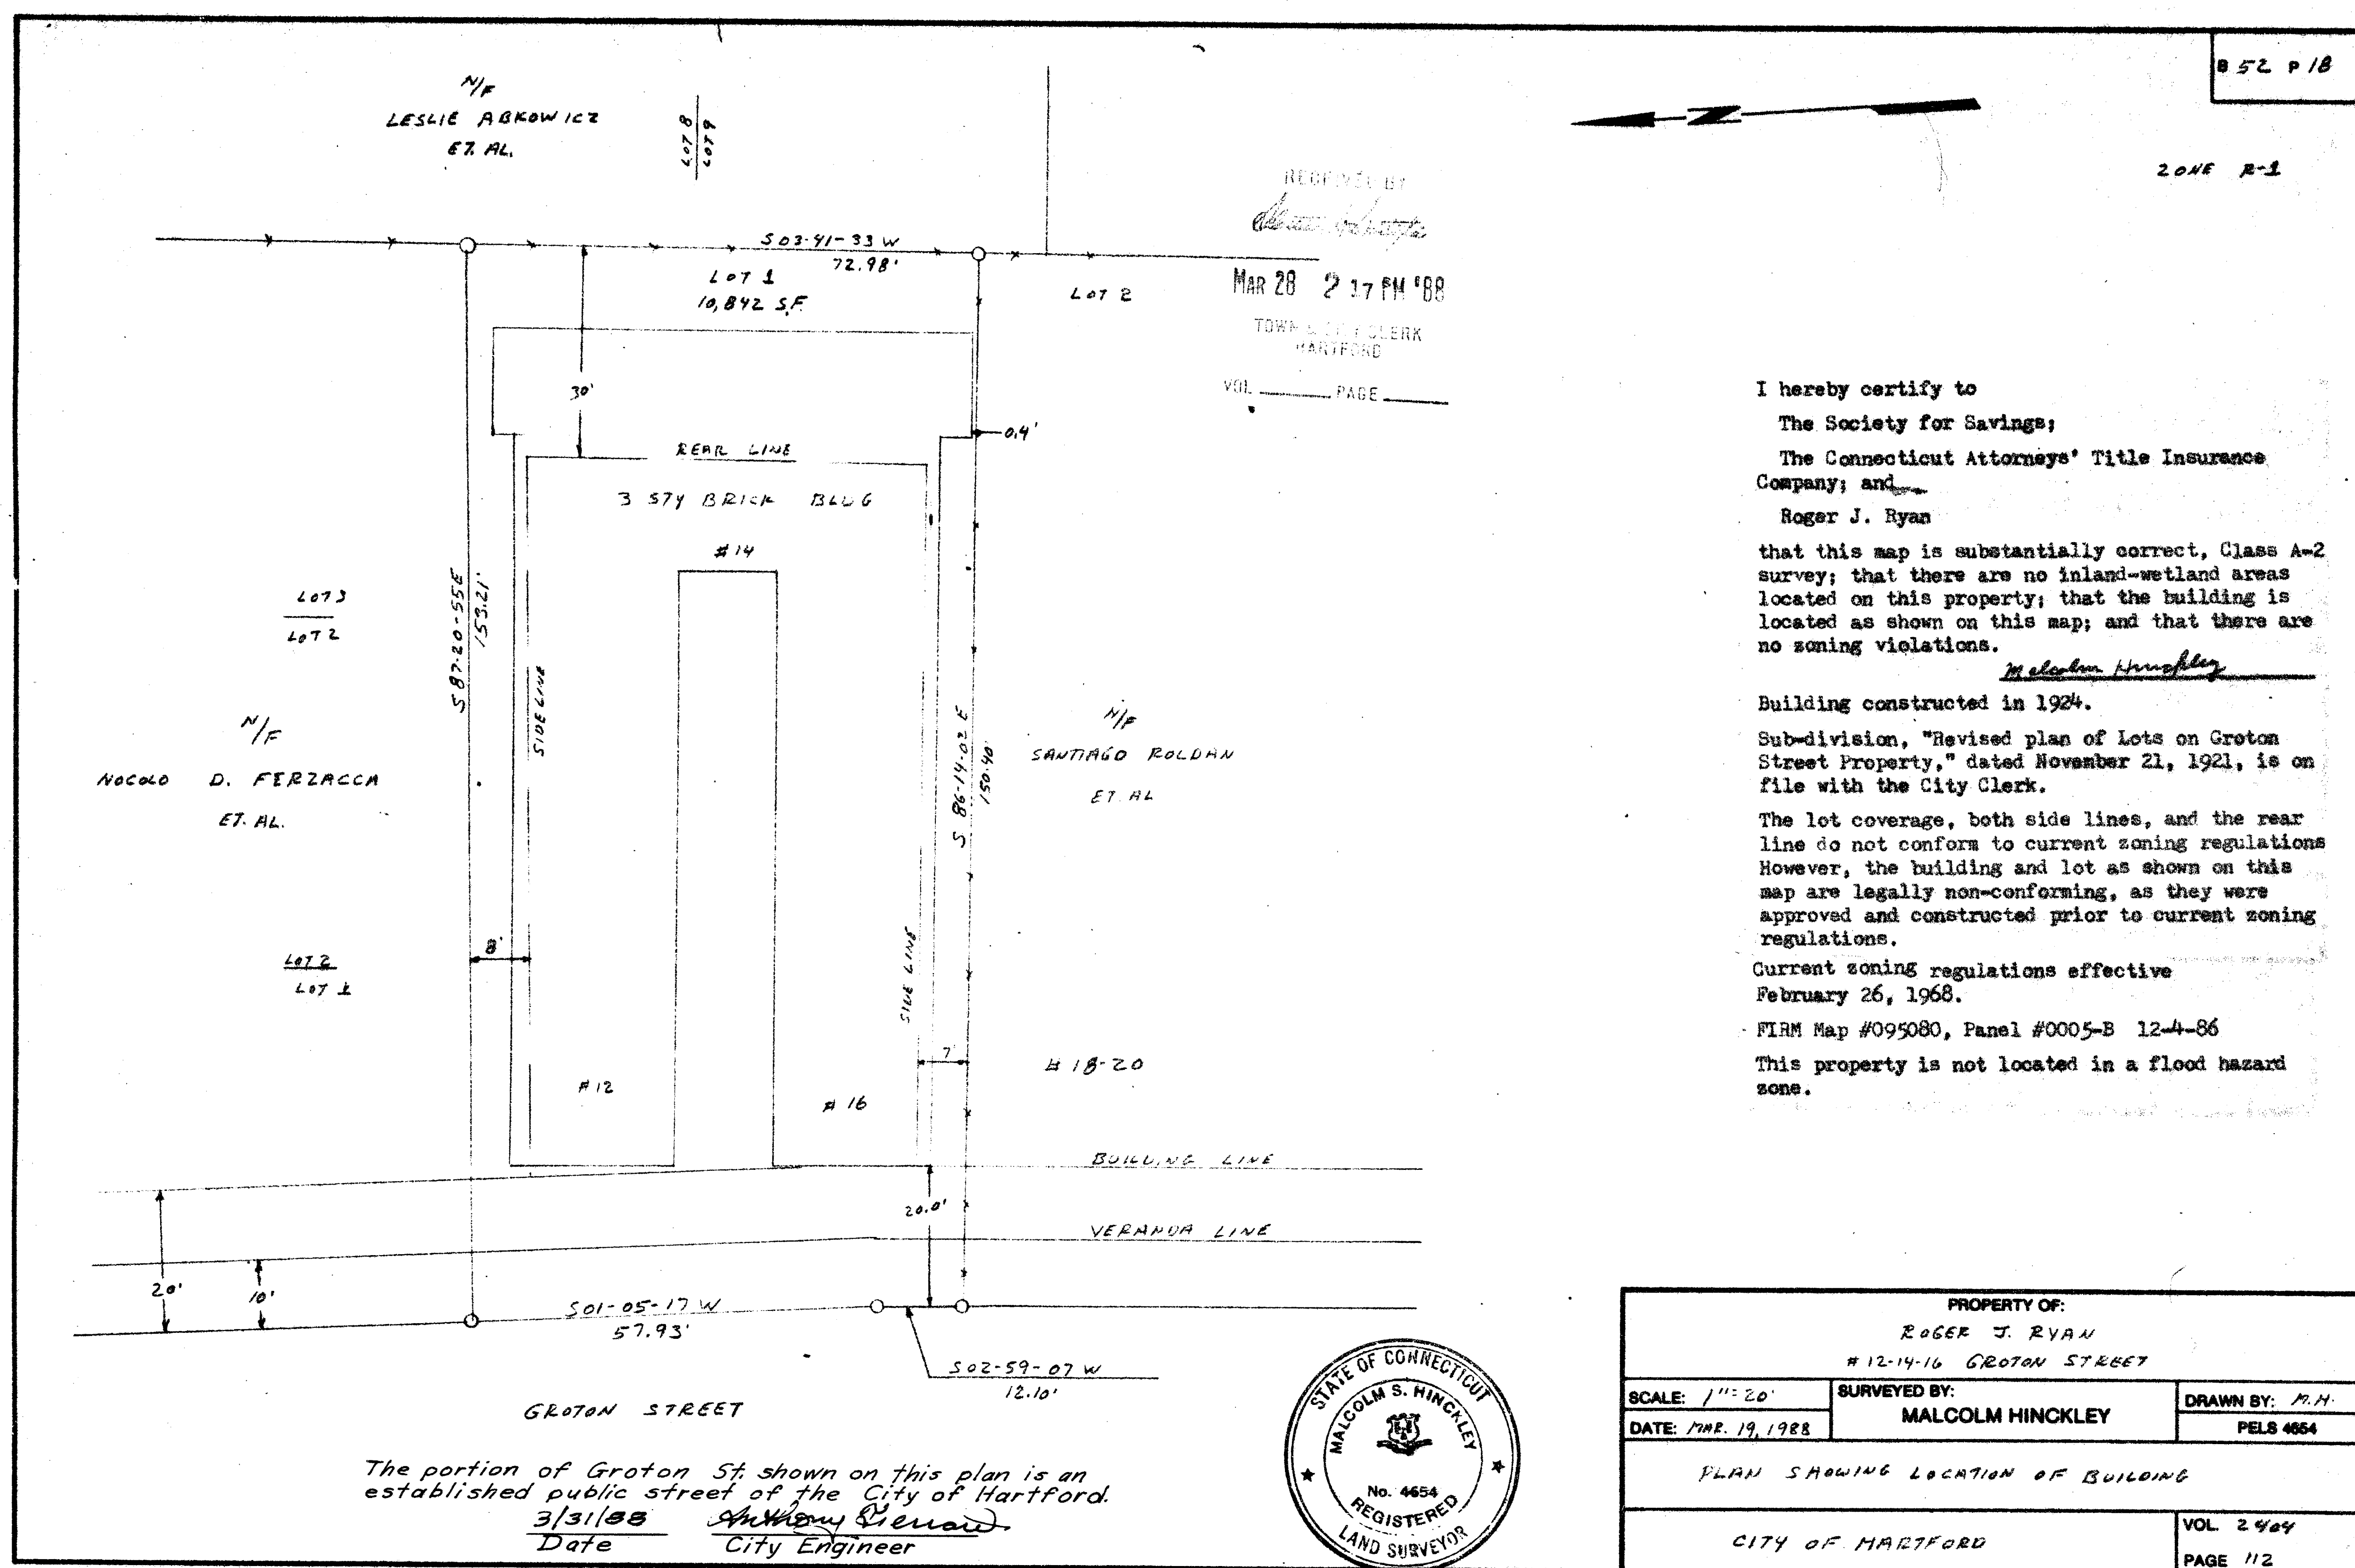

This property is not located in a flood hazard zone.

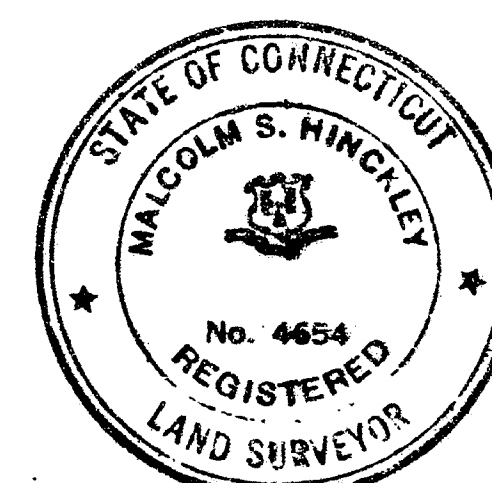

PROPERTY OF: ROGER J. RYAN # 12-14-16 GROTON STREET	
SCALE: 1" = 20'	SURVEYED BY: MALCOLM HINCKLEY
DATE: MAR. 19, 1988	DRAWN BY: M.H. PELS 4654
PLAN SHOWING LOCATION OF BUILDING	
CITY OF HARTFORD	VOL. 2404 PAGE 112

1708 47