


RECEIVED BY
 JUN 23 2 25 PM '88
 TOWN & CITY CLERK
 HARTFORD
 FILE

TO: CONNECTICUT BANK AND TRUST CO., n.a.
 TIGOR TITLE INSURANCE COMPANY

I hereby declare that no zoning regulations have been violated with respect to the location of the structure other than those depicted hereon.

Robert R. Messier
 ROBERT R. MESSIER, L.S. #12056

6/88
 DATE

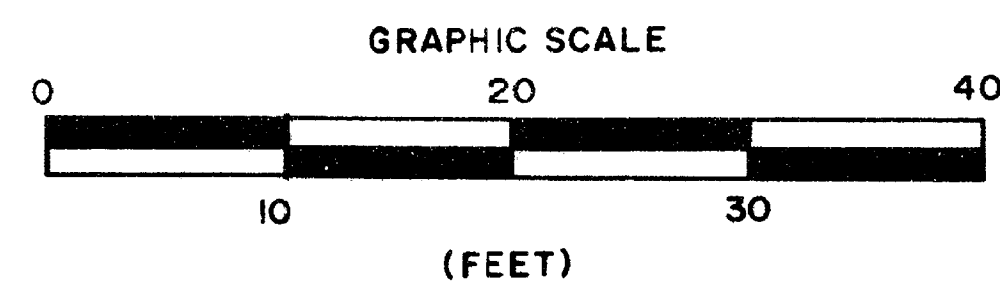

The portion of Allen Pl. shown on this plan is an established public street of the City of Hartford.
 6/27/88
 Date City Engineer

I HEREBY DECLARE THAT THIS MAP IS SUBSTANTIALLY CORRECT. THIS MAP AND SURVEY WERE PREPARED IN ACCORDANCE WITH THE STANDARDS OF A CLASS A-2 SURVEY AS DEFINED IN THE "RECOMMENDED STANDARDS FOR SURVEYS AND MAPS IN THE STATE OF CONNECTICUT" AS PREPARED AND ADOPTED BY THE CONNECTICUT ASSOCIATION OF LAND SURVEYORS, INC. ON SEPTEMBER 13, 1984 AND EFFECTIVE JANUARY 1, 1987.

Robert R. Messier
 SURVEYORS SIGNATURE DATE 6/88 LICENSE NUMBER 12056

NO DECLARATION IS EXPRESSED OR IMPLIED UNLESS THIS PLAN BEARS THE EMBOSSED SEAL OF THE LAND SURVEYOR AND/OR PROFESSIONAL ENGINEER WHOSE SIGNATURE APPEARS HEREON.

1733 72 FILE No. 88-108 PLAN No. 88-155

