


NOTE:
The surveyed properties are subject to:
"Pedestrian Easement", "High Voltage Enclosure",
possible "Vehicular Access Easement" & "Drainage
Conditions" along former Rail Road Tract.

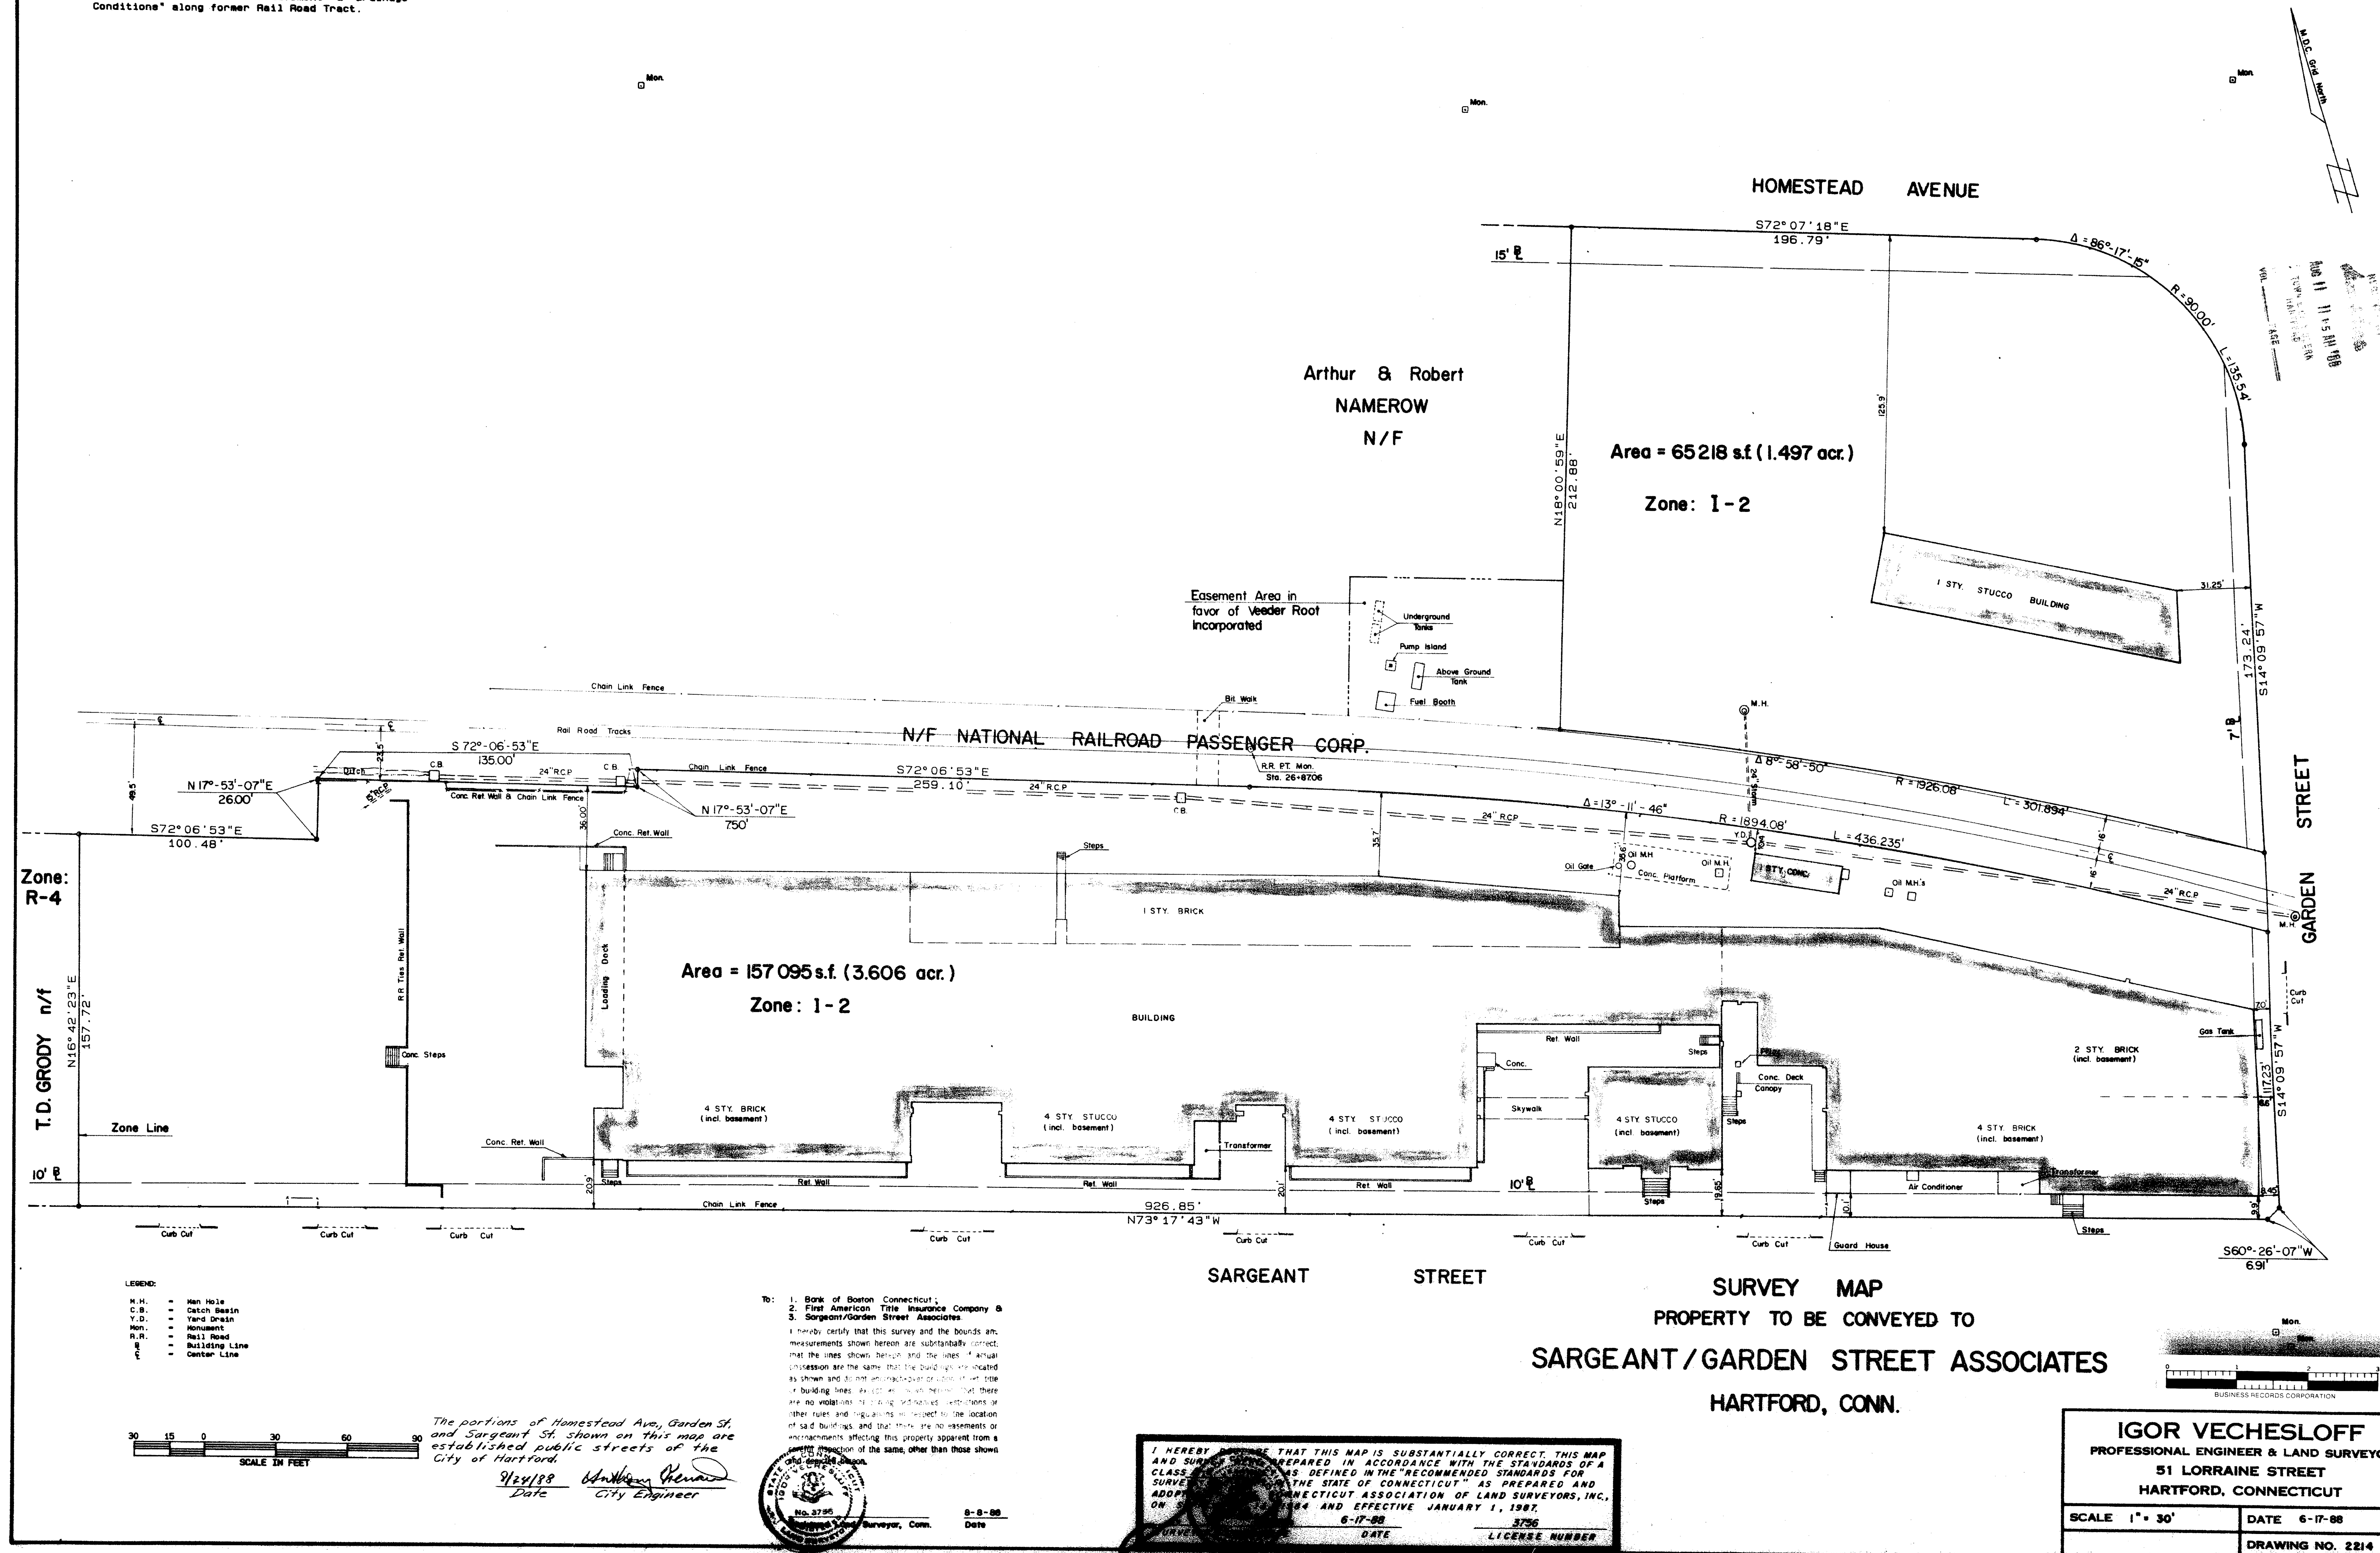

1748