


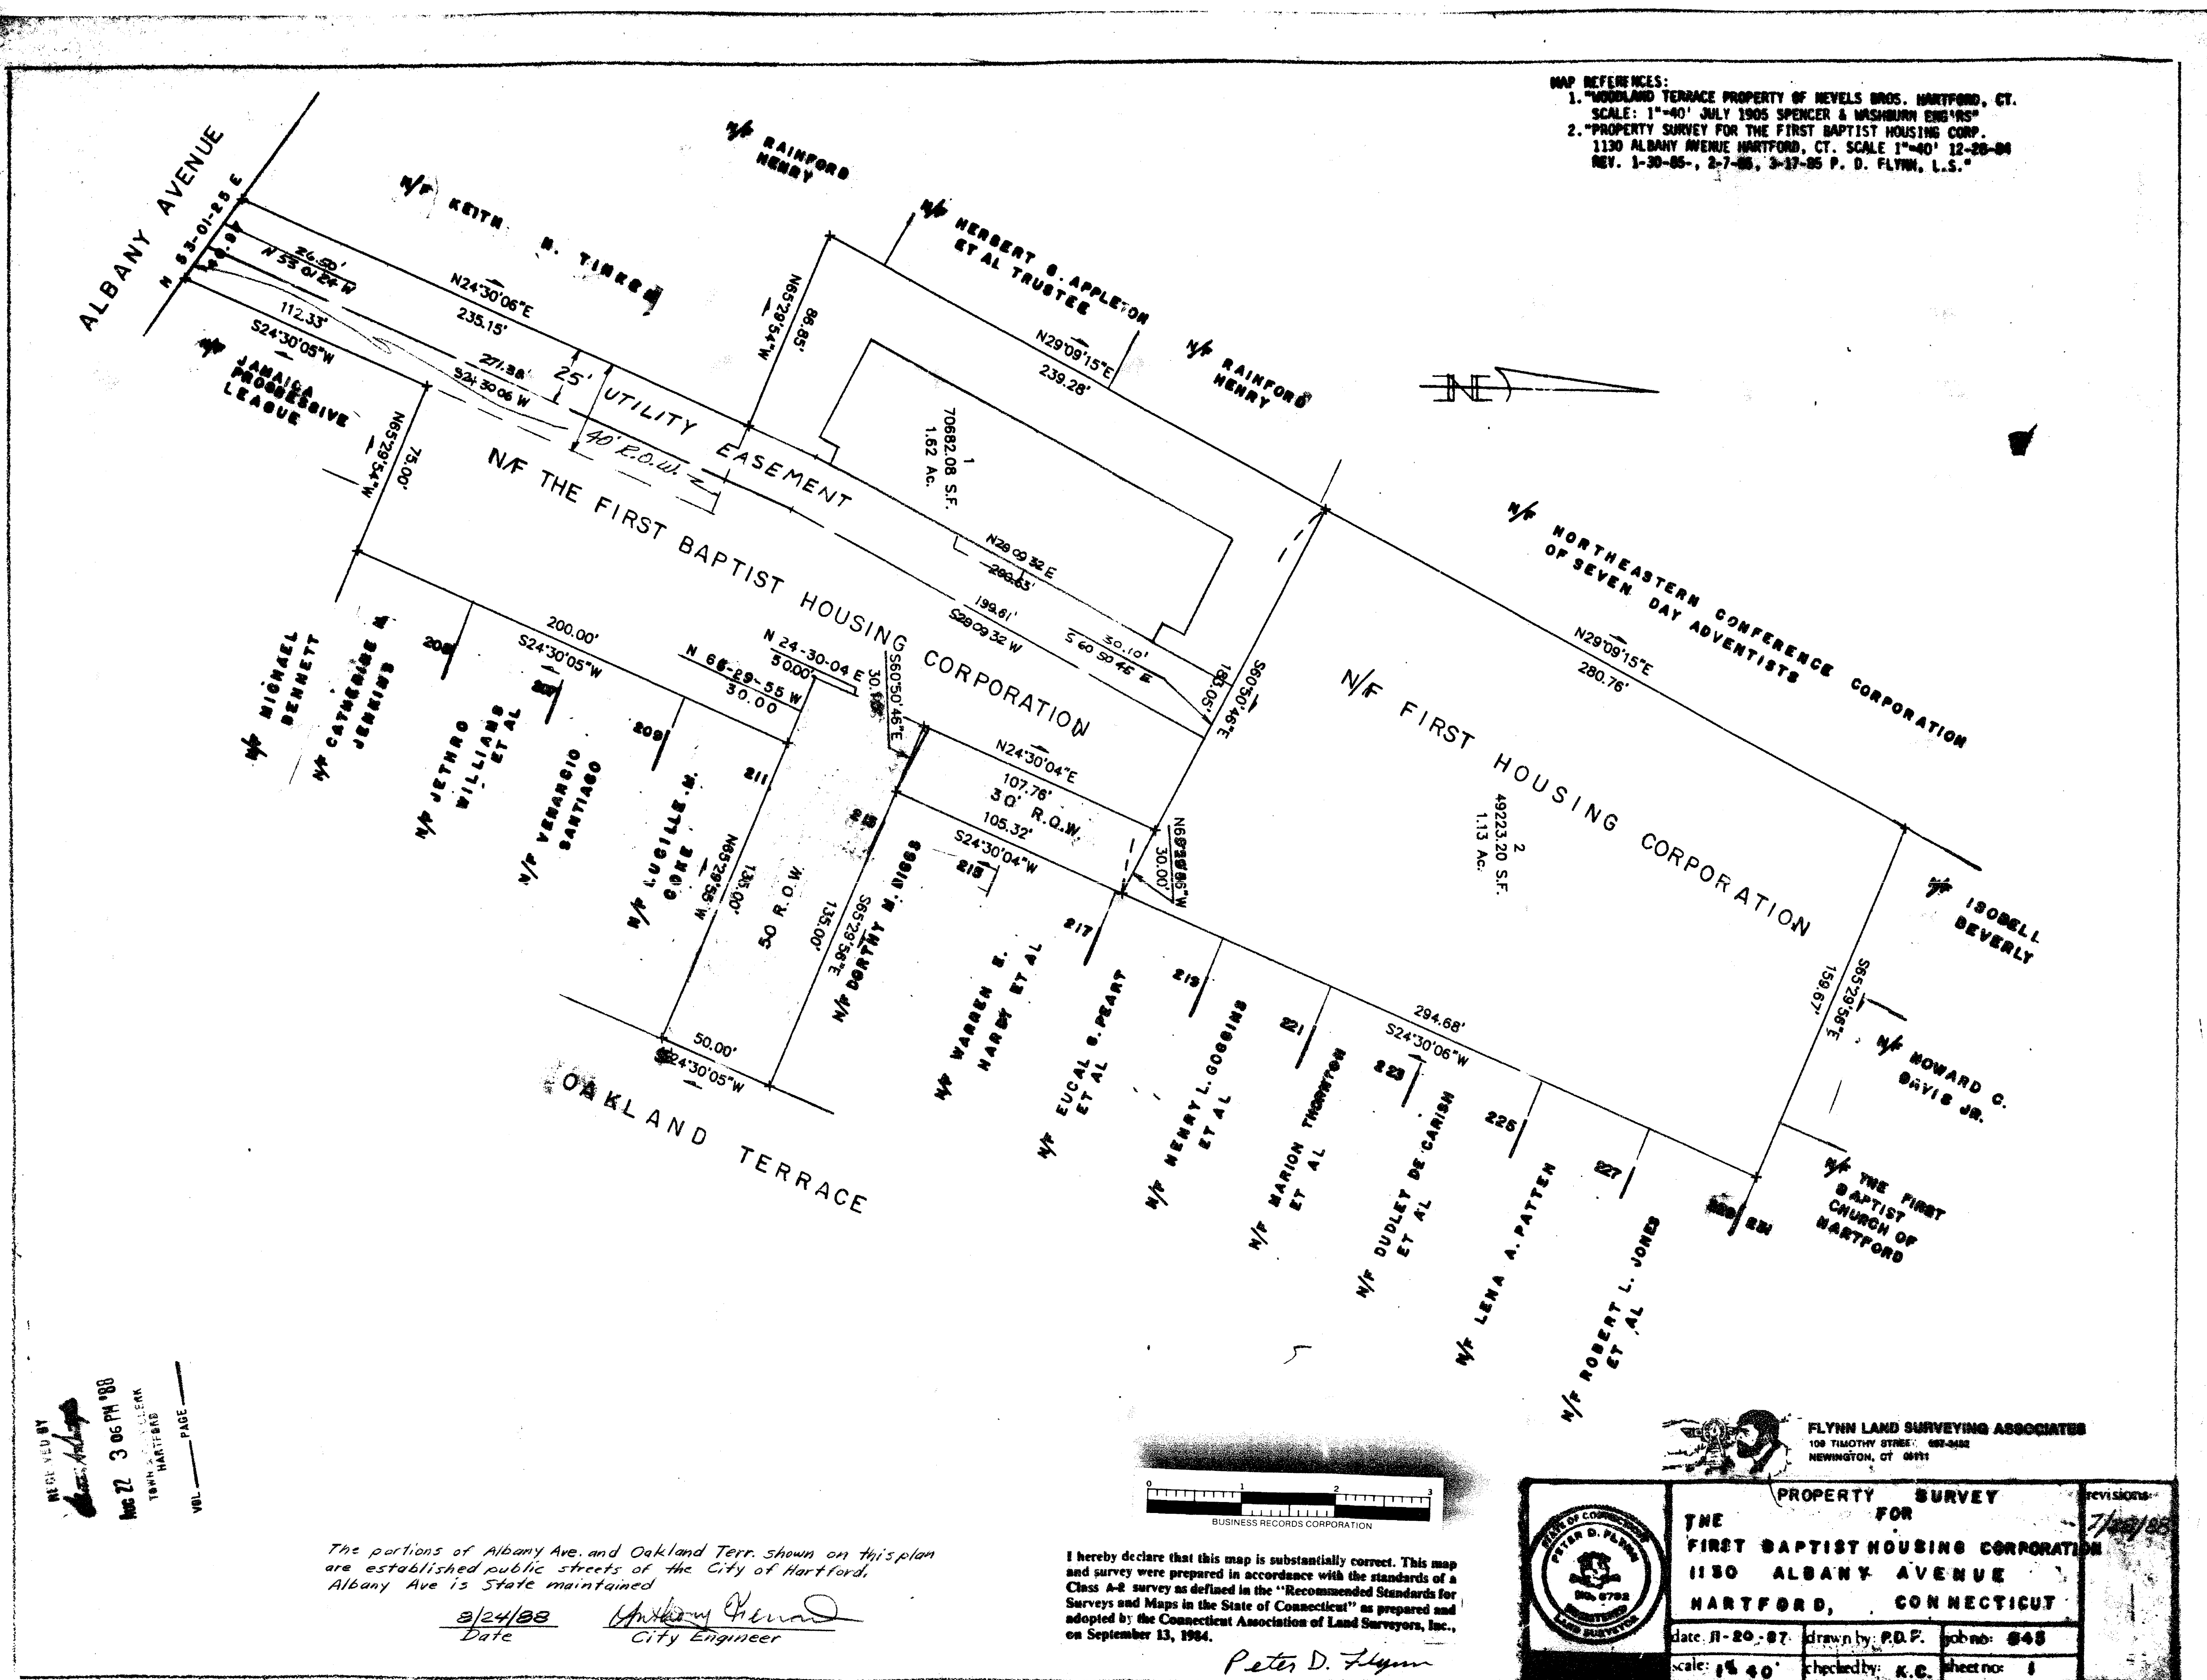

MAP REFERENCES:
1. "WOODLAND TERRACE PROPERTY OF NEVELL BROS. HARTFORD, CT.
SCALE: 1"=40' JULY 1905 SPENCER & WASHBURN ENG'RS"
2. "PROPERTY SURVEY FOR THE FIRST BAPTIST HOUSING CORP.
1130 ALBANY AVENUE HARTFORD, CT. SCALE 1"=40' 12-28-84
REV. 1-30-85, 2-7-86, 3-17-85 P. D. FLYNN, L.S."

RECEIVED BY
MAR 22 3 06 PM '88
TOWN ENGINEER
HARTFORD
VOL. PAGE

The portions of Albany Ave. and Oakland Terr. shown on this plan
are established public streets of the City of Hartford.
Albany Ave is State maintained.
3/24/88 Date
City Engineer

I hereby declare that this map is substantially correct. This map
and survey were prepared in accordance with the standards of a
Class A-2 survey as defined in the "Recommended Standards for
Surveys and Maps in the State of Connecticut" as prepared and
adopted by the Connecticut Association of Land Surveyors, Inc.,
on September 13, 1984.
Peter D. Flynn

	PROPERTY SURVEY FOR		REVISIONS
	THE FIRST BAPTIST HOUSING CORPORATION		7/24/88
	1130 ALBANY AVENUE		
	HARTFORD, CONNECTICUT		
date: 11-20-87		drawn by: P.D.F.	job no: 848
scale: 1"=40'		checked by: K.E.	sheet no: 1