


1766

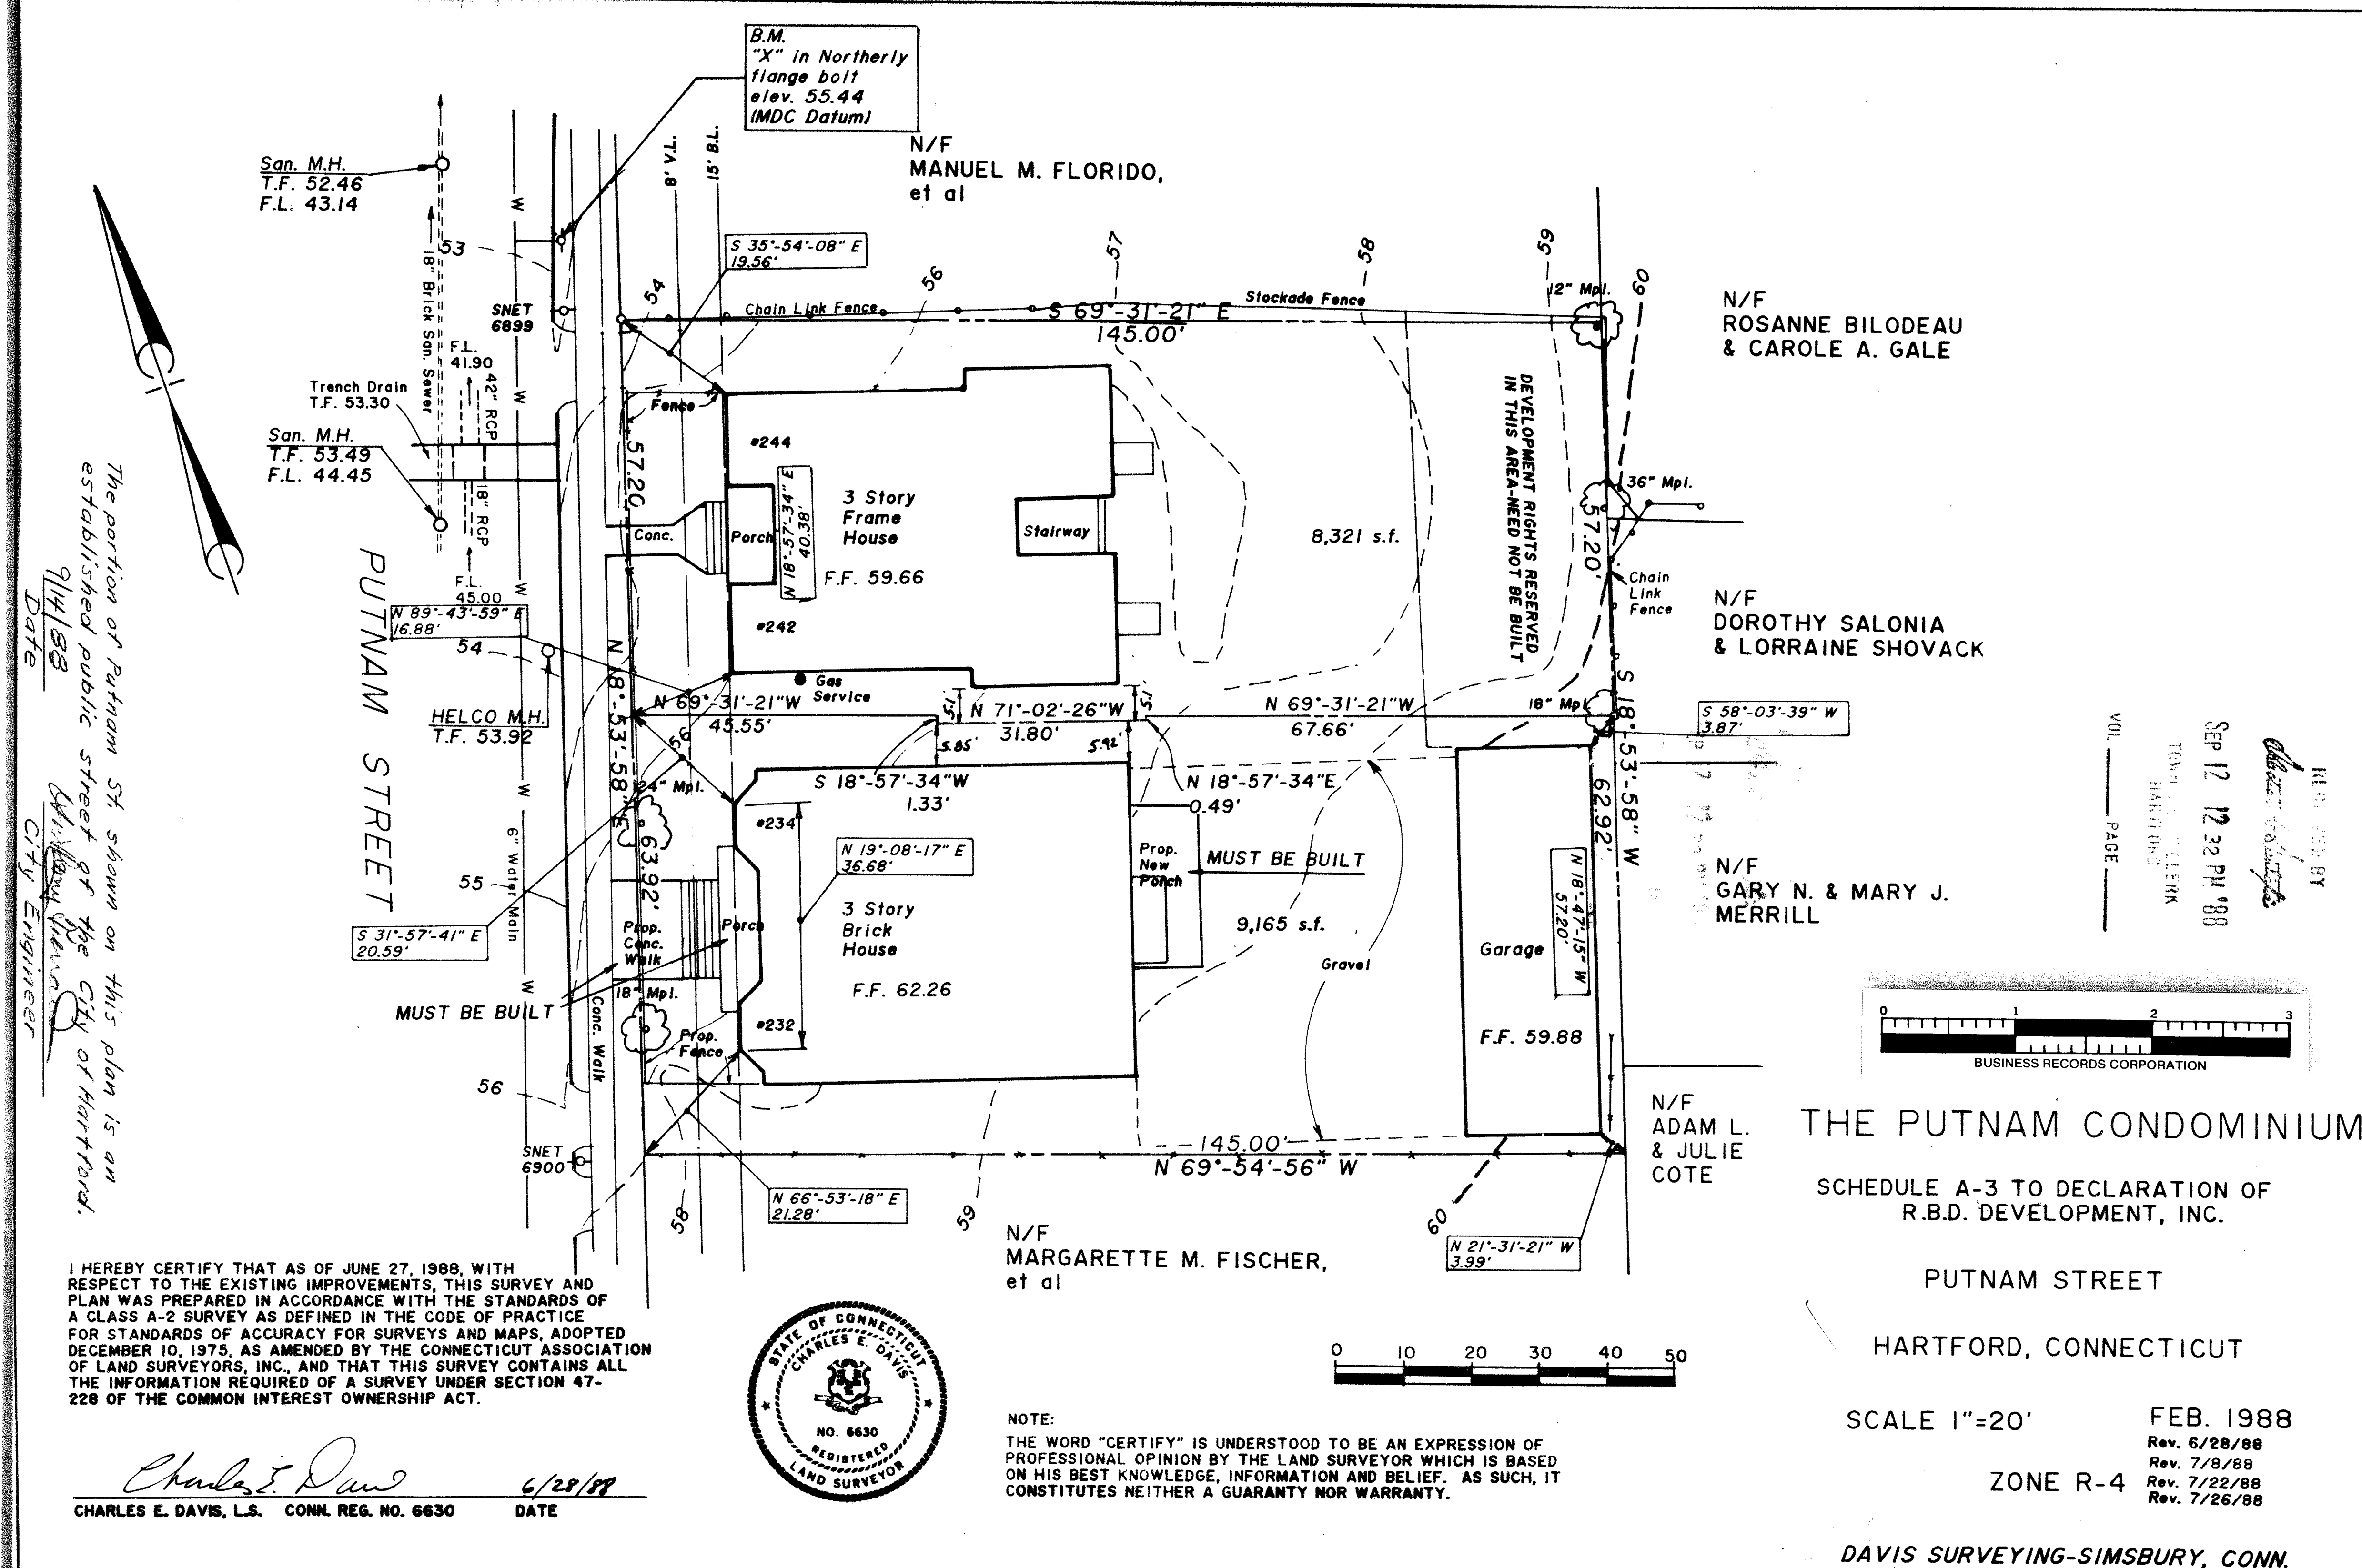

THE PUTNAM CONDOMINIUM

SCHEDULE A-3 TO DECLARATION OF
R.B.D. DEVELOPMENT, INC.

PUTNAM STREET

HARTFORD, CONNECTICUT

SCALE 1"=20'

FEB. 1988

ZONE R-4

DAVIS SURVEYING-SIMSBURY, CONN.

1766 88-14 B