



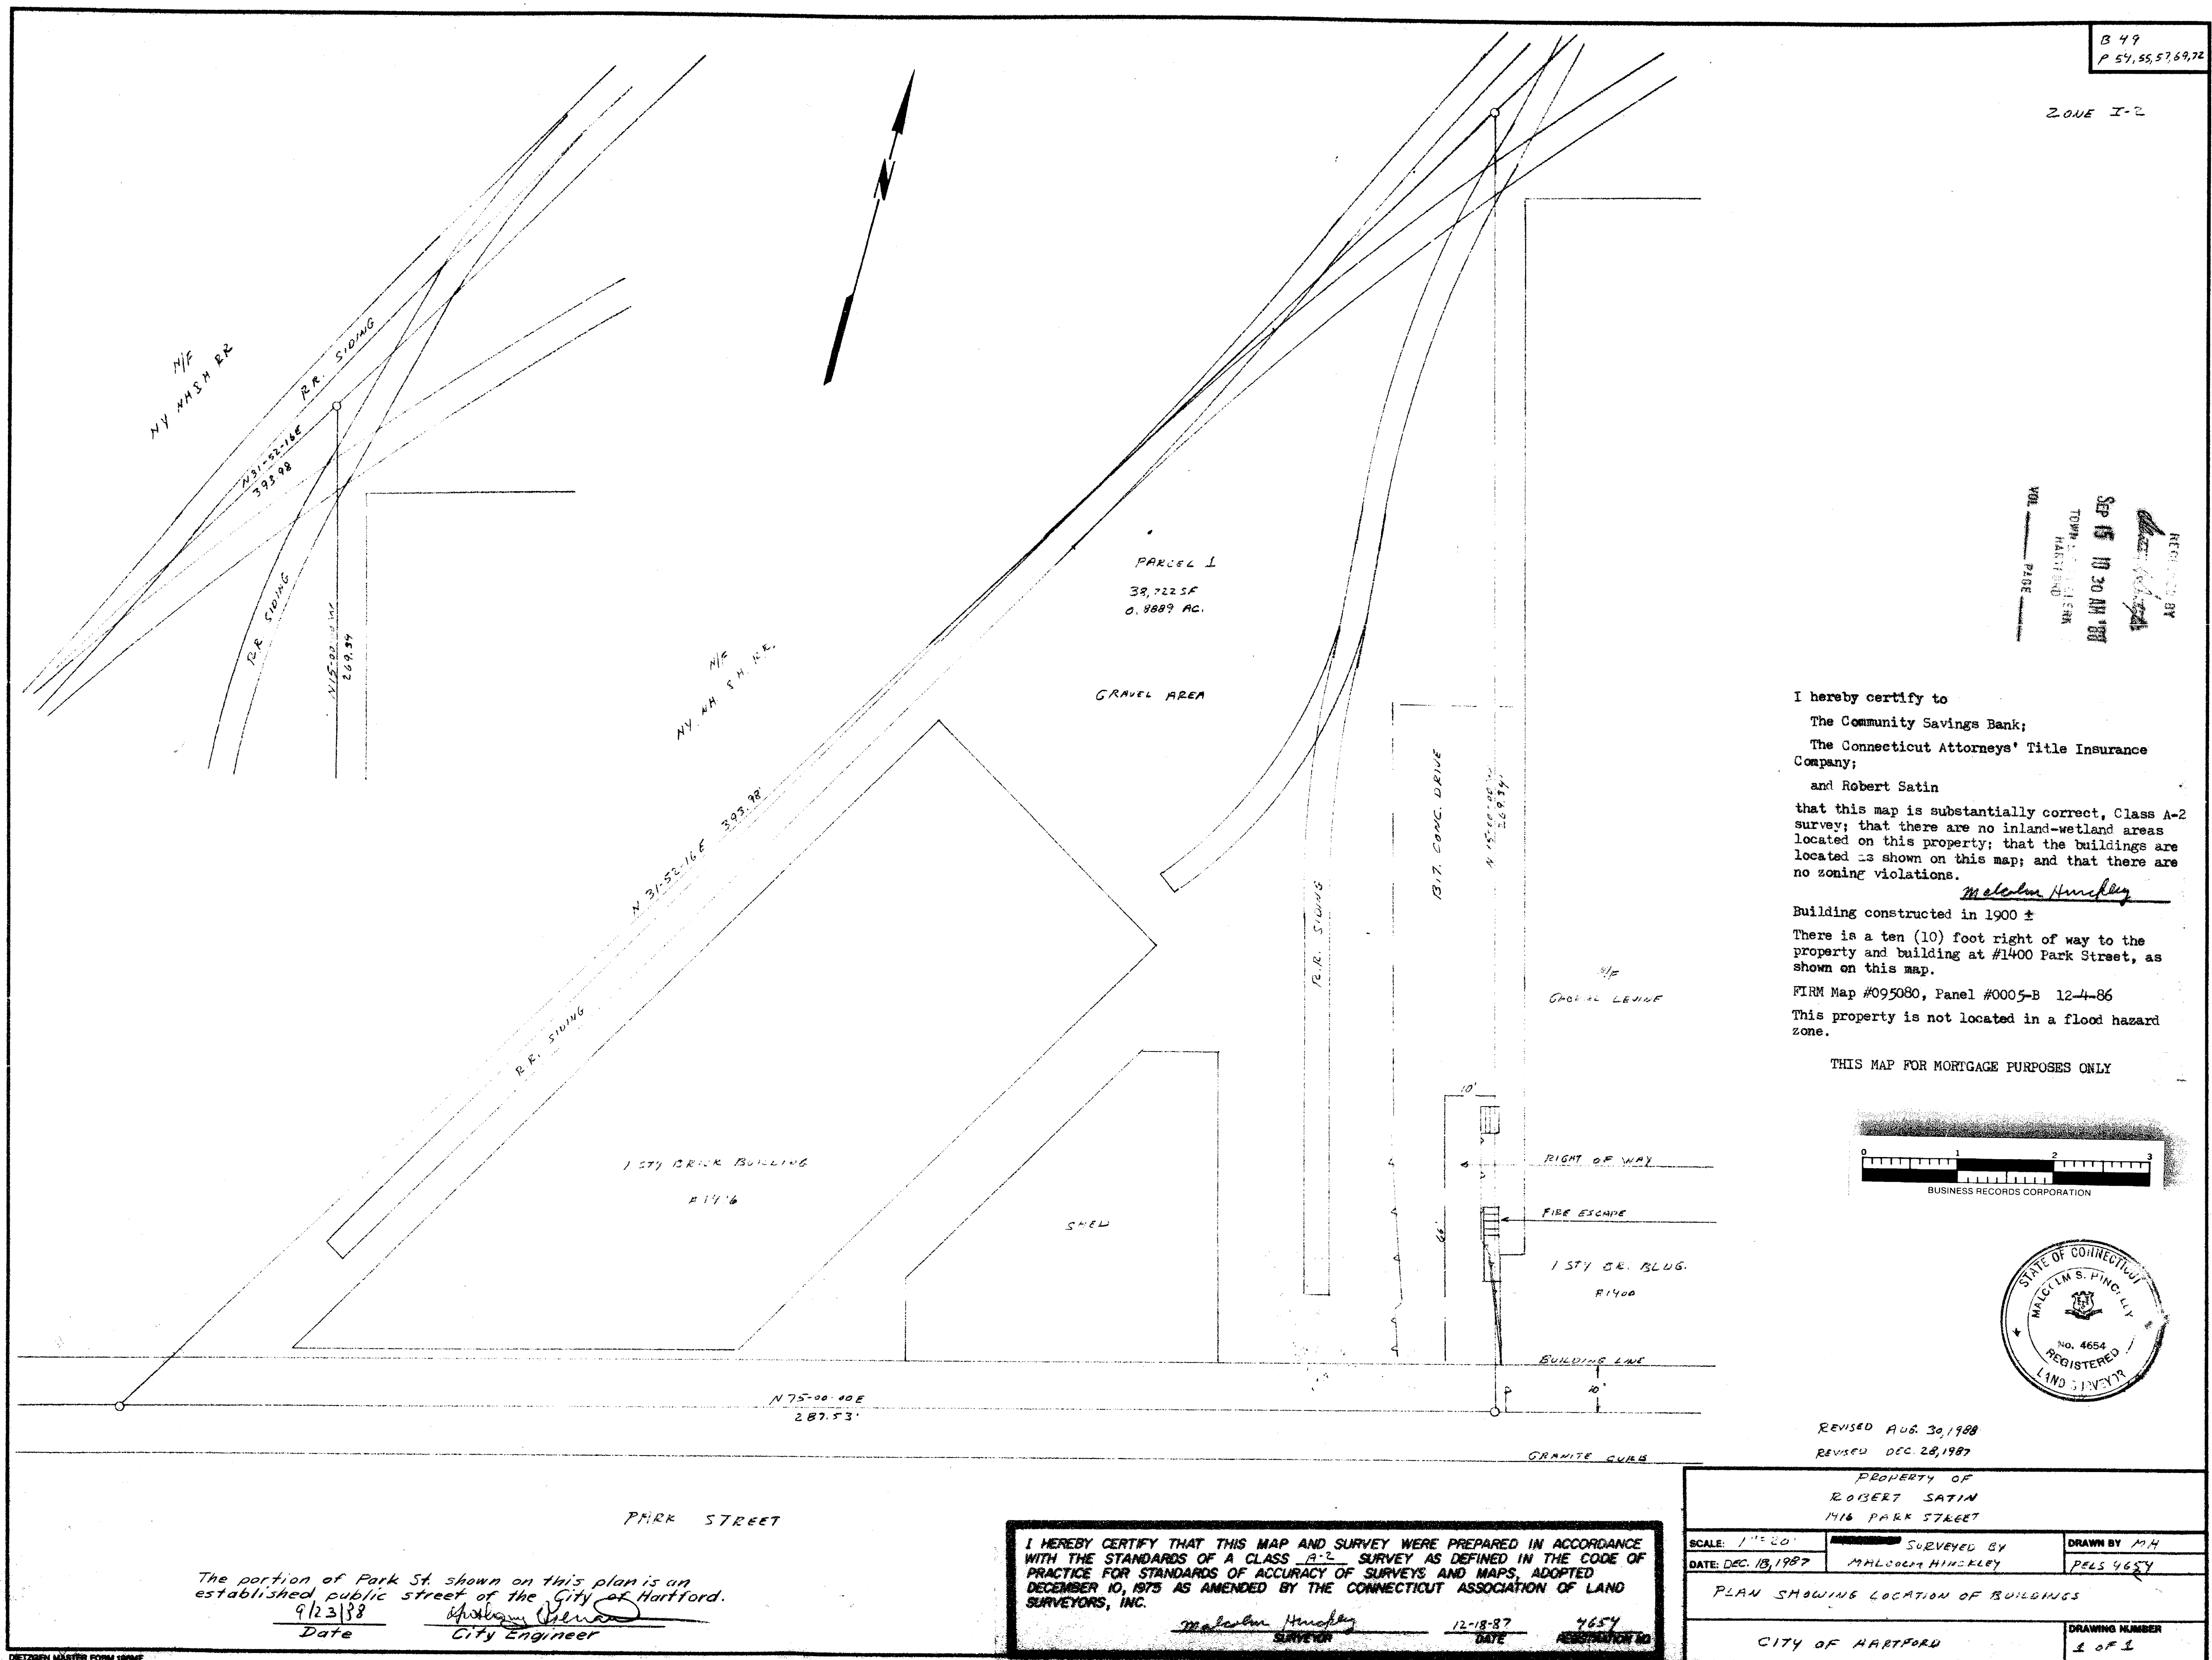

I hereby certify to
The Community Savings Bank;
The Connecticut Attorneys' Title Insurance
Company;
and Robert Satin
that this map is substantially correct, Class A-2
survey; that there are no inland-wetland areas
located on this property; that the buildings are
located as shown on this map; and that there are
no zoning violations.
Building constructed in 1900 ±
There is a ten (10) foot right of way to the
property and building at #1400 Park Street, as
shown on this map.
FIRM Map #095080, Panel #0005-B 12-4-86
This property is not located in a flood hazard
zone.
THIS MAP FOR MORTGAGE PURPOSES ONLY

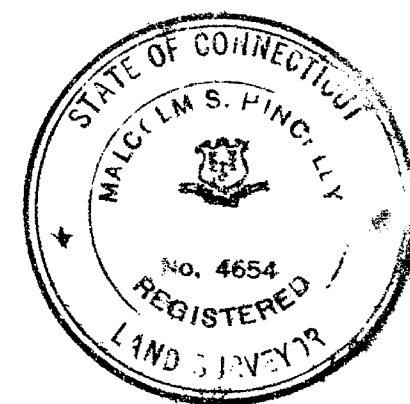

REVISED AUG. 30, 1988
REVISED DEC. 28, 1987

PROPERTY OF ROBERT SATIN 1716 PARK STREET		
SCALE 1"=20'	SURVEYED BY MALCOLM HINCKLEY	DRAWN BY MH
DATE DEC. 18, 1987		FILED 4654
PLAN SHOWING LOCATION OF BUILDINGS		
CITY OF HARTFORD		DRAWING NUMBER 1 OF 1

I HEREBY CERTIFY THAT THIS MAP AND SURVEY WERE PREPARED IN ACCORDANCE
WITH THE STANDARDS OF A CLASS A-2 SURVEY AS DEFINED IN THE CODE OF
PRACTICE FOR STANDARDS OF ACCURACY OF SURVEYS AND MAPS, ADOPTED
DECEMBER 10, 1975 AS AMENDED BY THE CONNECTICUT ASSOCIATION OF LAND
SURVEYORS, INC.
MALCOLM HINCKLEY
SURVEYOR
12-18-87
DATE
4654
REGISTRATION NO.

The portion of Park St. shown on this plan is an
established public street of the City of Hartford.
9/23/88
Date
City Engineer