



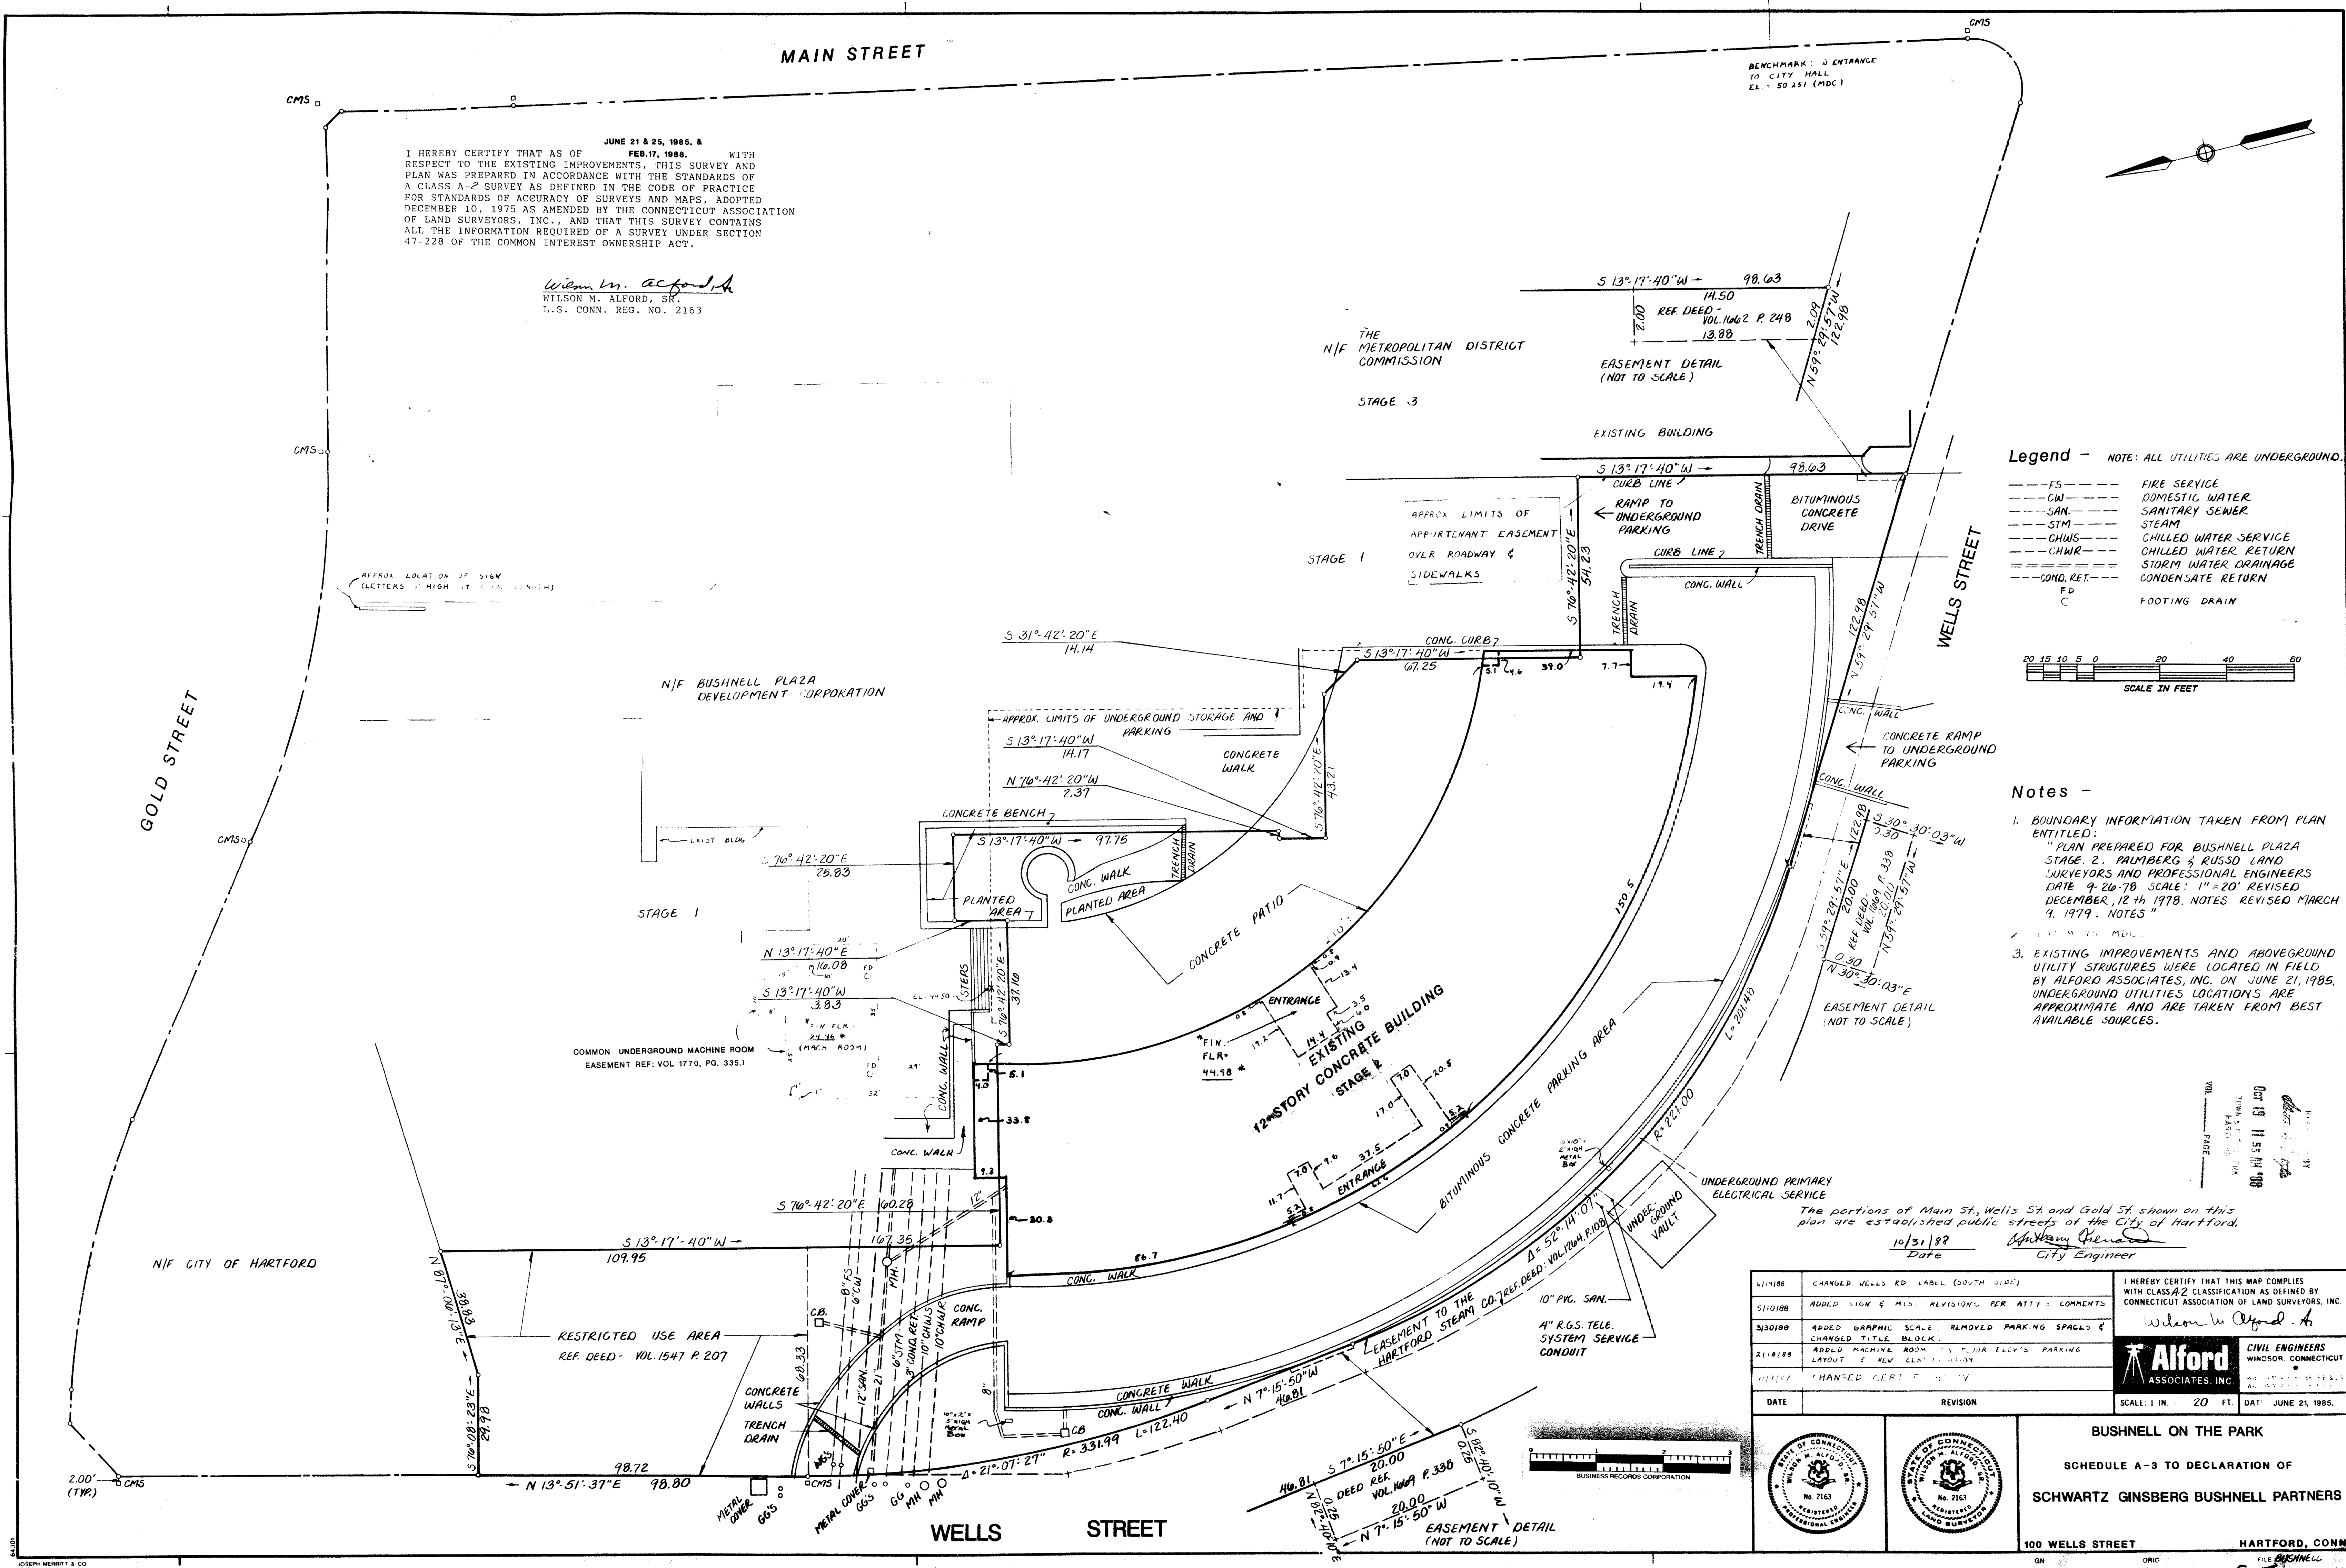

I HEREBY CERTIFY THAT AS OF JUNE 21 & 25, 1985, & FEB. 17, 1988, WITH RESPECT TO THE EXISTING IMPROVEMENTS, THIS SURVEY AND PLAN WAS PREPARED IN ACCORDANCE WITH THE STANDARDS OF A CLASS A-2 SURVEY AS DEFINED IN THE CODE OF PRACTICE FOR STANDARDS OF ACCURACY OF SURVEYS AND MAPS, ADOPTED DECEMBER 10, 1975 AS AMENDED BY THE CONNECTICUT ASSOCIATION OF LAND SURVEYORS, INC., AND THAT THIS SURVEY CONTAINS ALL THE INFORMATION REQUIRED OF A SURVEY UNDER SECTION 47-228 OF THE COMMON INTEREST OWNERSHIP ACT.

Wilson M. Alford, Jr.
WILSON M. ALFORD, JR.
U.S. CONN. REG. NO. 2163

- Legend - NOTE: ALL UTILITIES ARE UNDERGROUND.
- FS FIRE SERVICE
 - DW DOMESTIC WATER
 - SAN SANITARY SEWER
 - STM STEAM
 - CHWS CHILLED WATER SERVICE
 - CHWR CHILLED WATER RETURN
 - COND. RET. CONDENSATE RETURN
 - FD FOOTING DRAIN

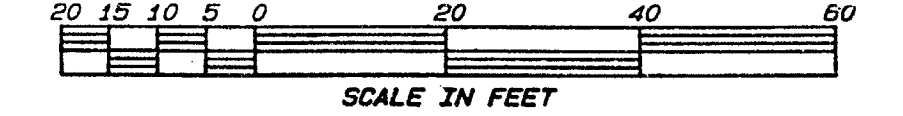

- Notes -
- BOUNDARY INFORMATION TAKEN FROM PLAN ENTITLED: "PLAN PREPARED FOR BUSHNELL PLAZA STAGE 2. PALMBERG & RUSSO LAND SURVEYORS AND PROFESSIONAL ENGINEERS DATE 9-20-78 SCALE: 1"=20' REVISED DECEMBER, 12th 1978. NOTES REVISED MARCH 4, 1979. NOTES"
 - EXISTING IMPROVEMENTS AND ABOVEGROUND UTILITY STRUCTURES WERE LOCATED IN FIELD BY ALFORD ASSOCIATES, INC. ON JUNE 21, 1985. UNDERGROUND UTILITIES LOCATIONS ARE APPROXIMATE AND ARE TAKEN FROM BEST AVAILABLE SOURCES.

10/31/88 Date
City Engineer

5/1/88	CHANGED WELLS RD LABEL (SOUTH SIDE)	I HEREBY CERTIFY THAT THIS MAP COMPLIES WITH CLASS A-2 CLASSIFICATION AS DEFINED BY CONNECTICUT ASSOCIATION OF LAND SURVEYORS, INC. <i>Wilson M. Alford, Jr.</i> Alford ASSOCIATES, INC. CIVIL ENGINEERS WINDSOR, CONNECTICUT
5/1/88	ADDED SIGN & MISC. REVISIONS PER ATTY COMMENTS	
3/30/88	ADDED GRAPHIC SCALE REMOVED PARKING SPACES & CHANGED TITLE BLOCK	
2/1/88	ADDED MACHINE ROOM TO FLOOR ELEV'S PARKING LAYOUT & NEW CLEARANCE	
DATE	REVISION	SCALE: 1 IN. = 20 FT. DATE: JUNE 21, 1985.
BUSHNELL ON THE PARK SCHEDULE A-3 TO DECLARATION OF SCHWARTZ GINSBERG BUSHNELL PARTNERS		
100 WELLS STREET HARTFORD, CONN.		

1785