

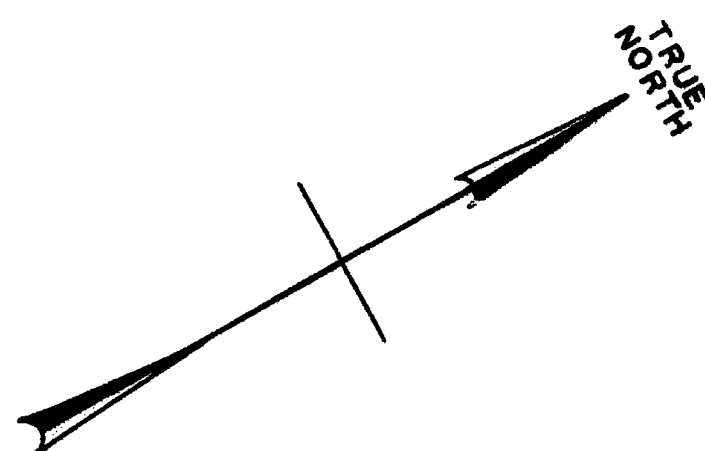


1789

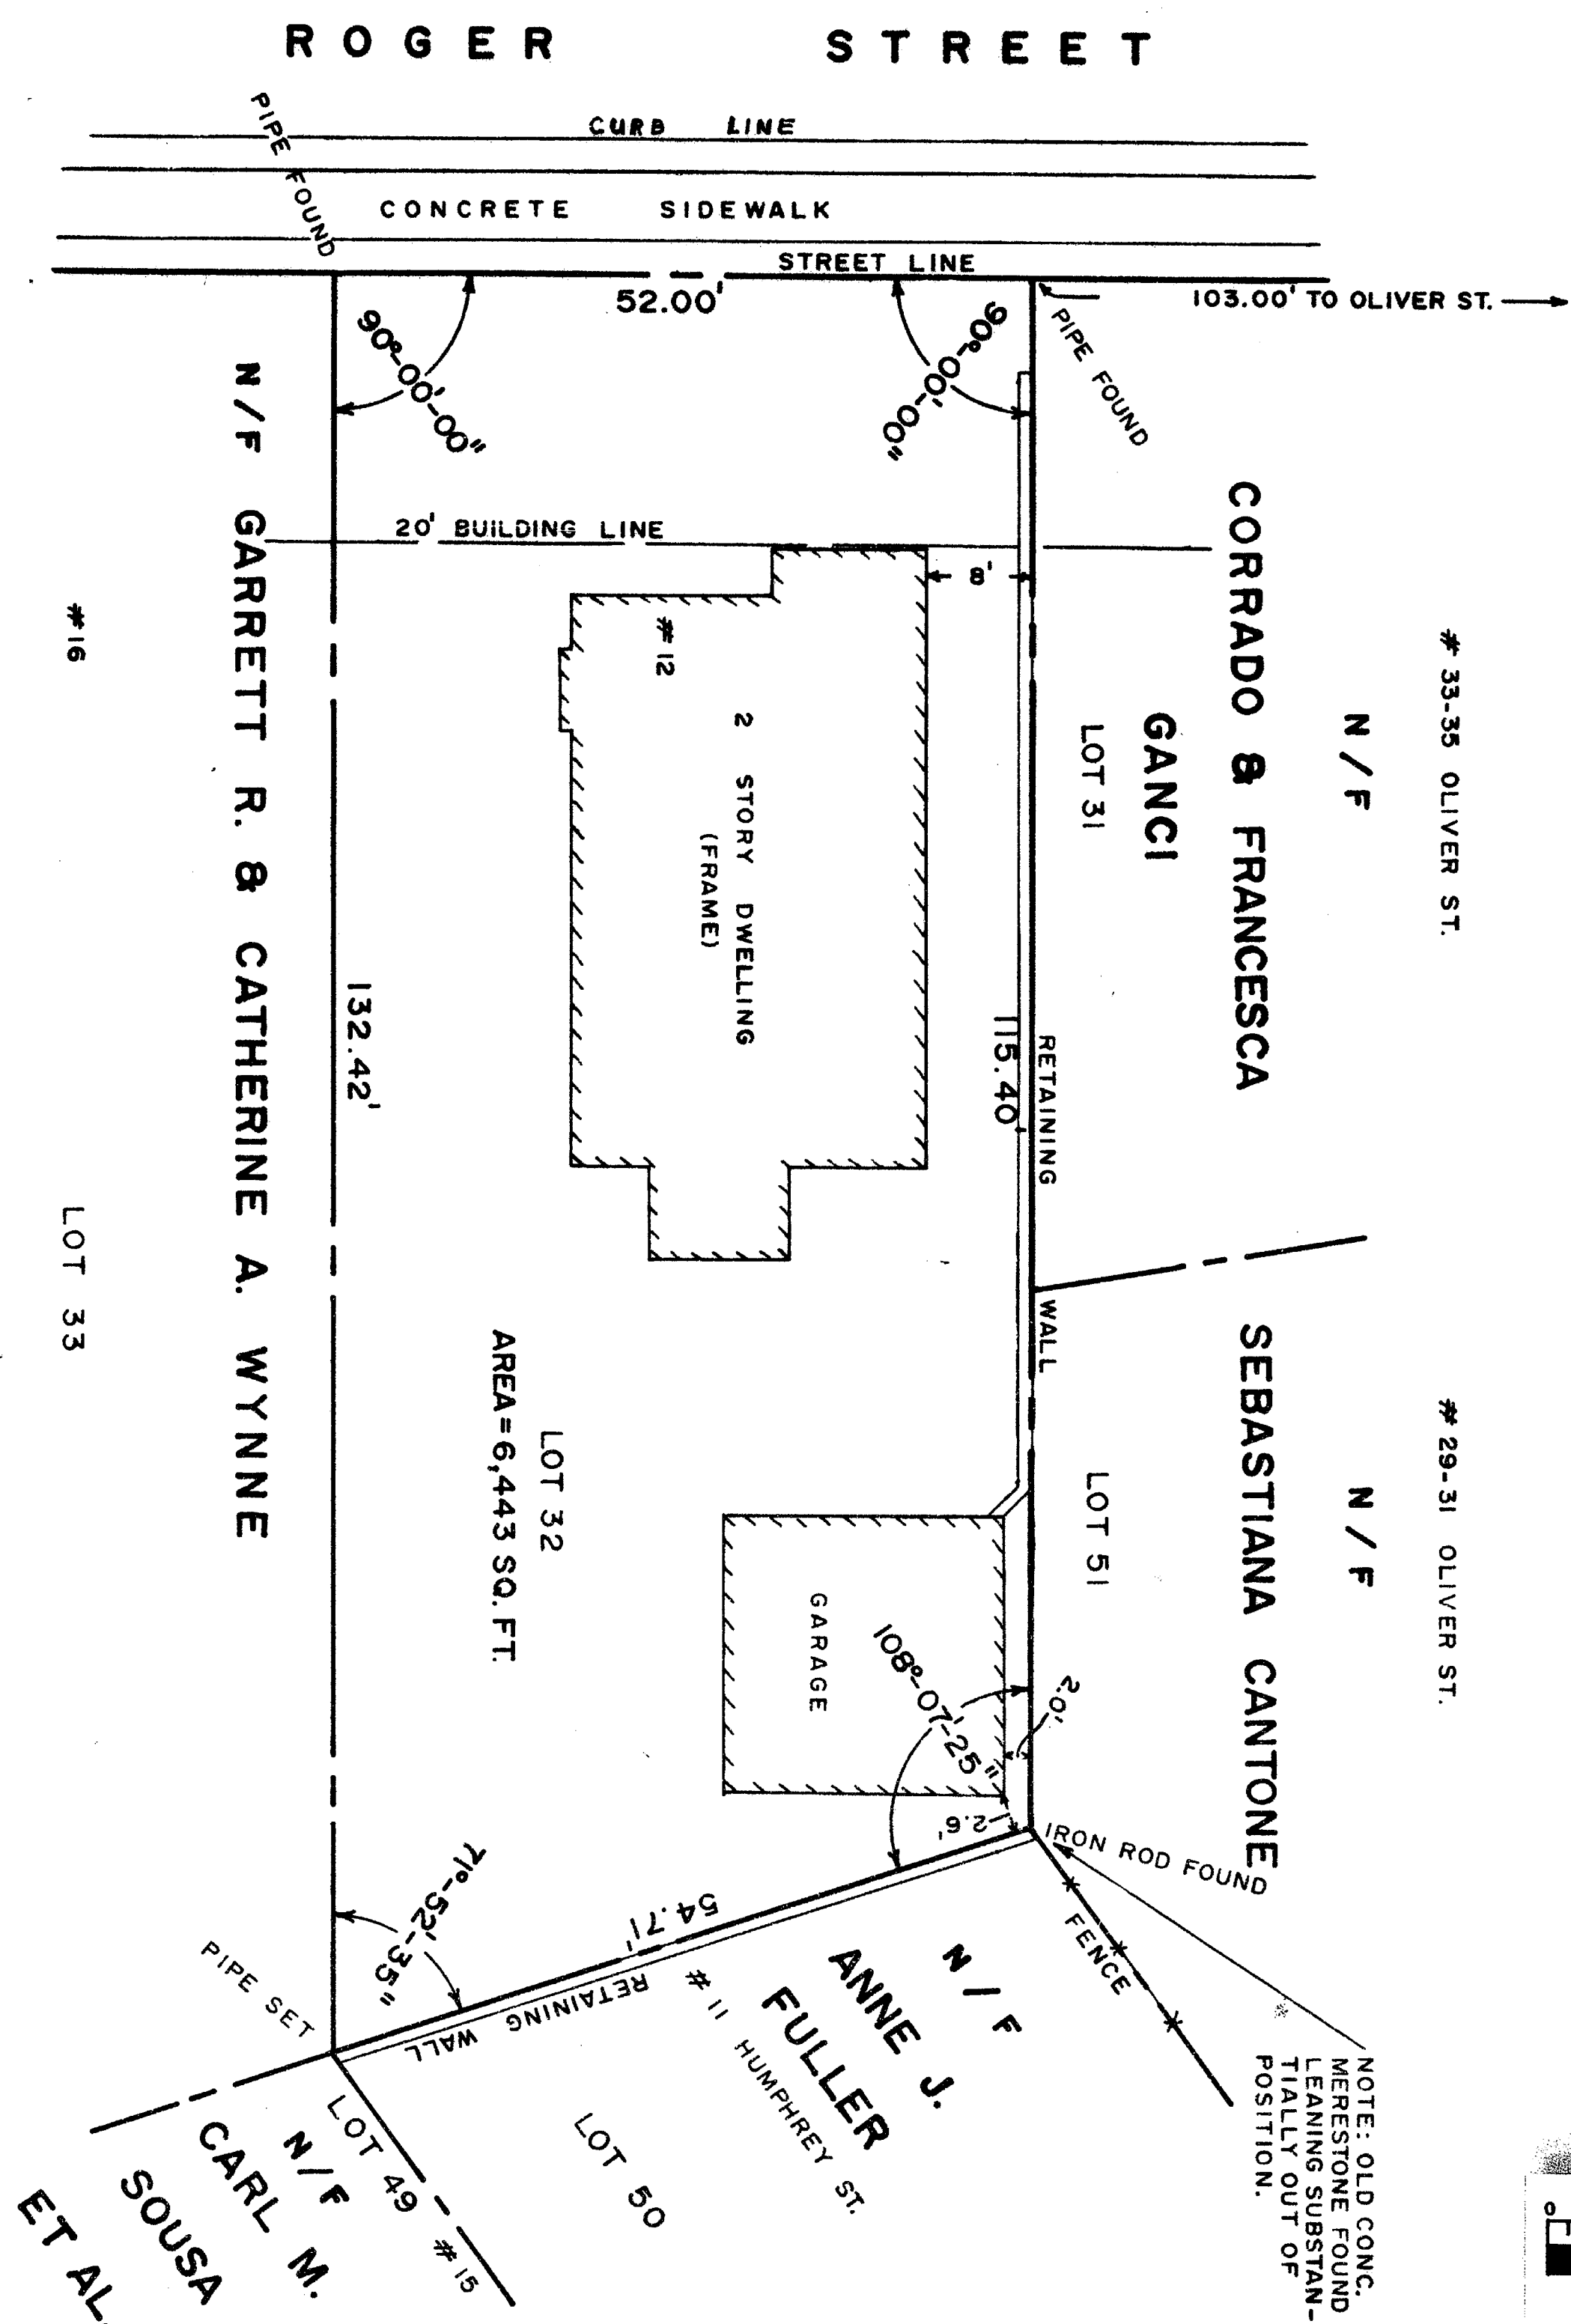

RECORDED BY
Nov 1 11 06 AM '88
TOWN OF HARTFORD
HARTFORD
VOL. PAGE


NOTE: REFERENCE IS MADE TO A MAP PREPARED BY THIS OFFICE
FOR CARL F. OSTLUND IN JANUARY, 1941.

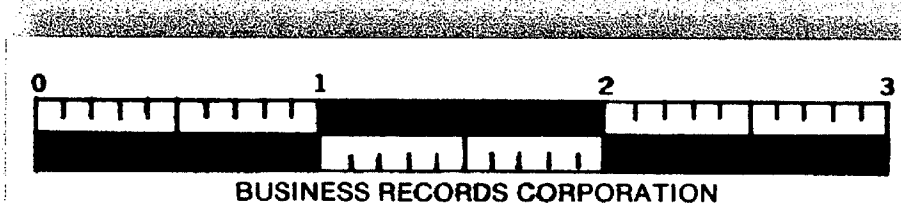

The portion of Roger St. shown on this plan is an
established public street of the City of Hartford.
11/5/88
Date
City Engineer

I HEREBY DECLARE THAT THIS MAP IS SUBSTANTIALLY CORRECT
AND THAT THE SURVEY WAS PREPARED IN ACCORDANCE WITH
THE STANDARDS OF A CLASS A-2 SURVEY AS DEFINED IN THE
RECOMMENDED STANDARDS FOR SURVEYS AND MAPS IN THE STATE OF
CONNECTICUT, AND THAT I AM A MEMBER OF THE ASSOCIATION OF
LAND SURVEYORS, INC. ON SEPTEMBER 15, 1984.

OCT. 31, 1988
E. & Smith

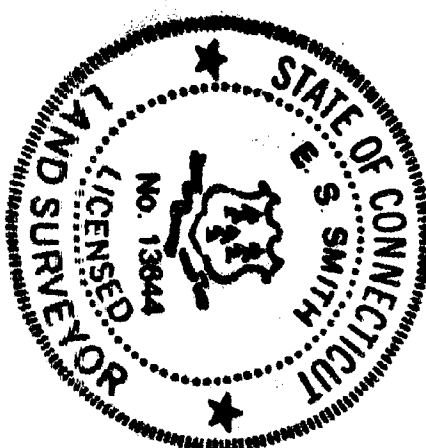

N.E. 108-99 T.2, S.1, R.1 D. 3827

PROPERTY OF
WALLACE & JULIA GNYLA
12 ROGER STREET
HARTFORD, CONNECTICUT

SCALE: 1 INCH = 16 FEET
OCTOBER, 1988



PETERSEN & HOFFMAN — LAND SURVEYORS
SUCCESSORS TO SPENCER & WASHBURN, INC.
1000 FARMINGTON AVE., WEST HARTFORD, CT 06107

1789 128

1789
EAST FILE CORP. HARTFORD, CT
EPM 34