


BENCHMARK:
ELEV. 77.09
FIRE HYD. TOP SPINDLE

NOTES:
1. MAP REF.: "PROPERTY OF JOSEPH W. & JACK J. BORDIERI, #2053, 2061, 2071-2073 PARK STREET HARTFORD, CONNECTICUT SCALE 1"=20' JULY 10, 1986" CERTIFIED CLASS A-2 RUSSELL J. CARLO, LS# B156
2. ZONE B-4

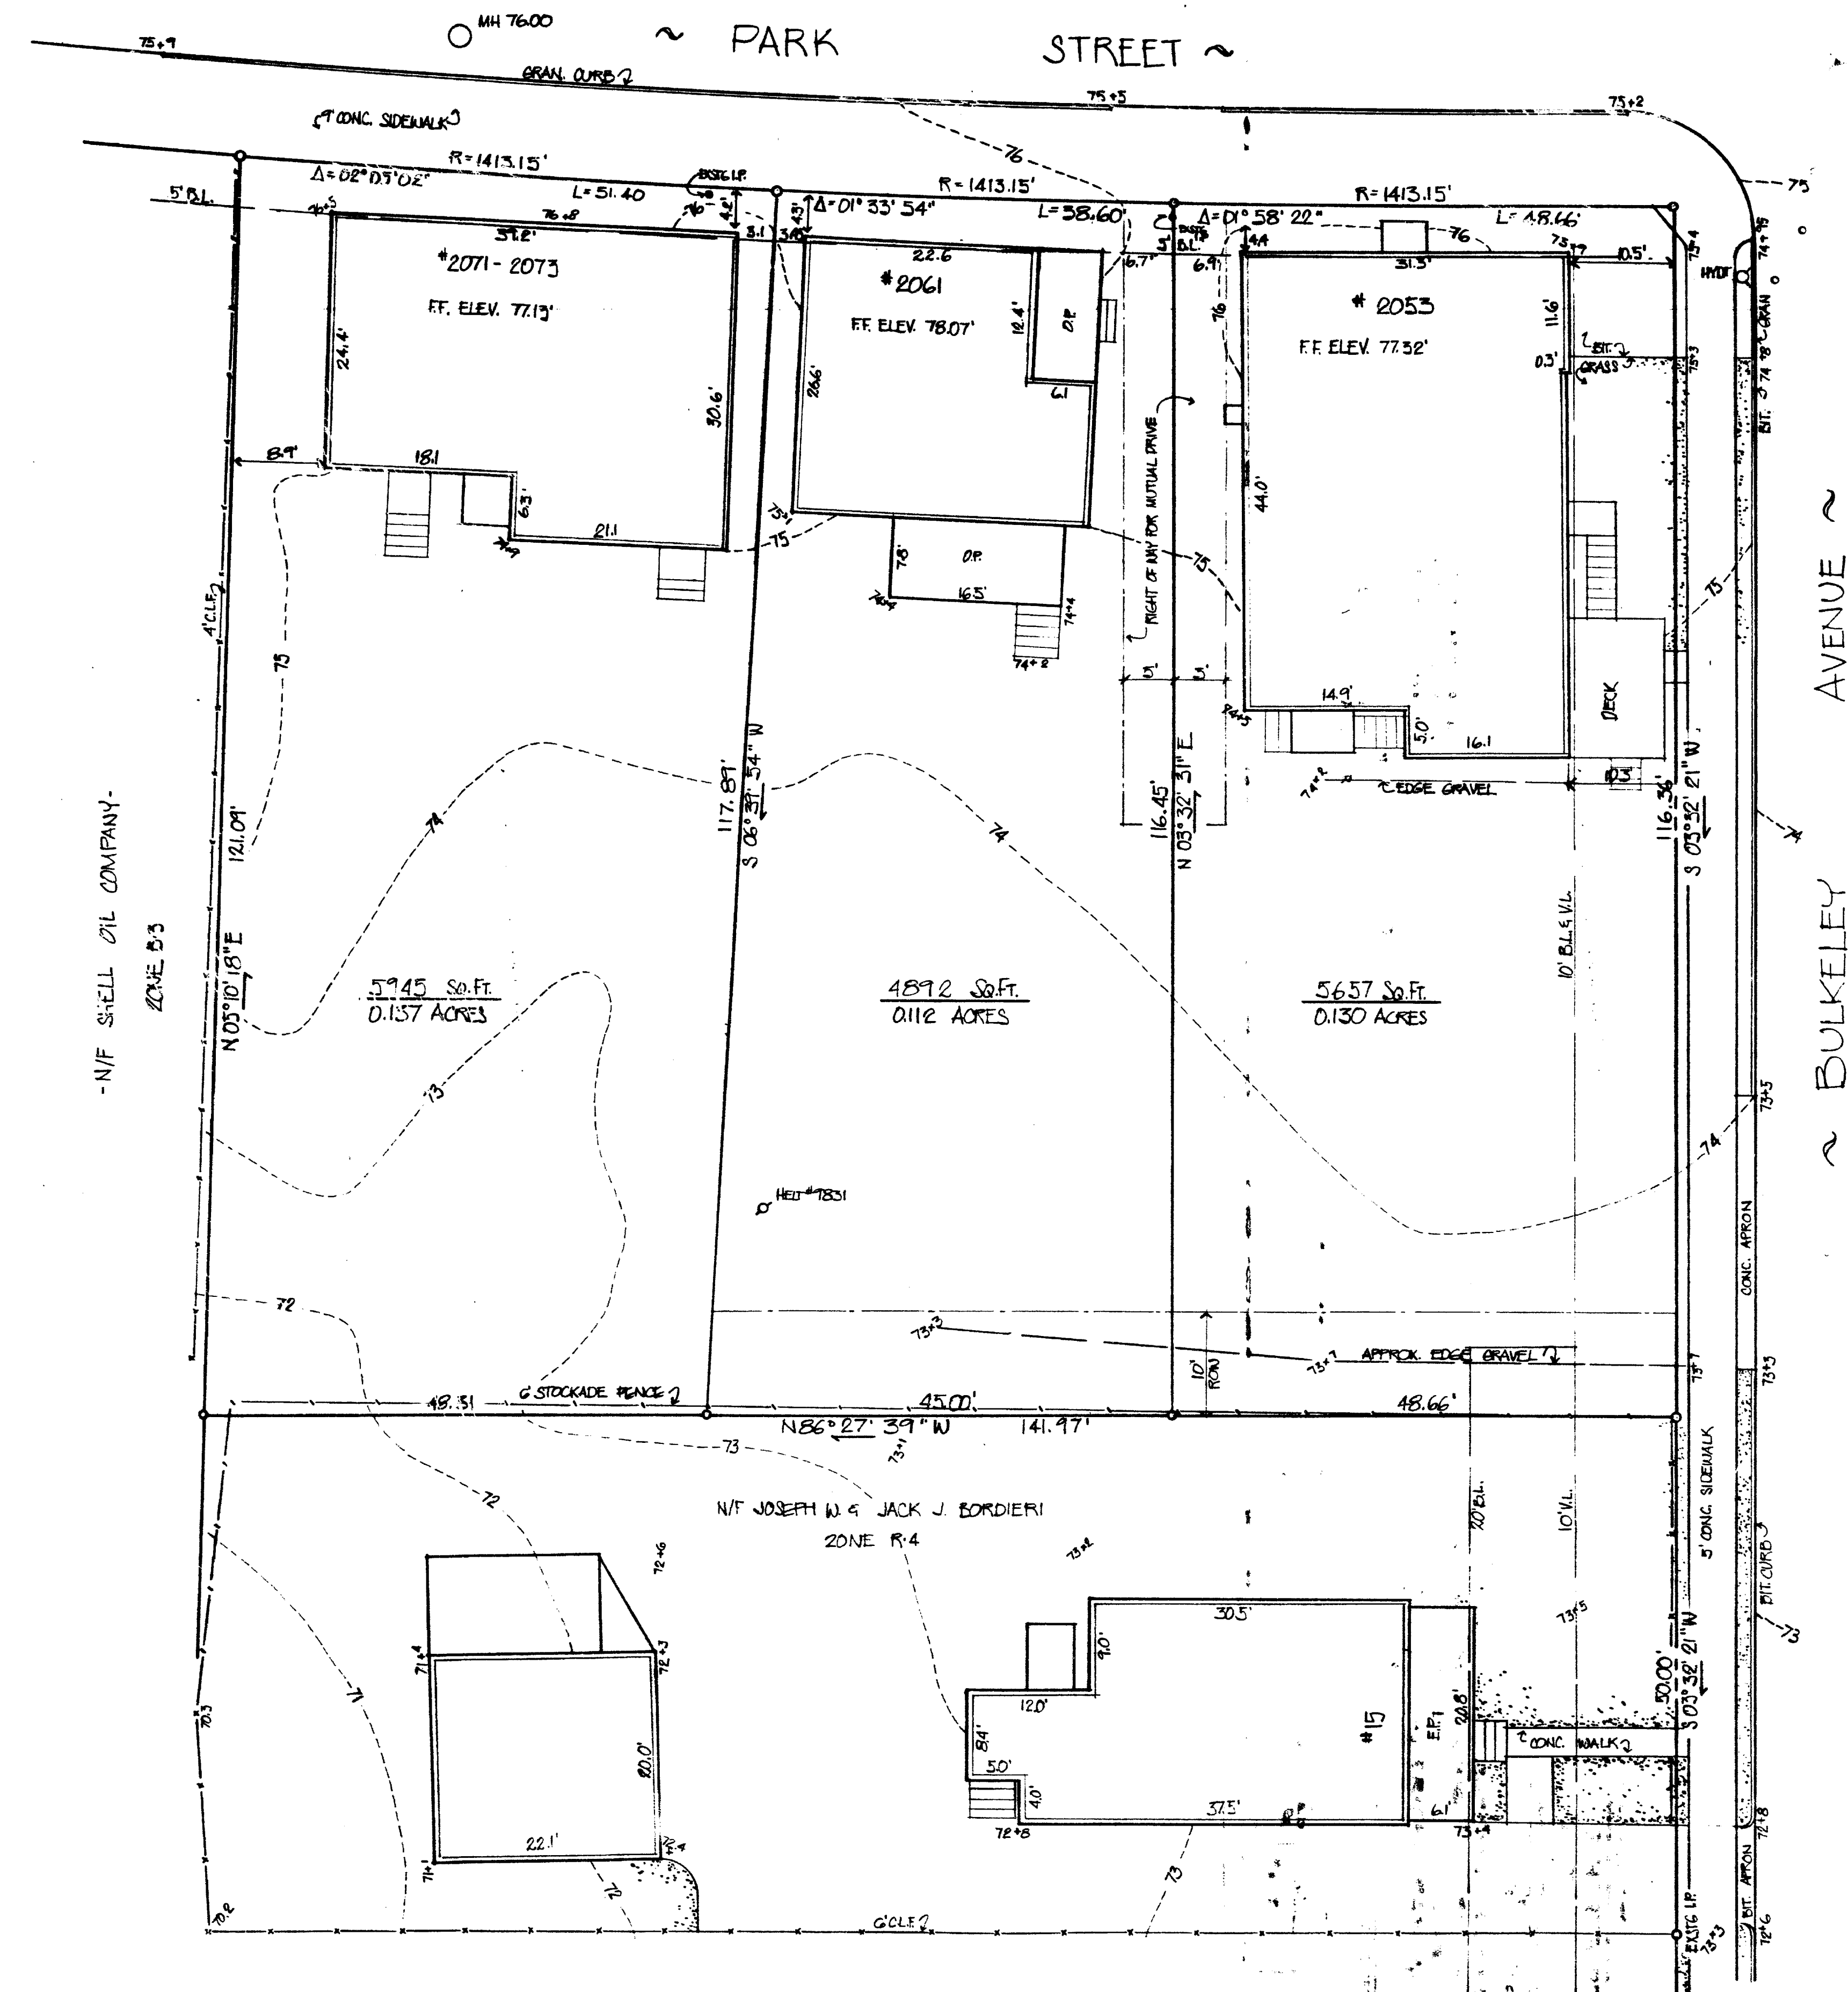

To:
First National Bank
1 Commercial Plaza
Hartford, Connecticut
Security Title and Guaranty Company
50 Founders Plaza
East Hartford, Connecticut
I hereby declare that this survey was actually made upon the ground on 8-31-1988 and that it and the bounds and measurements shown hereon are correct within the standards of a Class A-2 survey of the Code of Recommended Practice for Standards of Accuracy of Surveys and Maps and that unless otherwise shown, deed lines and lines of actual possession are the same; buildings are located as shown and do not encroach over street, deed, or building lines; there are no violations of zoning regulations with reference to the locations of said buildings; and there are no easements affecting the property apparent from a careful inspection of the same, other than those shown or depicted hereon.

John Lawrence Jr. LS #7394
DATE 9-6-88 REG
I HEREBY DECLARE THAT THIS MAP IS SUBSTANTIALLY CORRECT. THIS MAP AND SURVEY WERE PREPARED IN ACCORDANCE WITH THE STANDARDS OF A CLASS A-2 SURVEY AS DEFINED IN THE "RECOMMENDED STANDARDS FOR SURVEYS AND MAPS IN THE STATE OF CONNECTICUT" AS PREPARED AND ADOPTED BY THE CONNECTICUT ASSOCIATION OF LAND SURVEYORS, INC. ON SEPTEMBER 13, 1984.

NO.	11-0588	DECLARATION ADDED	J.D.P.
DATE		REVISION	BY
DOLORES SULLIVAN #2053, 2061 & 2071-73 PARK STREET HARTFORD, CONNECTICUT		1"=10' SEPT. 1988 J.D.P.	
JOHN LAWRENCE ASSOC. Engineers - Surveyors		OF SHEETS	

1791