


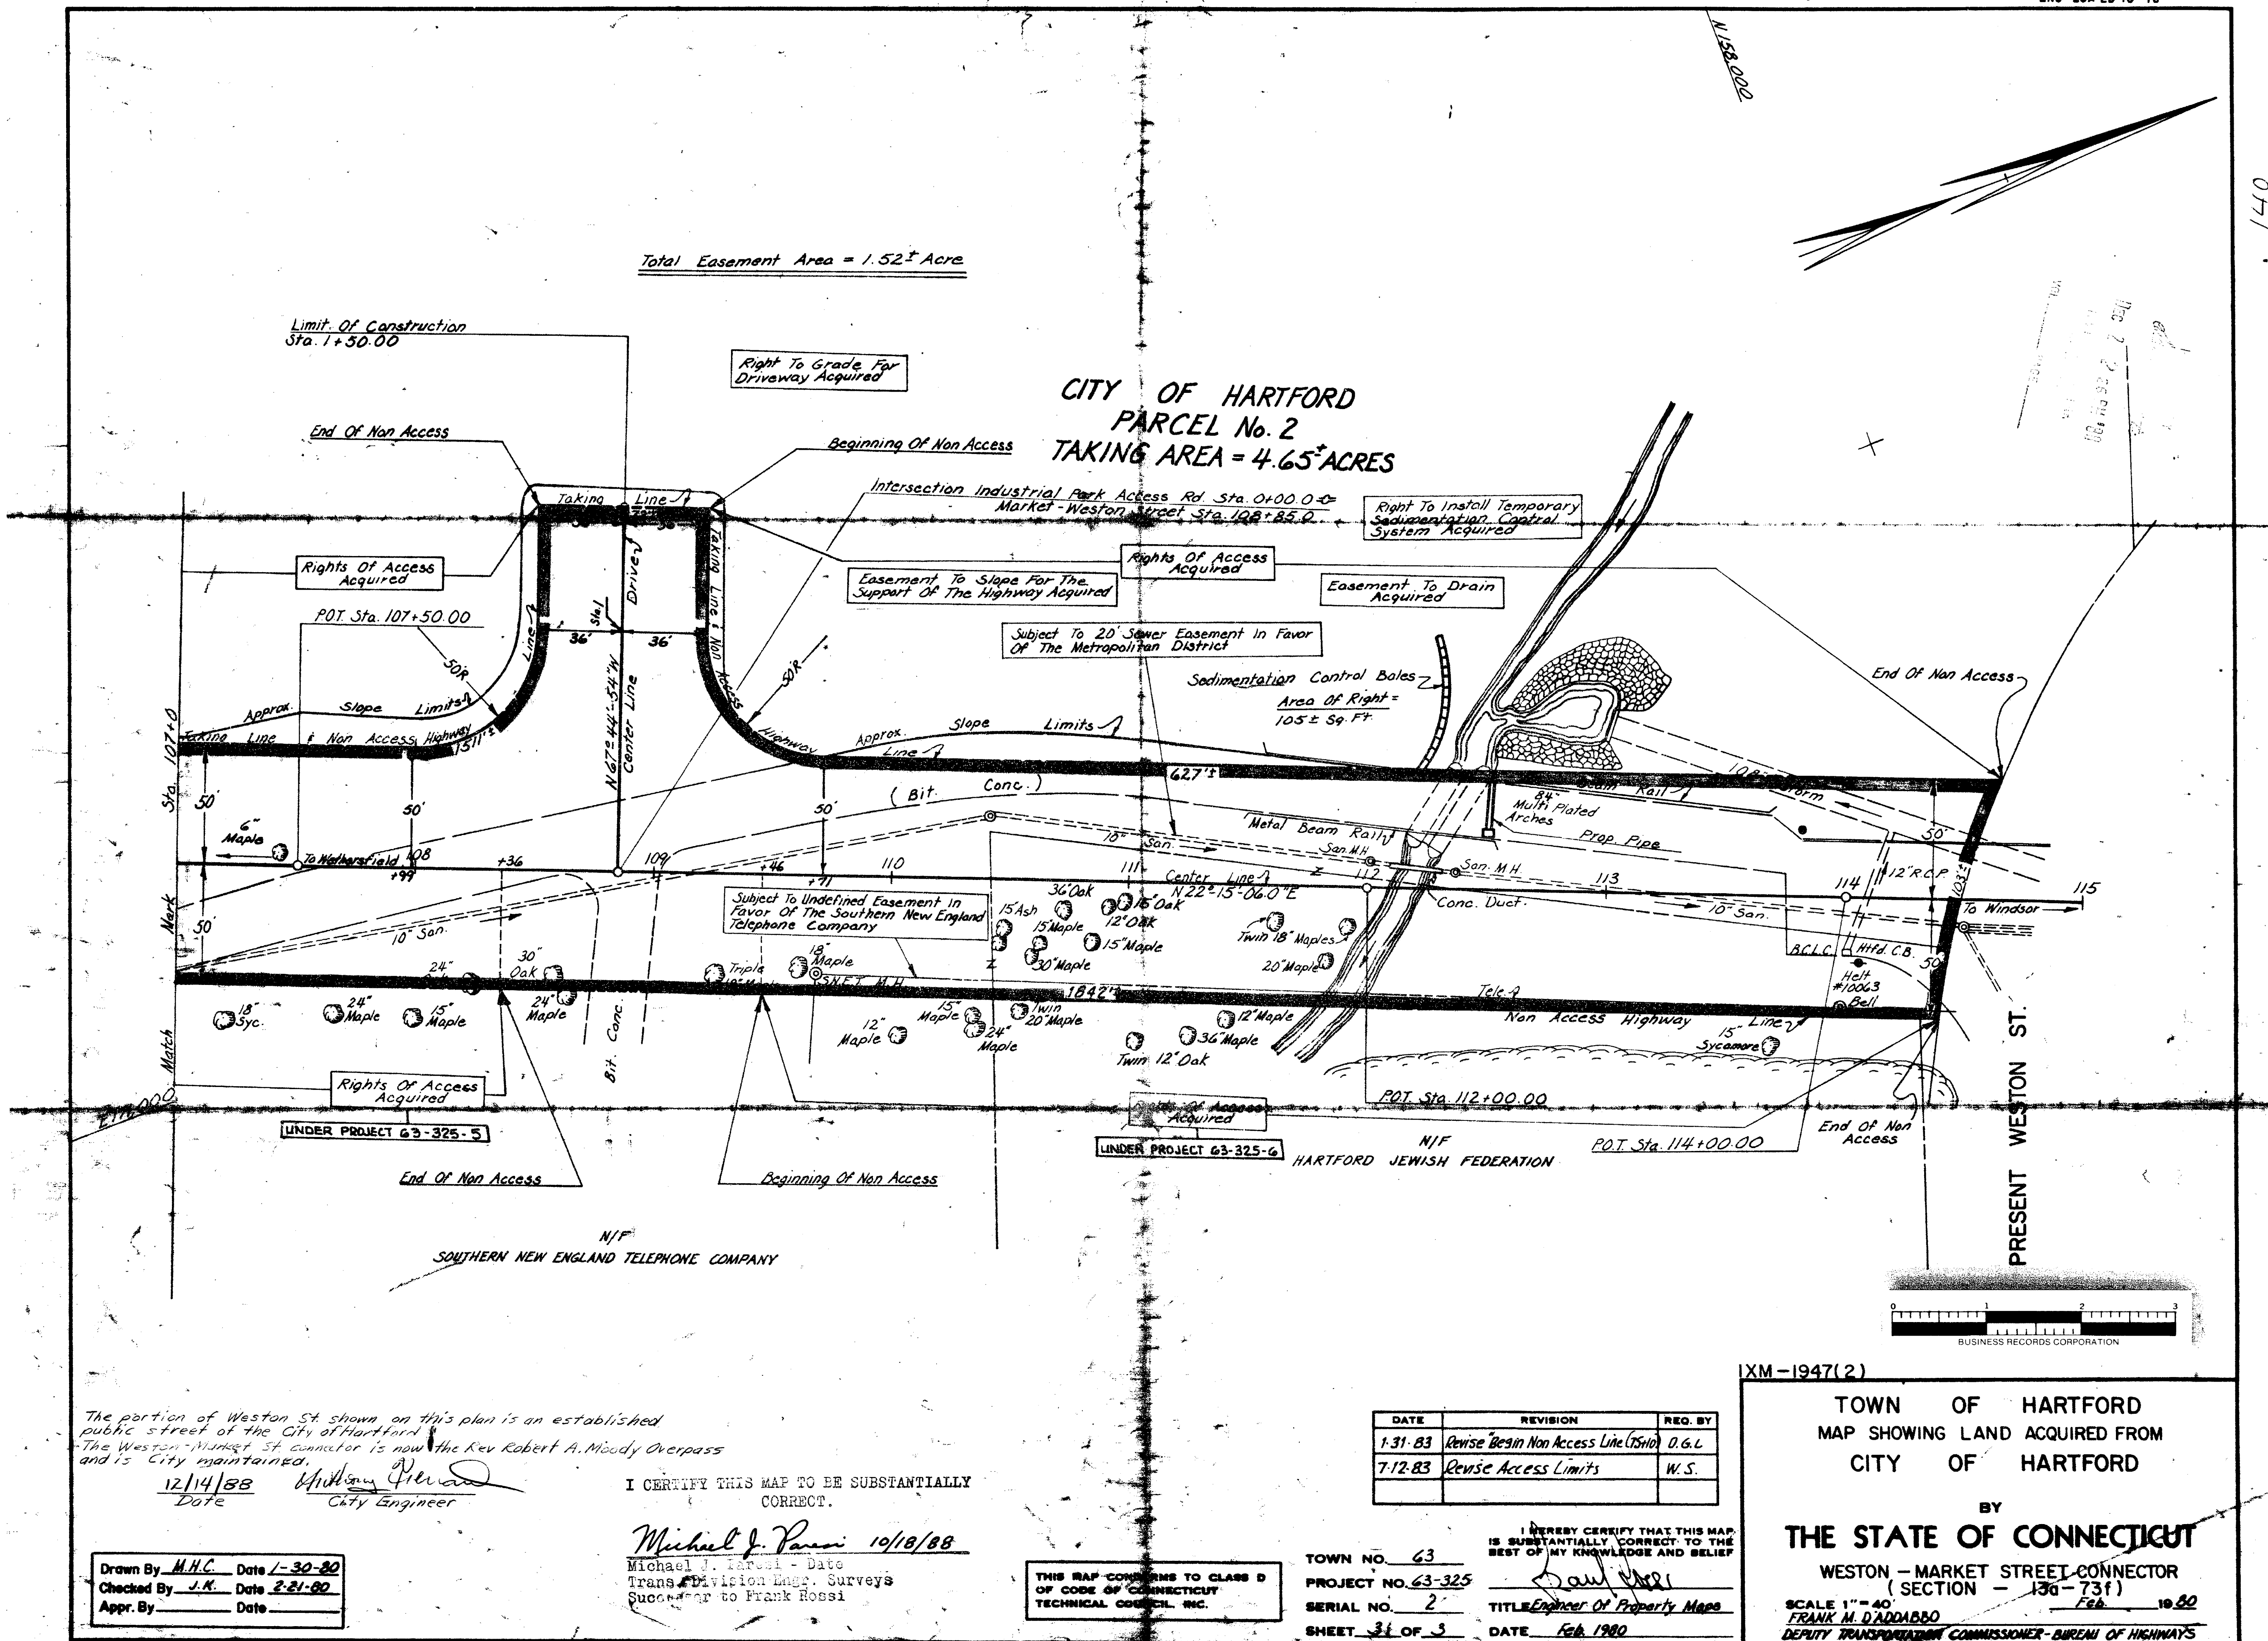

1801