
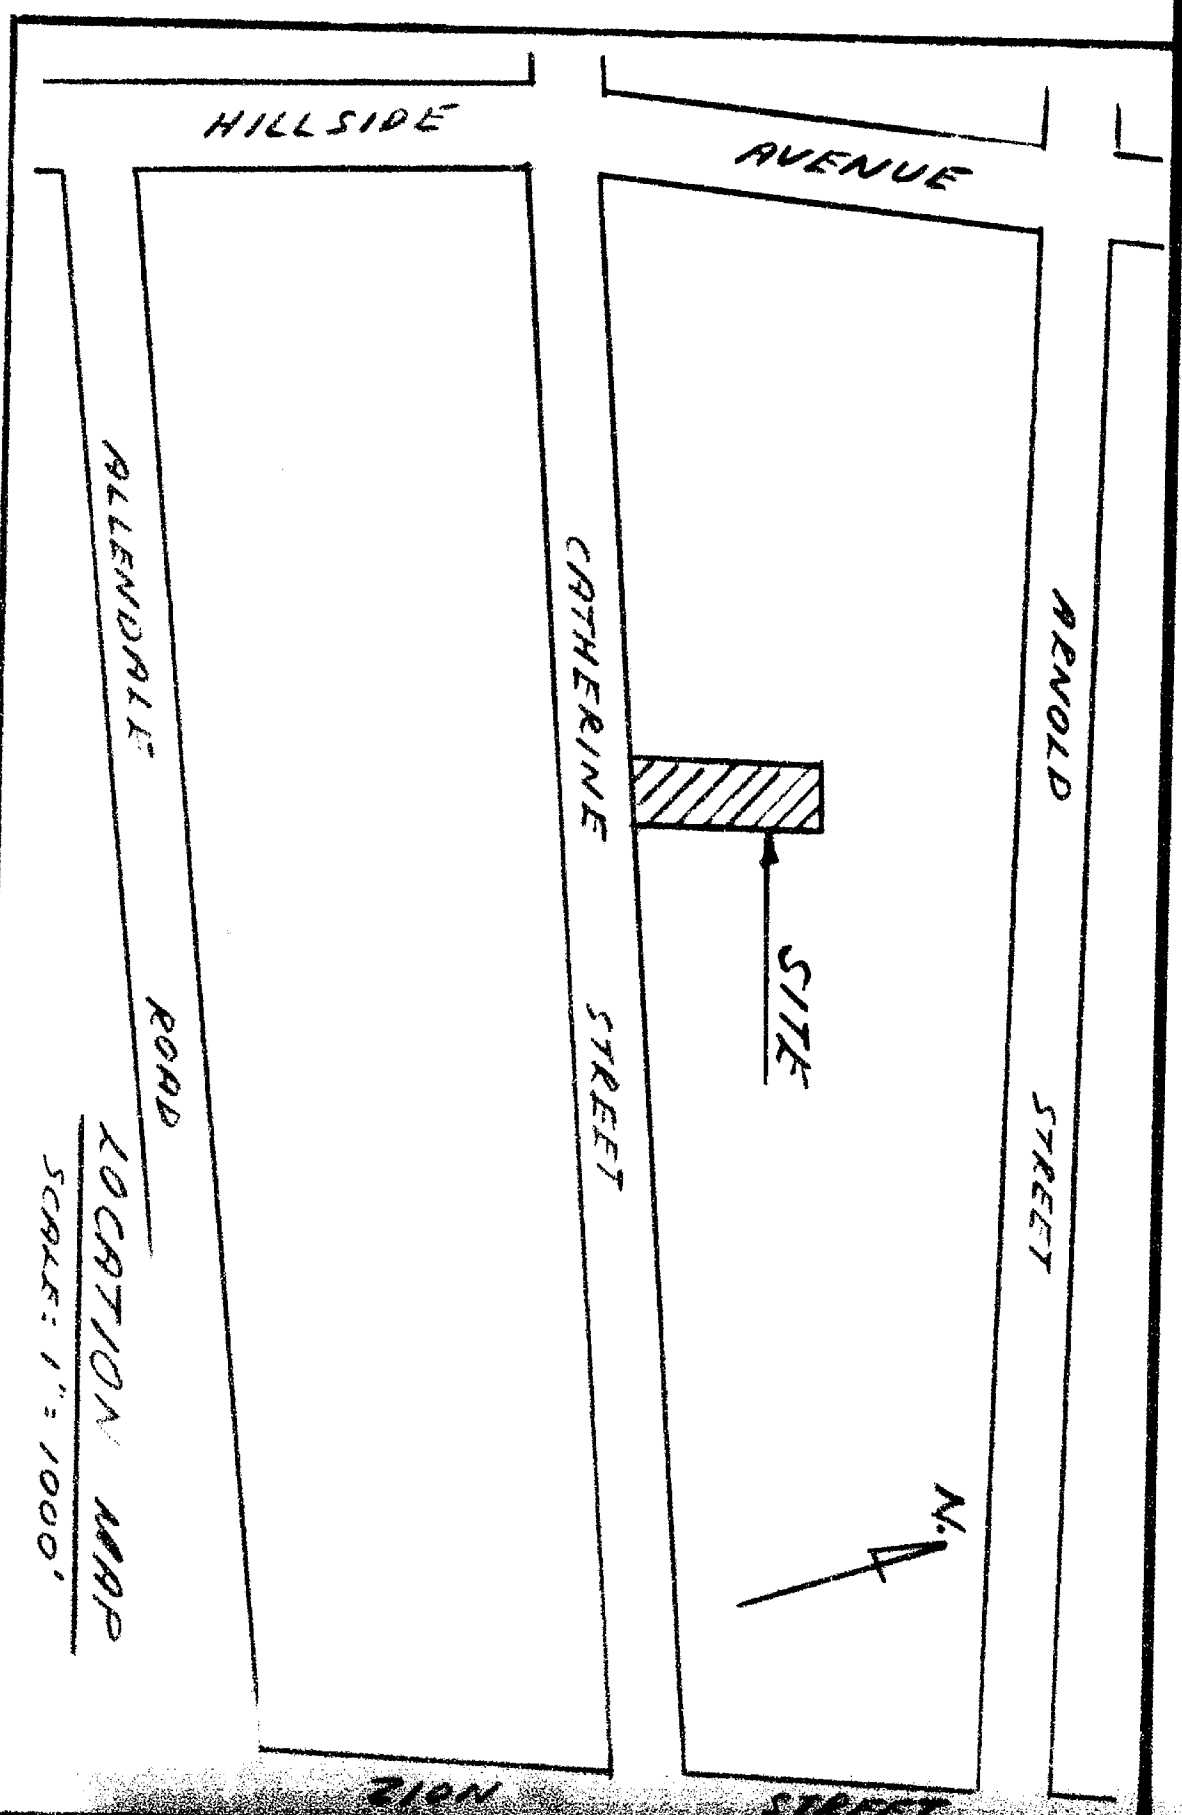


1845

PROPERTY SURVEYED FOR
MANUEL R. & ADELIA C. COSTA
56-60 CATHERINE STREET
HARTFORD, CONNECTICUT
14 SEPTEMBER, 1988
SCALE: 1"=20'

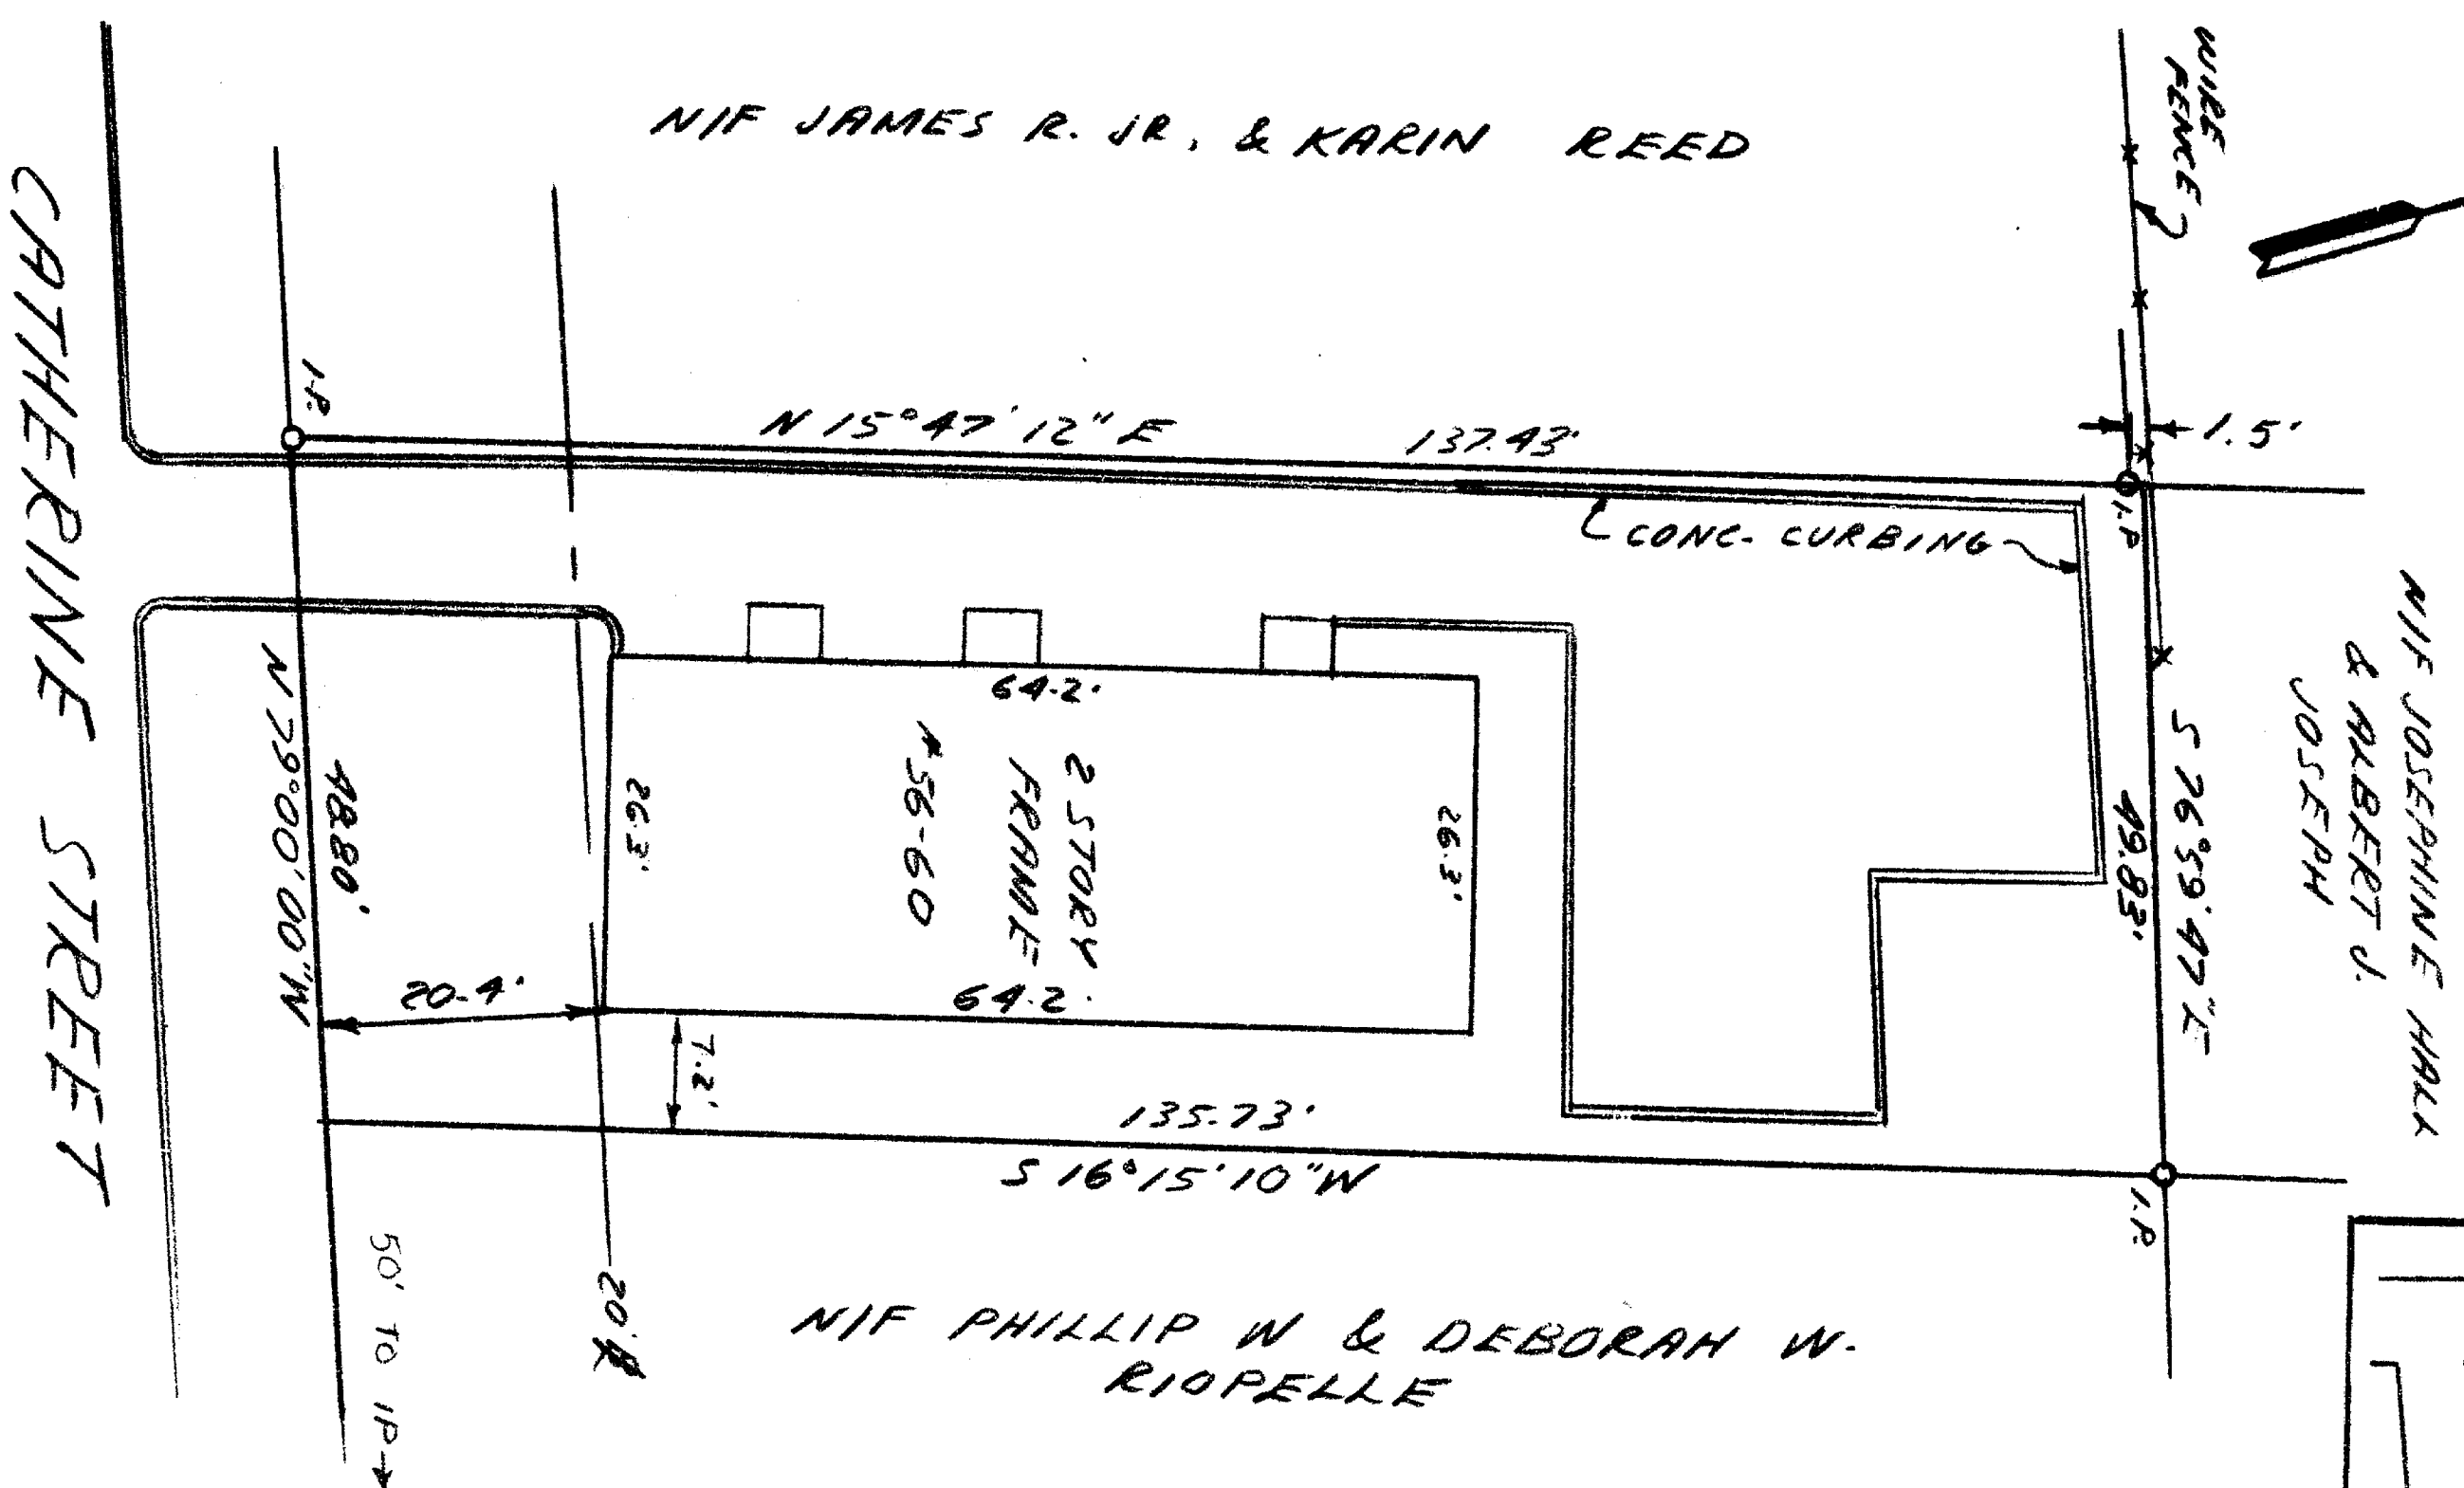

NOTES:

1. LOT ZONE: R-4
2. LOT AREA: 6716 SQ. FT.
3. PROPERTY DOES NOT LIE IN A DESIGNATED FLOOD HAZARD ZONE.
4. BEARINGS BASED ON MAGNETIC NORTH
5. PROPERTY DOES NOT CONFORM TO MIN. LOT WIDTH
6. LOT REQUIREMENTS:
MIN. LOT AREA: 5,161.51 SQ. FT.
MIN. LOT WIDTH: 5'
MIN. HEIGHT OF ADJACENT PRINCIPLE RESIDENTIAL STRUCTURE WHICHEVER IS GREATER

The portion of Catherine St. shown on this plan is an established public street of the City of Hartford.

Date: 9/24/88
City Engineer: Hubert J. Herbert

I HEREBY DECLARE THAT THIS SURVEY CONTAINS ALL OF THE INFORMATION REQUIRED BY SUBSECTION 47-228 (b) OF THE COMMON INTEREST COMPENSITY ACT TO THE EXTENT THAT ANY SUCH INFORMATION IS NOT SHOWN ON THE ABOVE PLANS.

Manuel R. & Adelia C. Costa
8498

DECLARATION SCHEDULE A-3
JOB No. 1699

HALLISEY & HERBERT
CIVIL ENGINEERS & LAND SURVEYORS
78 BEAVER ROAD, WETHERSFIELD, CONNECTICUT

RECEIVED BY
TOWN & CITY CLERK
HARTFORD
APR 21 11 52 AM '89

1845
EASI FILE CORP. IRVINE, CA
EPM 34

1845
95-
10/97